

NOTES:

1. DRAWINGS ARE APPROXIMATE. CONTRACTOR RESPONSIBLE FOR FIELD VERIFYING EXACT EQUIPMENT, QUANTITIES, AND CONDITIONS PRIOR TO BIDDING.

LEGEND

NCU NETWORK CONTROL UNIT (ARCNET / N2 BUS)
DCM DIGITAL CONTROL MODULE
DX9100 PROGRAMMABLE CONTROLLERS (N2 BUS)
UNT UNITARY CONTROLLERS (N2 BUS)
NAE NETWORK AUTOMATION ENGINE (ETHERNET / LAN / N2 BUS)
NCE NETWORK CONTROL ENGINE (ETHERNET / LAN / N2 BUS)
OWS OPERATOR WORK STATION
AI ANALOG INPUT
AO ANALOG OUTPUT
DI DIGITAL INPUT
DO DIGITAL OUTPUT
NIM NETWORK INTERFACE MODULE

GENERAL NOTE:

1. Contractor shall field verify all dimensions.
2. Schedule on site inspections with the project COTR.
3. Contractor shall comply with OSHA, EPA, NFPA and all other applicable safety codes and regulations at all times.
4. All work shall be performed by craftsmen who are journeymen of the trade in which they are performing work.

5. Contractor superintendent shall report to the COTR each morning before work begins, at which the daily schedule shall be discussed.
6. Contractor shall maintain dust control at all times. Contractor shall use "sticky mats" outside each work area and shall erect barriers to minimize dust/dirt, spreading/tracking to the greatest extent possible.
7. Contractor to maintain the job site in a neat and orderly fashion at all times. Corridors shall be kept clean of all debris and obstructions to allow safe passage for employees, patients, visitors and workers. Dispose of all trash and discarded materials and maintain storage within the confines of the job site or other approved areas.
8. All damages incurred to adjacent areas shall be repaired and returned to original condition by the contractor at no additional cost to the government.

9. All materials removed shall become property of the contractor, to be disposed off site unless scheduled to be reinstalled or turned over to the VA.
10. Contractor superintendent shall carry a pager and/or install a job site telephone. Furnish numbers to the project COTR upon contract award.

11. Contractor shall schedule all utility interruptions with the project COTR at least forty-eight (48) hours in advance. Utility interruptions may require overtime work for all trades involved, and shall be provided by the contractor at no additional cost to the government.
12. "Hot Work" permits are required. Notify the COTR twenty-four (24) hours prior to commencement of work.

13. Manufacturers' trade names and numbers used herein identify a minimum standard. Subject to approval of the Contracting Officer, other products shall be considered, provided they are equivalent to these standards and meet the requirements of the technical specifications and drawings.

Revisions	Date

Seal:

024538
6-6-08
R. McDOWELL
ENGINEER

RM
ENGINEERS

Reece, Noland & McElrath, Inc.
409 North Haywood Street / PO Box 540
Waynesville, North Carolina 28786

WAYNESVILLE 828-454-8801 FAX 828-454-4000
MAIL@RMENGINEERS.COM © 2008 ARRYVILLE 828-533-0380
WWW.RMENGINEERS.COM

batson
architects

Greenville Commons 220 N. Main Street, Suite 403 Greenville, South Carolina 29601 864.233.2232

POWER PLANT

QUAD 'D' QUAD 'A'

QUAD 'C' QUAD 'B'

PROJECT NORTH

KEY PLAN

BUILDING IS FULLY SPRINKLERED

BID DOCUMENTS		ARCHITECT PROJECT NO. 2007-30	
Drawing Title EXISTING CAMPUS HVAC CONTROLS BLOCK DIAGRAMS / ARCHITECTURE		Project Title VA MEDICAL CENTER REPLACE HVAC CONTROLS	
Approved By:		Date 03-13-08	
Note: Asbestos Containing Building Materials (ACBM) are present. Thermal Systems Insulation (TSI) and Miscellaneous ACBM are present in various locations.		Project No. 637-08-103	
Location ASHEVILLE, N.C.		Drawing No. M001	
		Dwg. 2 of 29	

CONFIDENTIAL: THESE DRAWINGS MUST BE RETURNED TO FACILITY MANAGEMENT SERVICE, PROJECT SECTION, UPON COMPLETION, OR UPON FINAL USE BY THE CONTRACTOR FOR BIDDING PURPOSES.

Office of Facilities

Department of Veterans Affairs

A

B

C

D

E

F

A



B

C

D

E

F

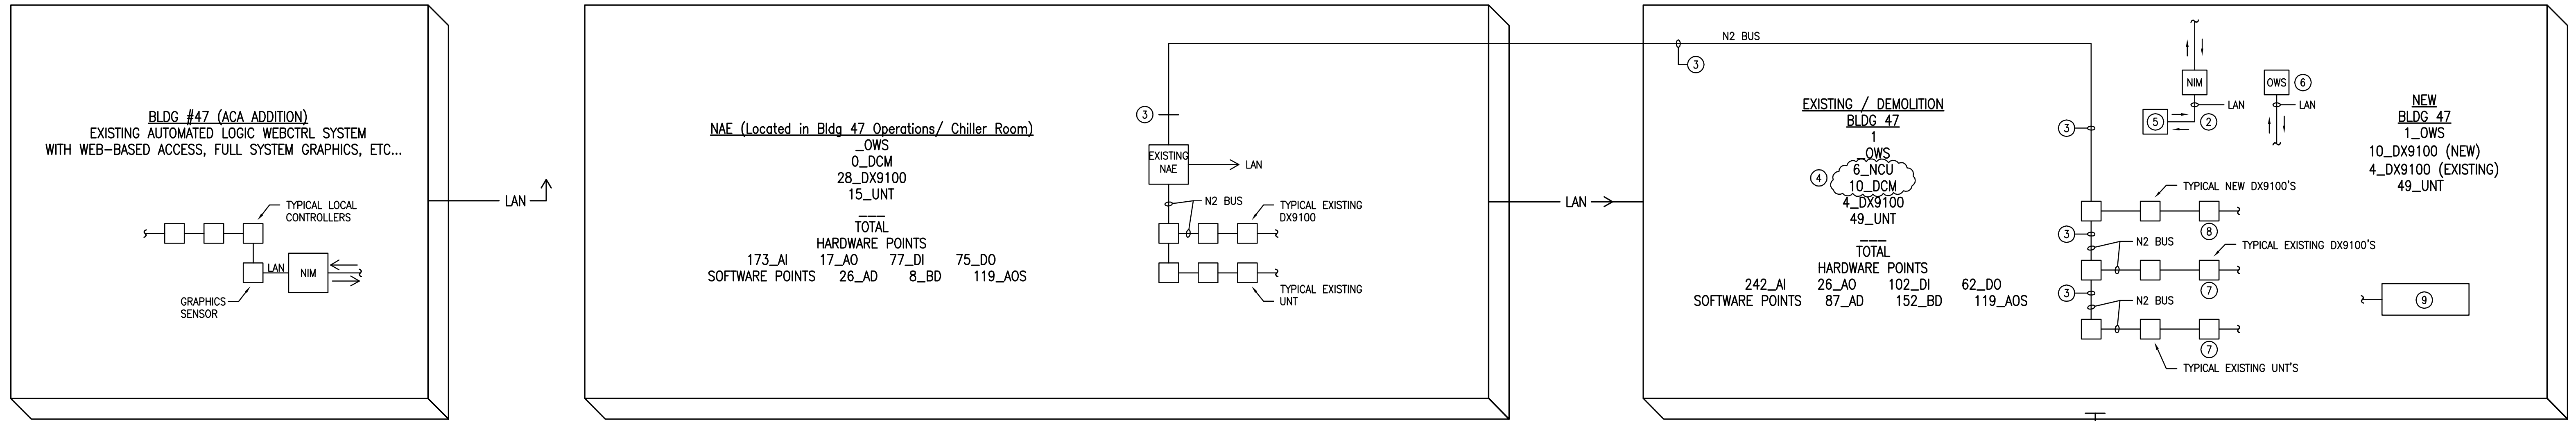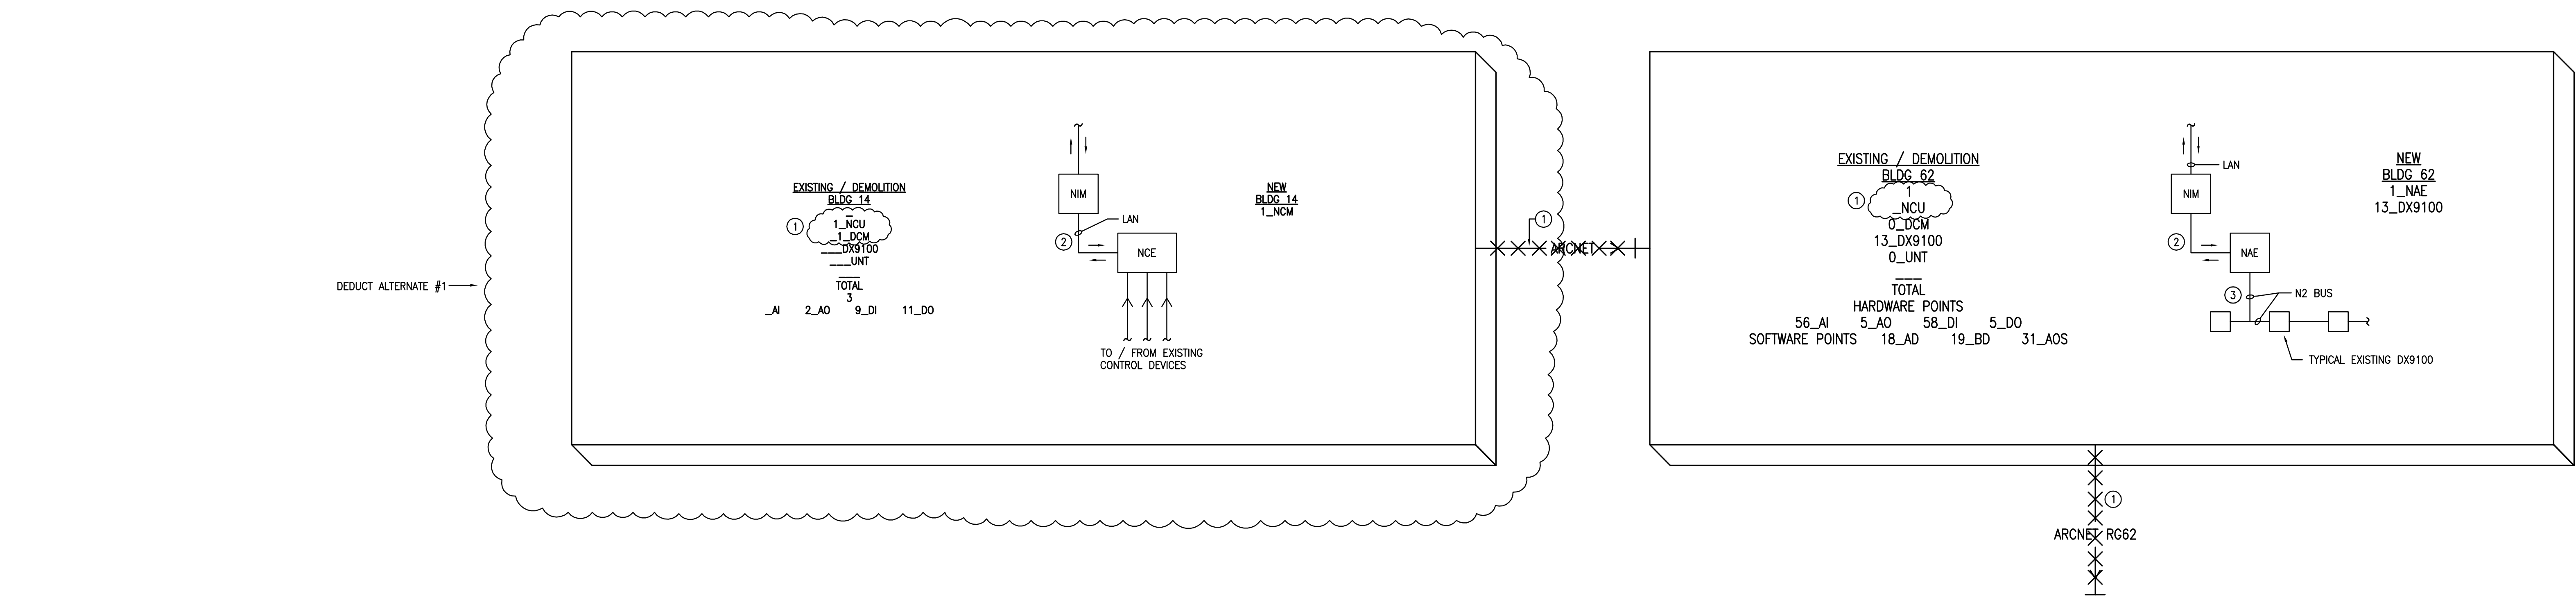

KEYED DEMOLITION / INSTALLATION NOTES

- REMOVE EXISTING NCU / DCM AND INSTALL NEW NCE OR NAE (AS SHOWN). RE-TERMINATE CONTROL WIRING / PULL NEW AS REQUIRED FROM EXISTING DEVICES. PROVIDE REPROGRAMMING AS REQUIRED TO MATCH EXISTING. TERMINATE EXISTING ARCNET COMMUNICATIONS. TIE NEW NCE TO LAN / CAMPUS NETWORK. BUILD USER INTERFACE (GRAPHICS, DATA, DISPLAYS, ETC.) AS REQUIRED FOR BUILDING COMPONENTS AT APPLICATION DATA SERVER.
- LAN CONNECTION FURNISHED BY OWNER. CONTRACTOR TO EXTEND FROM OWNERS CONNECTION TO CONTROLLERS. FURNISH NETWORK INTERFACE MODULE(S) AS REQUIRED.
- EXTEND EXISTING N2 BUS AS REQUIRED.
- REMOVE EXISTING NCU / DCM'S AND INSTALL NEW DX9100'S (APPROX. 10 - FIELD VERIFY QTY.). RE-TERMINATE CONTROL WIRING / PULL NEW AS REQUIRED FROM EXISTING AND NEW DEVICES AS REQUIRED. PROVIDE RE-PROGRAMMING AS REQUIRED TO MATCH NEW OR EXISTING (AS APPLICABLE). TERMINATE EXISTING ARCNET COMMUNICATIONS. TIE NEW DX9100'S TO EXISTING N2 BUS, AND N2 BUS TO NAE - EXTEND AS REQUIRED.
- NEW APPLICATION DATA SERVER - LOCATE IN SECURE LOCATION. COORDINATE EXACT LOCATION WITH OWNER. SERVER TO INCLUDE ALL DATA COLLECTION, MANAGEMENT, ACCESS, GRAPHICS, CAPABILITY, AND SHALL BE ACCESSIBLE BY OWNER OVER CAMPUS NETWORK.
- EXISTING OPERATOR WORKSTATION WITH LAN CONNECTION TO REMAIN.
- TYPICAL EXISTING UNIT OR DX9100 TO BE REPROGRAMMED AND/OR NEW WIRING PULLED OR EXISTING RE-TERMINATED WHERE NEW CONTROL DEVICES ARE INSTALLED OR EXISTING REPLACED - SEE DRAWINGS.
- TYPICAL NEW DX9100 TO BE UTILIZED TO PROVIDE PROGRAM CONTROL FOR ALL AHU'S AND OTHER EQUIPMENT (AS SHOWN ON DRAWINGS), WHERE CONTROL DEVICES ARE BEING REPLACED AND SYSTEMS RE-PROGRAMMED.
- TYPICAL AHU, AUX. CHILLERS, PUMPS, H/V UNITS, ETC. (AS SHOWN ON DWGS. FOR BLDG. 47)-WITH NEW CONTROL DEVICES, WIRING/CONDUIT, PROGRAMMING, ETC. AS REQUIRED PER DWGS..

NOTES:

- DRAWINGS ARE APPROXIMATE. CONTRACTOR RESPONSIBLE FOR FIELD VERIFYING EXACT EQUIPMENT, QUANTITIES, AND CONDITIONS PRIOR TO BIDDING.
- FULL INTEGRATION OF ALL EQUIPMENT TO INCLUDE GRAPHICS OF EQUIPMENT SHOWING APPLICABLE OUTPUTS, INPUTS, ALARMS, ETC.
- CONTROLS TO TIE INTO / UTILIZE EITHER EXISTING JOHNSON NAE OR ALC WEBCTRL HEAD-INS (ONLY). ALL PRODUCTS THAT ARE NOT JOHNSON OR ALC SHALL BE DEMONSTRATED TO OWNER AND ENGINEER TO PROVIDE FULL SYSTEM INTEGRATION AS SHOWN/ SPECIFIED INCLUDED WITH QUOTE.
- CONTRACTOR SHALL EITHER TIE TO/ UTILIZE EXISTING JOHNSON NAE OR AUTOMATED LOGIC WEBCTRL HEAD-INS FOR COMPLETE SYSTEMS INTEGRATION, CONTROL, GRAPHICS, AND INTERNET ACCESS (FOR MONITORING AND MODIFICATION OF INPUTS/ PROGRAMMING). VIA CAMPUS LAN. SCHEMATIC SHOWN GENERALLY REPRESENTS ARCHITECTURE/ REQUIREMENTS FOR INTERFACE/ INTEGRATION TO JOHNSON CONTROLS SYSTEM. ARCHITECTURE/ REQUIREMENTS FOR AUTOMATED LOGIC SYSTEM INTERFACE/ INTEGRATION ARE NOT FULLY SHOWN, BUT ARE SIMILAR. PROVIDE ALL REPLACEMENT OF CONTROL MODULES, REPROGRAMMING, ETC... AS REQUIRED.



LEGEND

NCU	NETWORK CONTROL UNIT (ARCNET / N2 BUS)
DCM	DIGITAL CONTROL MODULE
DX9100	PROGRAMMABLE CONTROLLERS (N2 BUS)
UNIT	UNITARY CONTROLLERS (N2 BUS)
NAE	NETWORK AUTOMATION ENGINE (ETHERNET / LAN / N2 BUS)
NCE	NETWORK CONTROL ENGINE (ETHERNET / LAN / N2 BUS)
OWS	OPERATOR WORK STATION
AI	ANALOG INPUT
AO	ANALOG OUTPUT
DI	DIGITAL INPUT
DO	DIGITAL OUTPUT
NIM	NETWORK INTERFACE MODULE



GENERAL NOTE:

- Contractor shall field verify all dimensions.
- Schedule on site inspections with the project COTR.
- Contractor shall comply with OSHA, EPA, NFPA and all other applicable safety codes and regulations at all times.
- All work shall be performed by craftsmen who are journeymen of the trade in which they are performing work.
- Contractor superintendent shall report to the COTR each morning before work begins, at which the daily schedule shall be discussed.
- Contractor shall maintain dust control at all times. Contractor shall use "tidy mat" outside each work area and shall erect barriers to minimize dust/dirt, spreading/tracking to the greatest extent possible.
- Contractor shall maintain the job site in a neat and orderly fashion at all times. Corridors shall be kept clean of all debris and obstructions to allow safe passage for employees, visitors and workers. Dispose of all trash and discarded materials and maintain storage within the confines of the job site or other approved areas.
- All damages incurred to adjacent areas shall be repaired and returned to original condition by the contractor at no additional cost to the government.
- All materials removed shall become property of the contractor, to be disposed off site unless scheduled to be reinstalled or turned over to the VA.
- Contractor superintendent shall carry a pager and/or install a job site telephone. Furnish numbers to the project COTR upon contract award.
- Contractor shall schedule all utility interruptions with the project COTR at least forty-eight (48) hours in advance. Utility interruptions may require overtime work for all trades involved, and shall be provided by the contractor at no additional cost to the government.
- "Hot Work" permits are required. Notify the COTR twenty-four (24) hours prior to commencement of work.
- Manufacturers' trade names and numbers used herein identify a minimum standard. Subject to approval of the Contracting Officer, other products may be considered, provided they are equivalent to these standards and meet the requirements of the technical specifications and drawings.


Revisions	Date

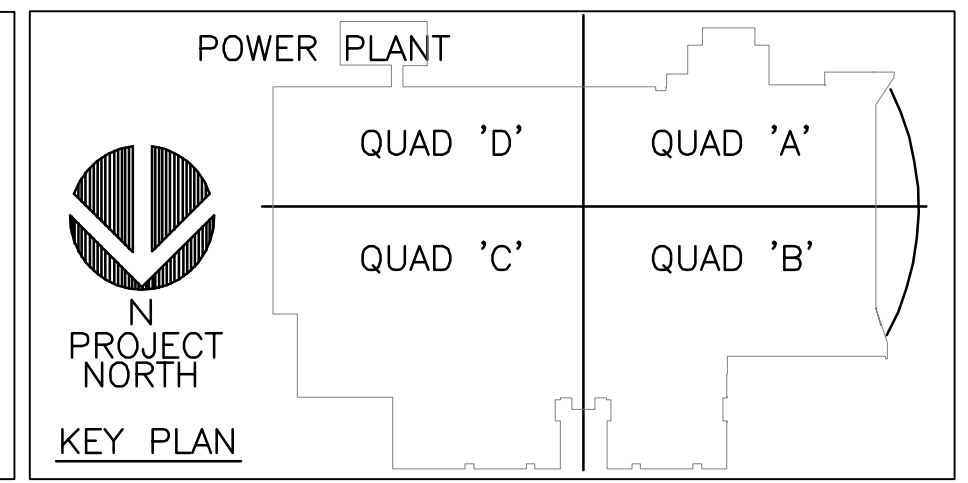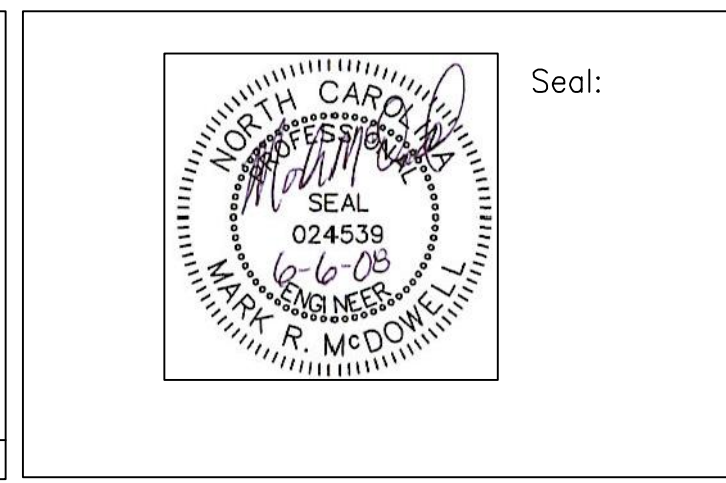


BUILDING IS FULLY SPRINKLERED	
BID DOCUMENTS	
ARCHITECT PROJECT NO. 2007-30	
Date 03-13-08	
Project No. 637-08-103	
DRAWING NO. M002	
Dwg. 3 of 29	
ASHEVILLE, N.C.	
Office of Facilities	
Department of Veterans Affairs	

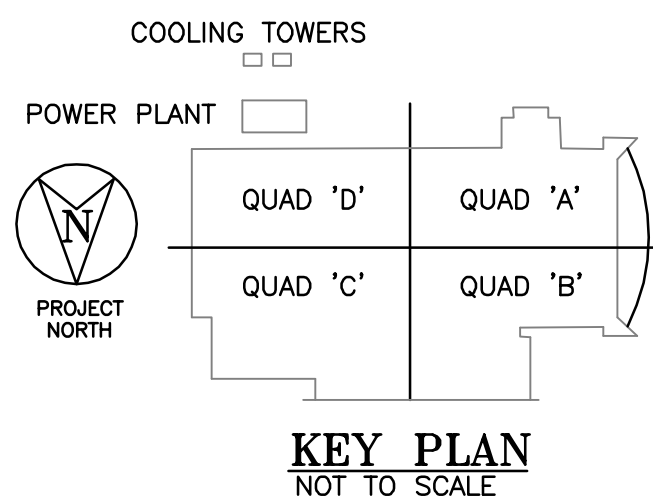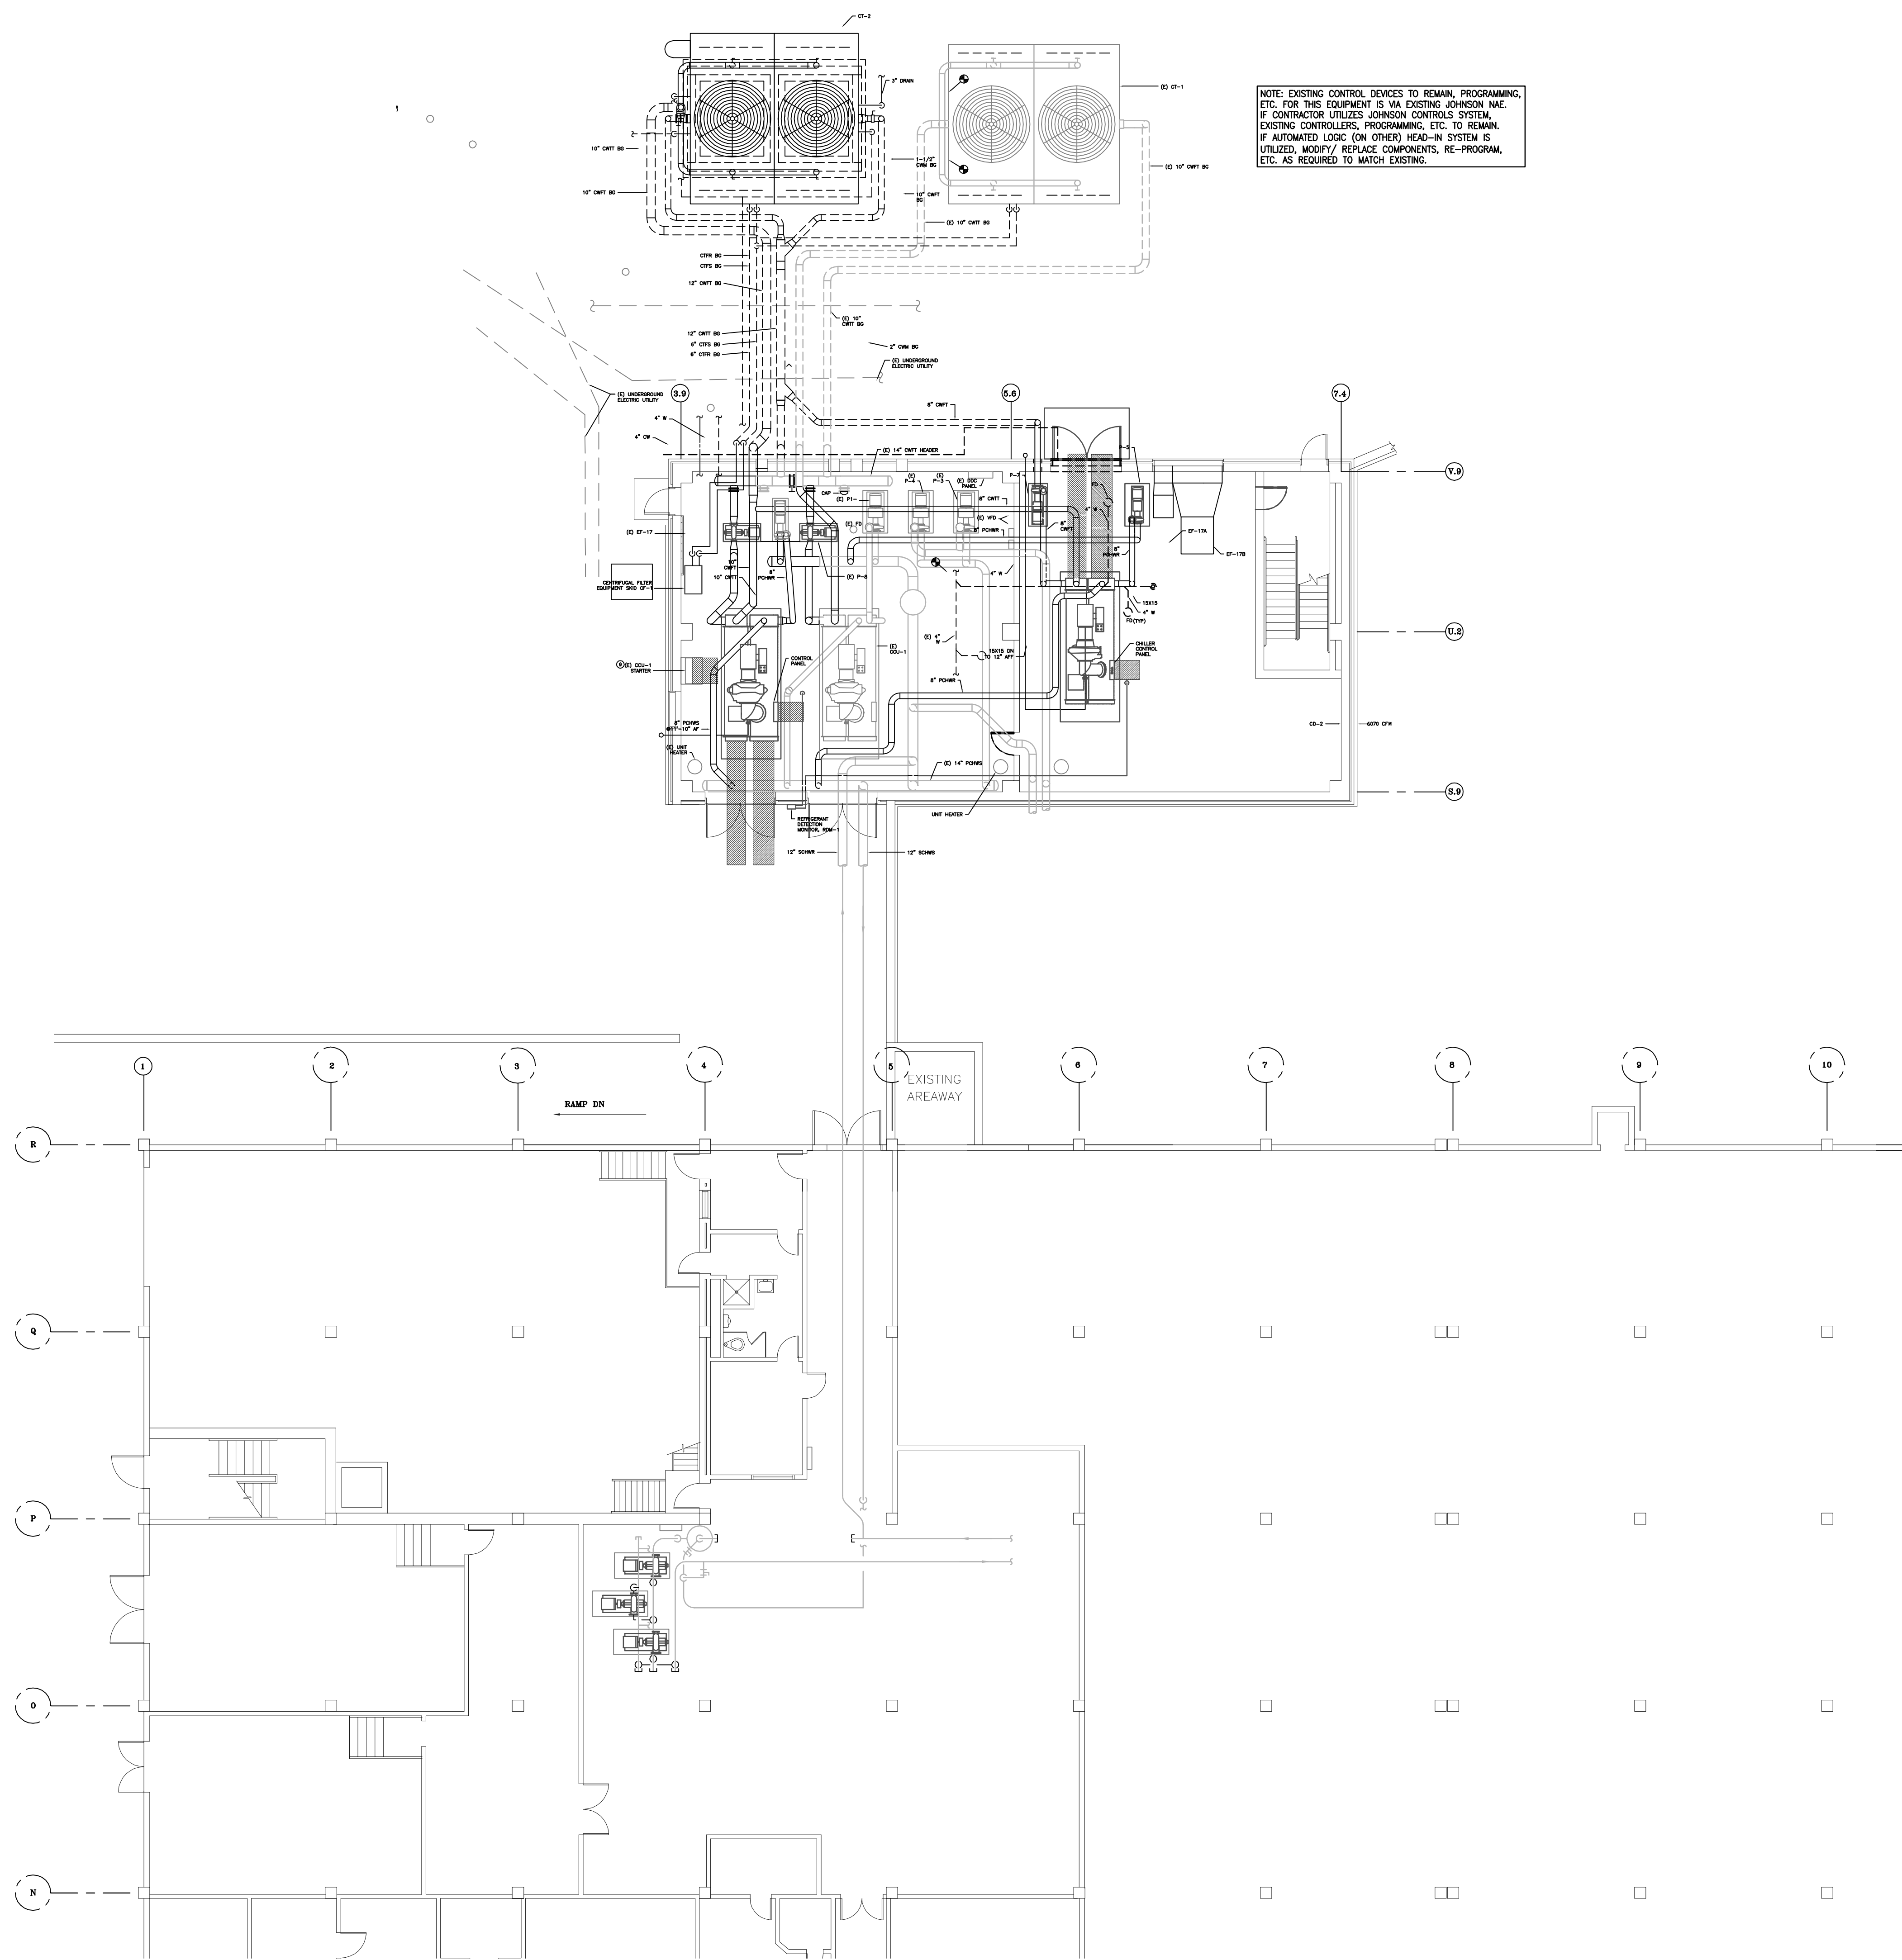


GENERAL NOTE: 1. Contractor shall field verify all dimensions. 2. Schedule on site inspections with the project COTR. 3. Contractor shall comply with OSHA, EPA, NFPA and all other applicable safety codes and regulations at all times. 4. All work shall be performed by craftsmen who are journeymen of the trade in which they are performing work. 5. Contractor superintendent shall report to the COTR each morning before work begins, at which the daily schedule shall be discussed. 6. Contractor shall maintain dust control at all times. Contractor shall use "sticky mats" outside each work area and shall erect barriers to minimize dust/dirt, spreading/tracking to the greatest extent possible. 7. Contractor to maintain the job site in a neat and orderly fashion at all times. Corridors shall be kept clean of all debris and obstructions to allow safe passage for employees, visitors, visitors and workers. Dispose of all trash and discarded materials and maintain storage within the confines of the job site or other approved areas. 8. All damages incurred to adjacent areas shall be repaired and restored to original condition by the contractor at no additional cost to the government. 9. All materials removed shall become property of the contractor, to be disposed off site unless scheduled to be reinstalled or turned over to the VA. 10. Contractor superintendent shall carry a pager and/or install a job site telephone. Furnish numbers to the project COTR upon contract award. 11. Contractor shall schedule all utility interruptions with the project COTR at least forty-eight (48) hours in advance. Utility interruptions may require overtime work for all trades involved, and shall be provided by the contractor at no additional cost to the government. 12. "Hot Work" permits are required. Notify the COTR twenty-four (24) hours prior to commencement of work. 13. Manufacturers' trade names and numbers used herein identify a minimum standard. Subject to approval of the Contracting Officer, other products shall be considered, provided they are equivalent to these standards and meet the requirements of the technical specifications and drawings.		BUILDING IS FULLY SPRINKLERED	
BID DOCUMENTS		ARCHITECT PROJECT NO. 2007-30	
Drawing Title CHILLER ROOM MECHANICAL PLAN BUILDING 47 - BASE BID		Date 03-13-08	
Approved By:		Project No. 637-08-103	
Note: Asbestos Containing Building Materials (ACBM) are present. Thermal Systems Insulation (TSI) and Miscellaneous ACBM are present in various locations.		Drawing No. M003	
Location ASHEVILLE, N.C.		Dwg. 4 of 29	
 Seal:			

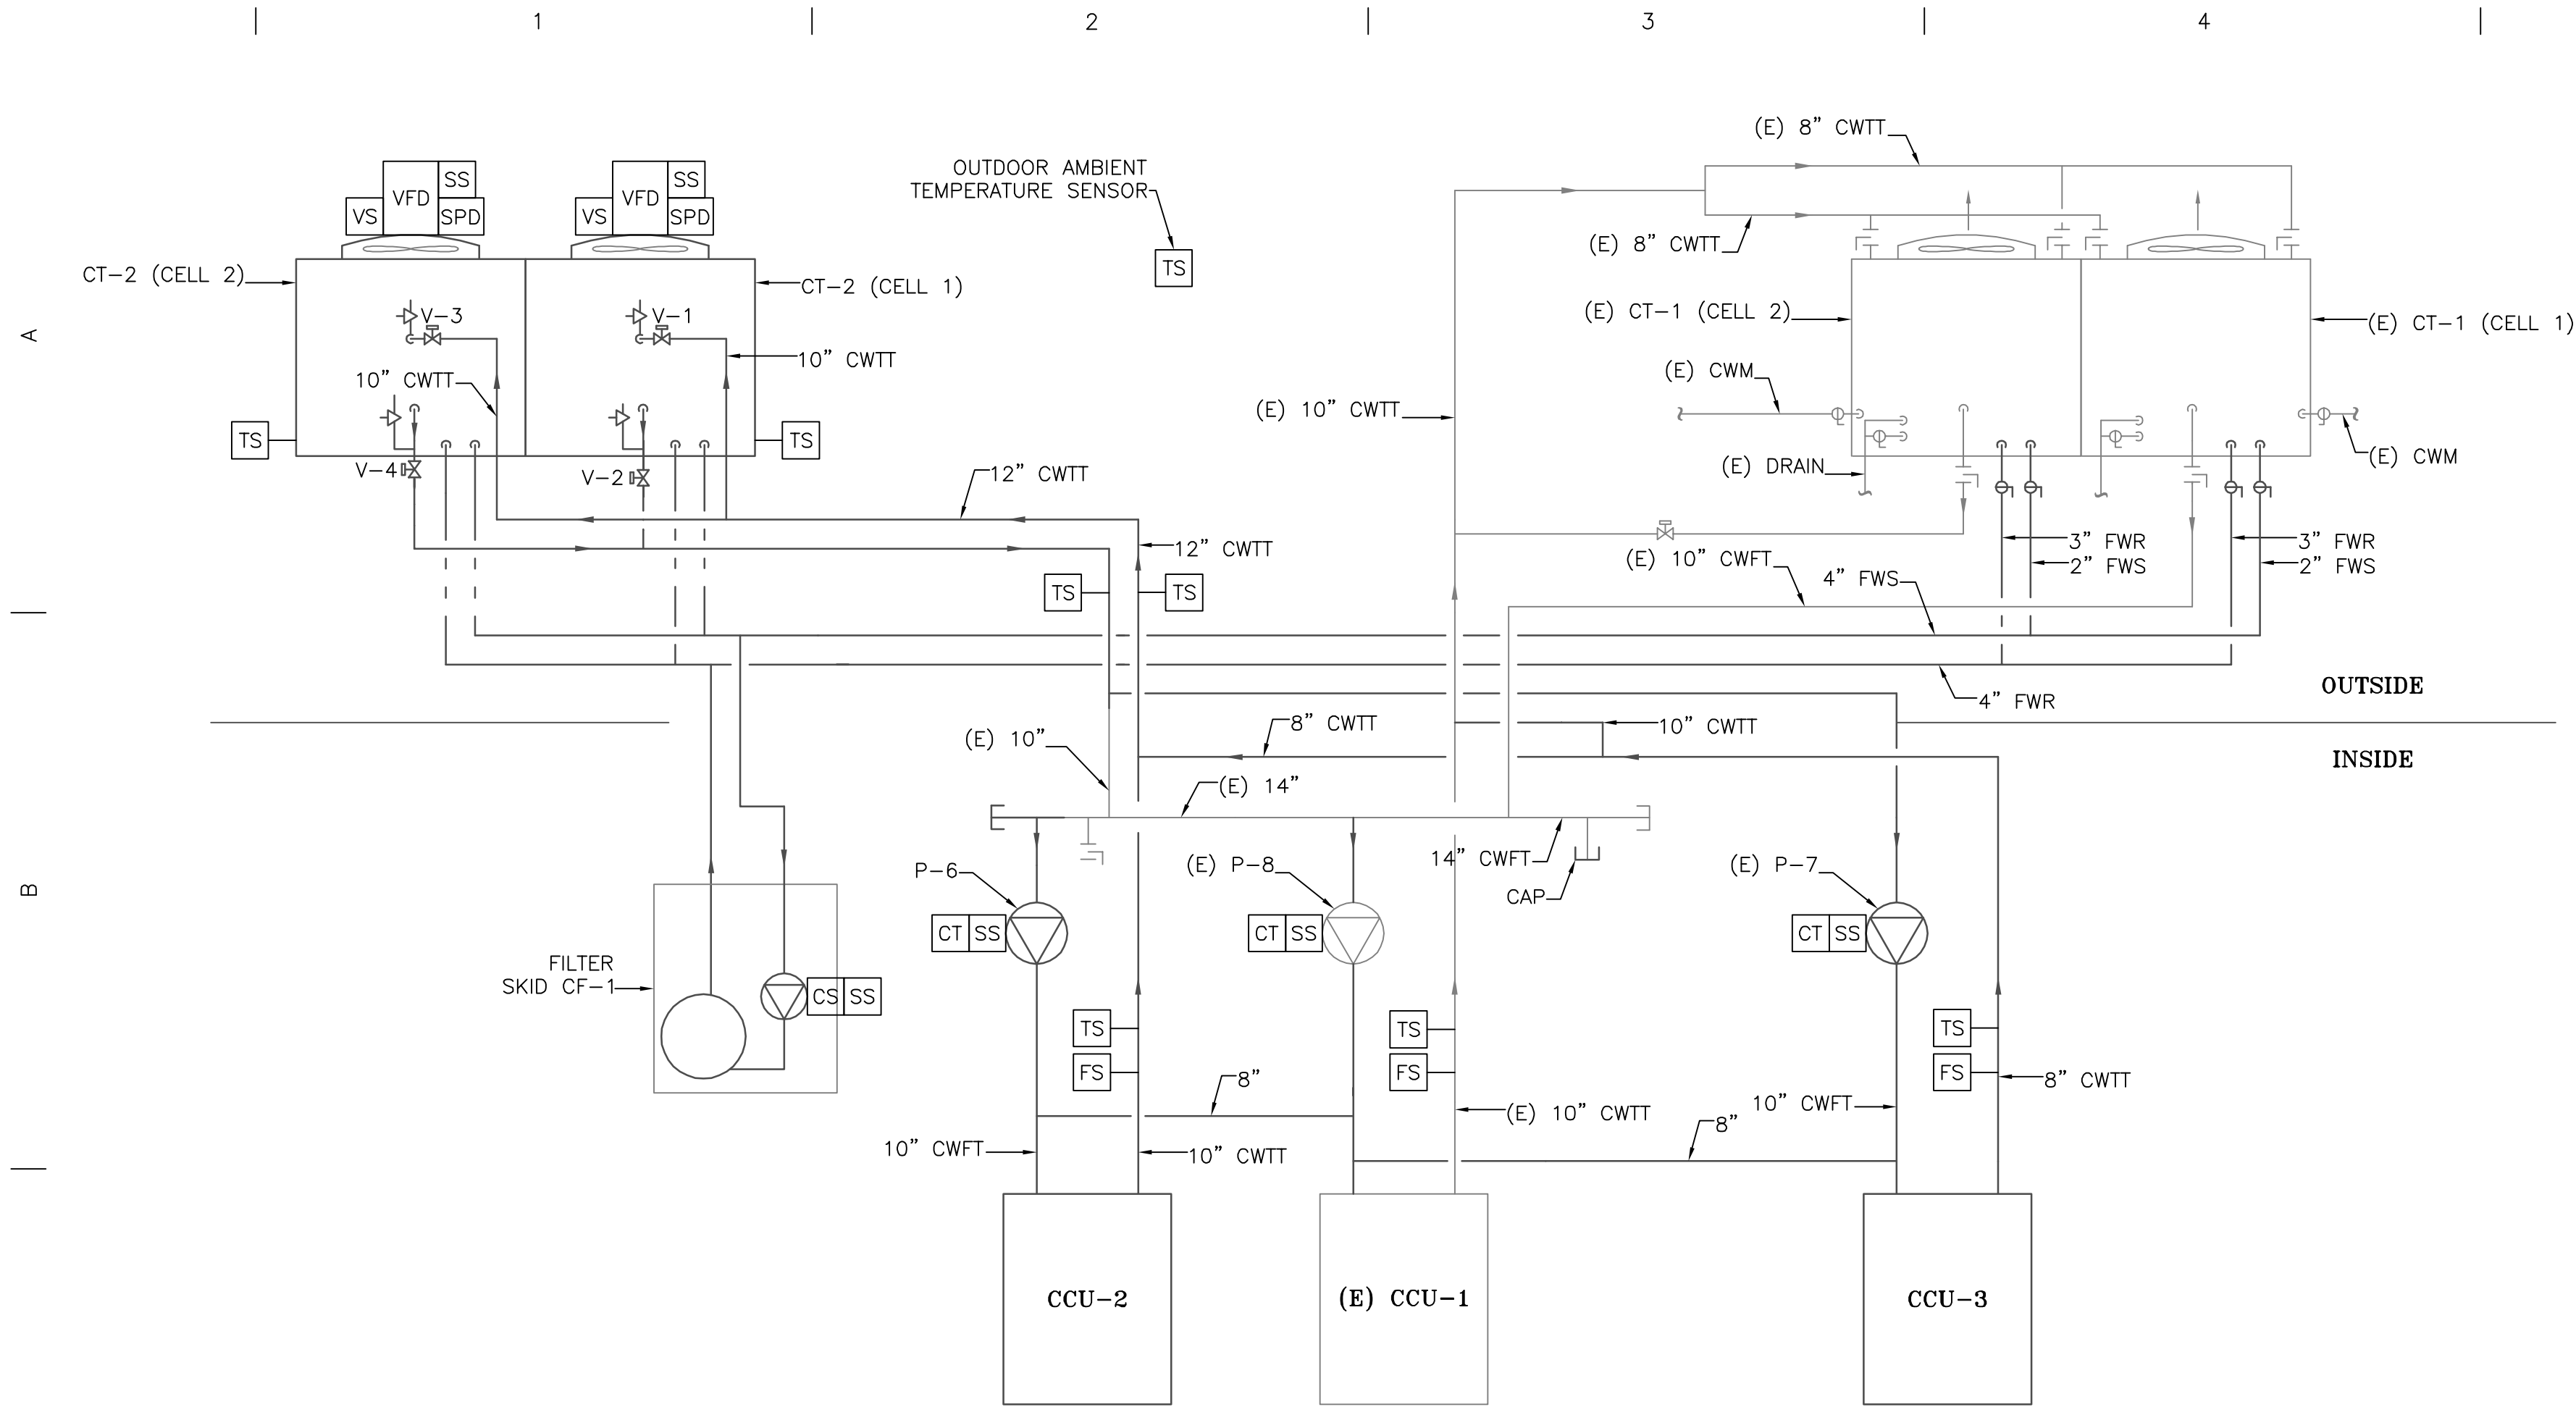

EXISTING CONDENSER WATER CONTROL SCHEMATIC (1)
NOT TO SCALE 47-M7

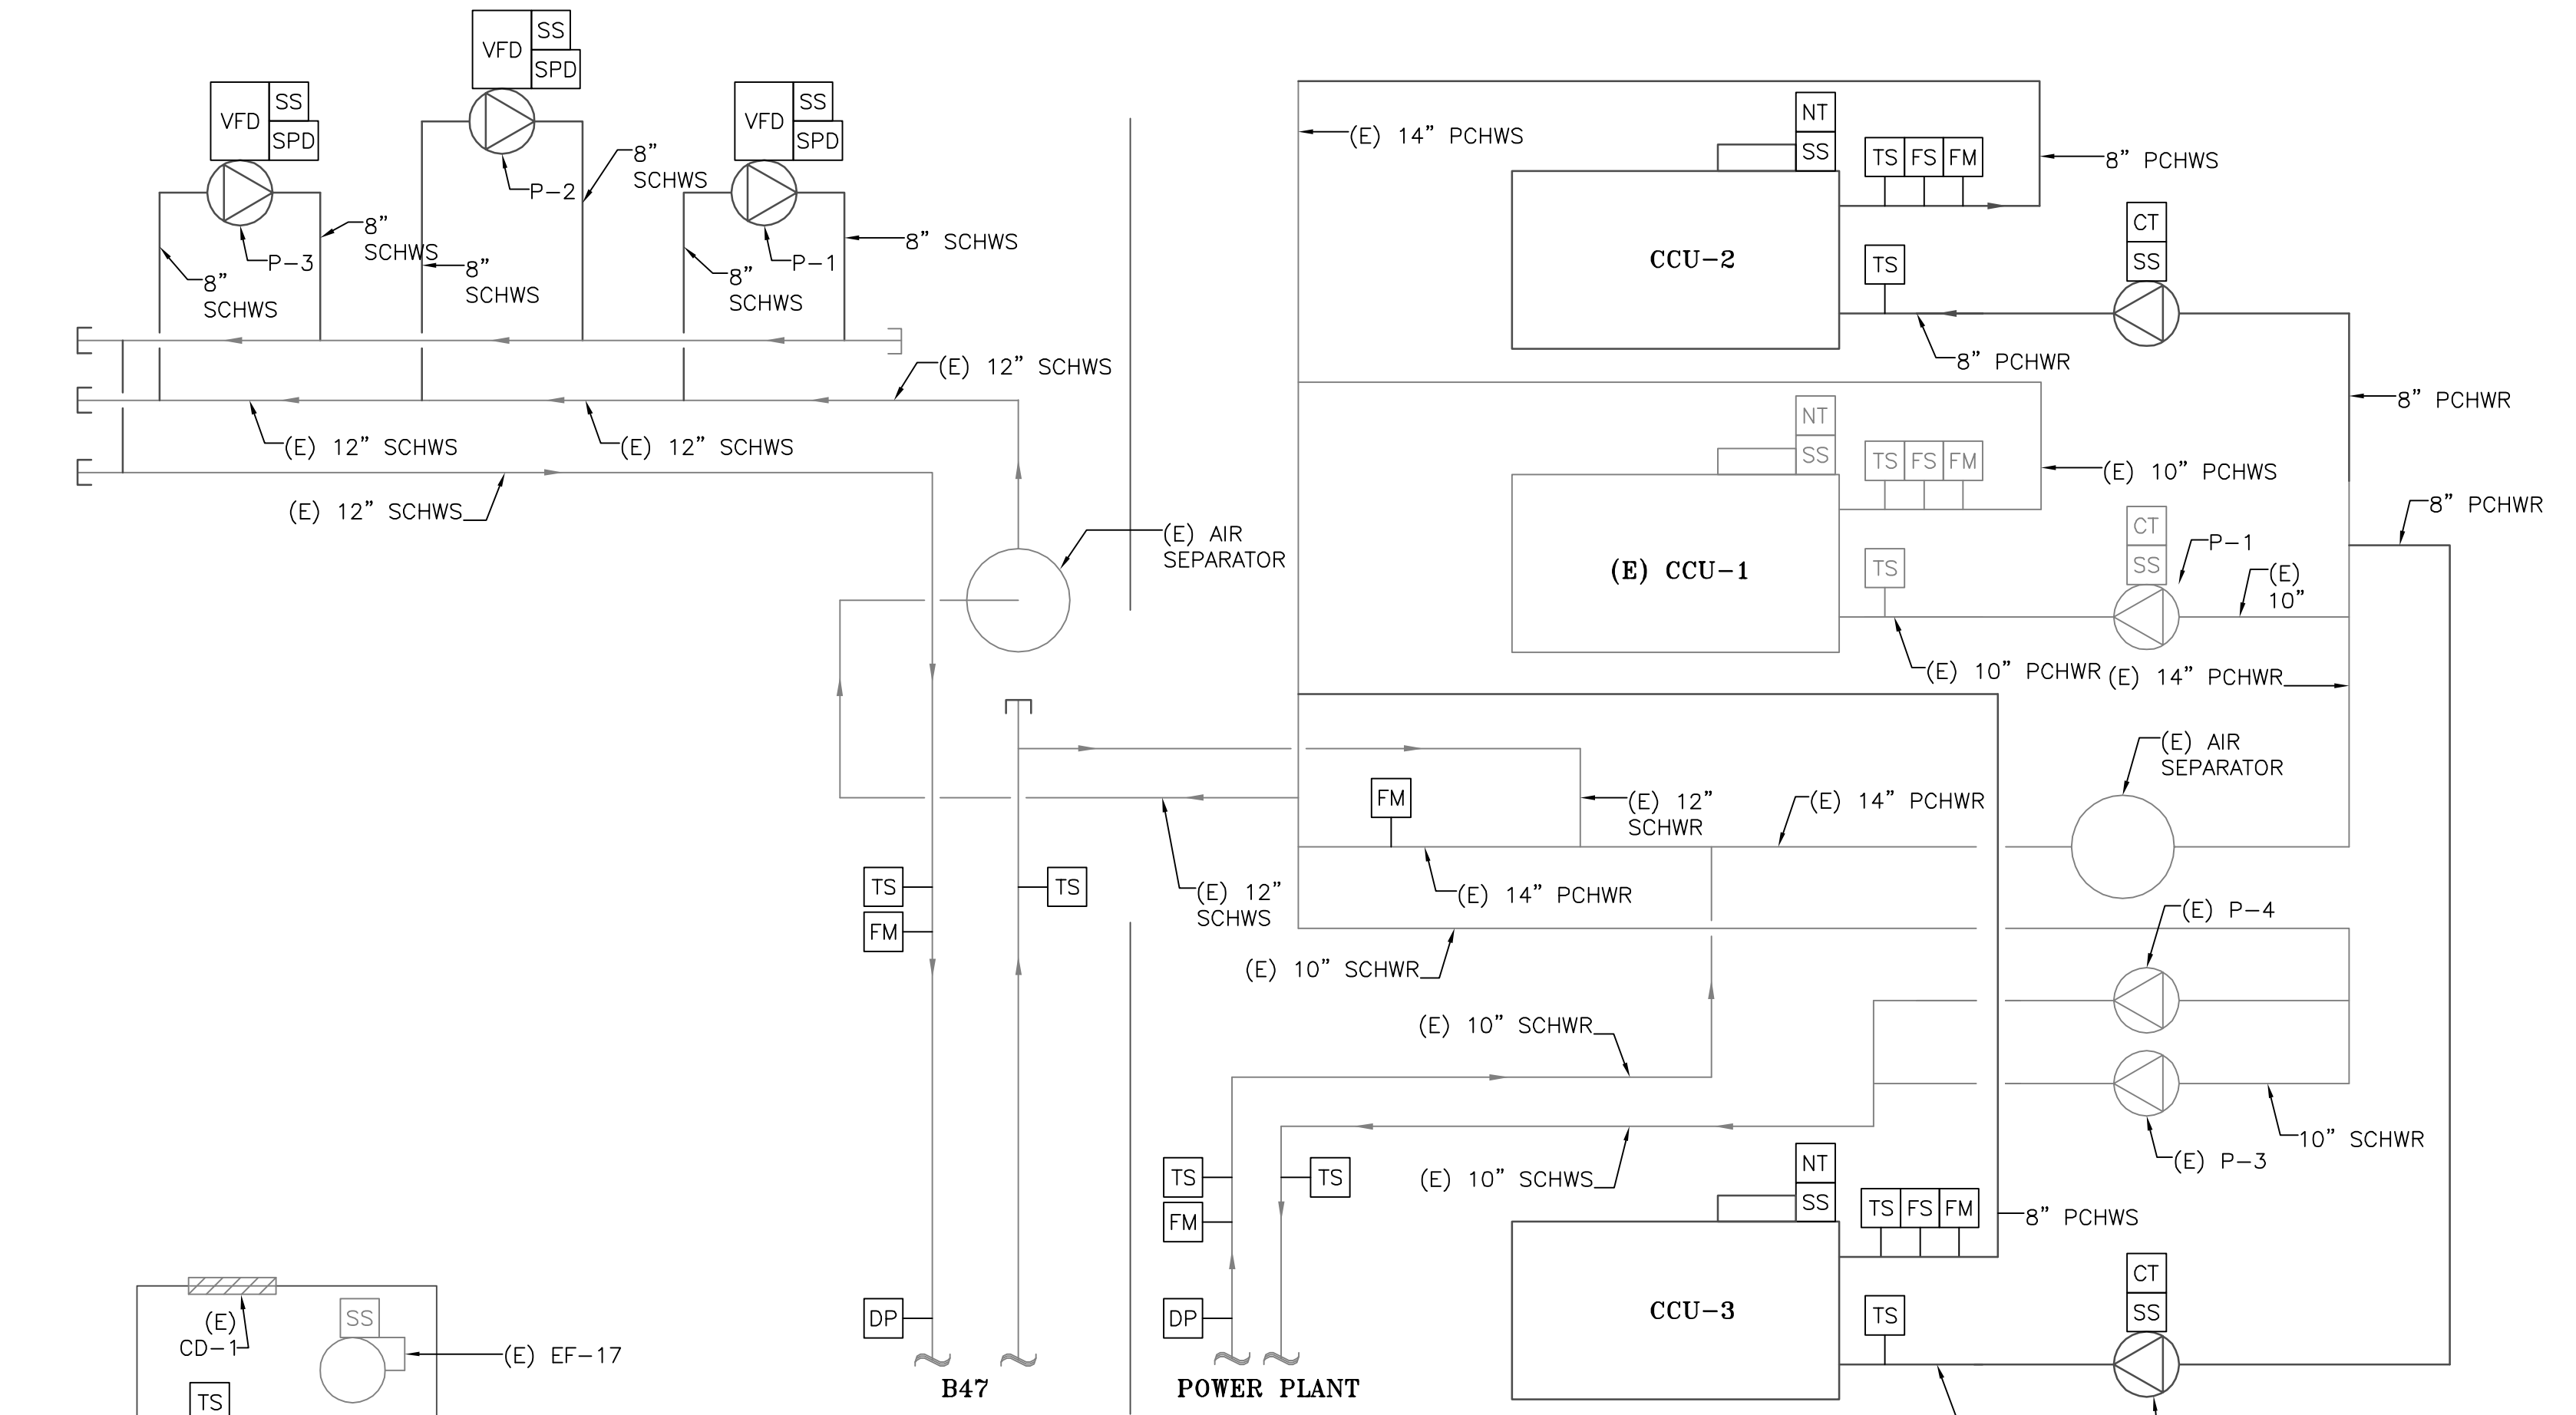

EXISTING CHILLED WATER CONTROL SCHEMATIC (2)
NOT TO SCALE 47-M7

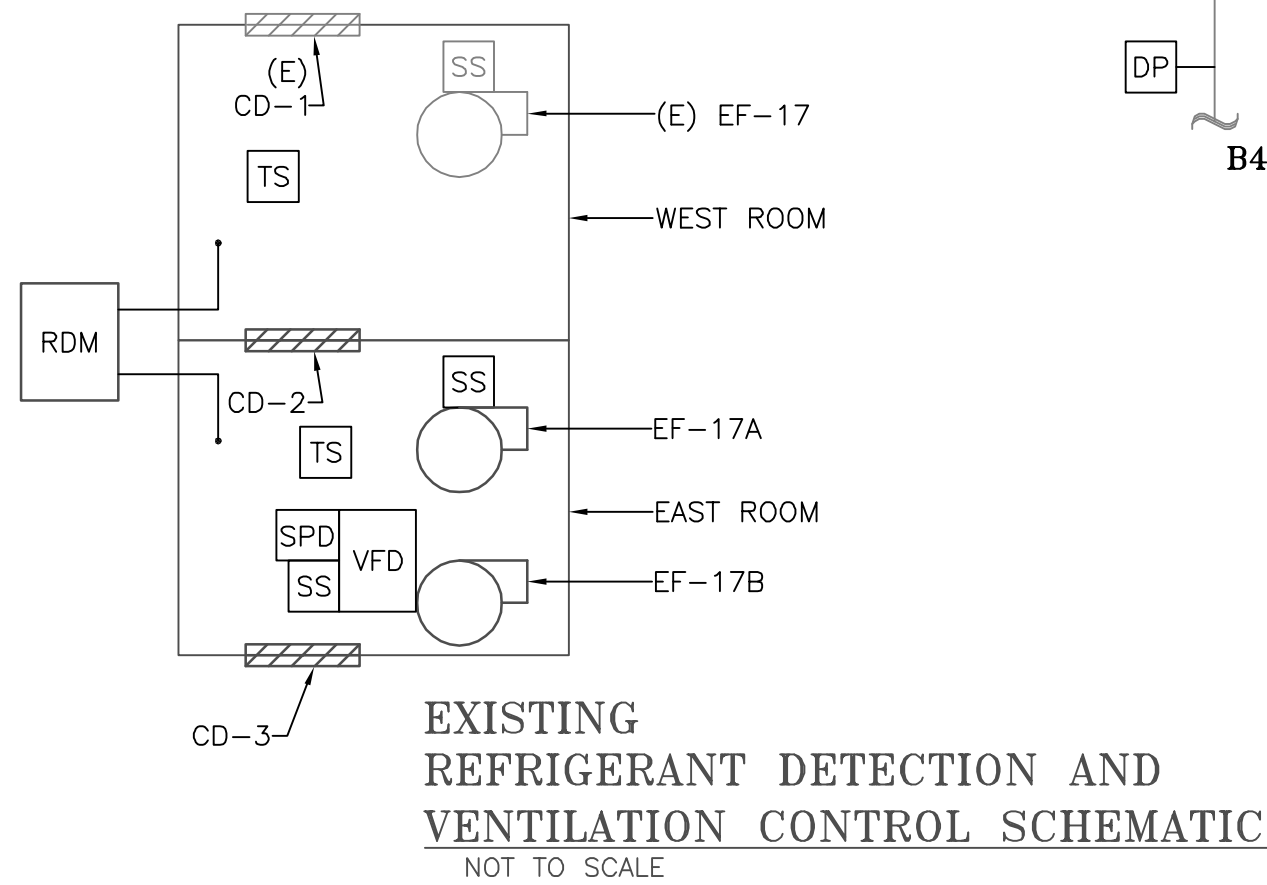

EXISTING REFRIGERANT DETECTION AND VENTILATION CONTROL SCHEMATIC
NOT TO SCALE 47-M7

GENERAL NOTE:

- Contractor shall field verify all dimensions.
- Schedule on site inspections with the project COTR.
- Contractor shall comply with OSHA, EPA, NFPA and all other applicable safety codes and regulations at all times.
- All work shall be performed by craftsmen who are journeymen of the trade in which they are performing work.
- Contractor superintendent shall report to the COTR each morning before work begins, at which the daily schedule shall be discussed.
- Contractor shall maintain dust control at all times. Contractor shall confine the dust to the work area and shall erect barriers to minimize dust/dirt, spreading/tracking to the greatest extent possible.
- All damages incurred to adjacent areas shall be repaired and restored to original condition by the contractor at no additional cost to the government.
- Contractor shall maintain the job site in a neat and orderly fashion at all times. Corridors shall be kept clean of all debris and obstructions to allow safe passage for employees, visitors, and workers. Dispose of all trash and discarded materials and maintain storage within the confines of the job site or other approved area.
- All materials removed shall become property of the contractor, to be disposed off site unless scheduled to be reinstated or turned over to the VA.
- Contractor superintendent shall carry a pager and/or install a job site telephone. Furnish numbers to the project COTR upon contract award.
- Contractor shall schedule all utility interruptions with the project COTR at least forty-eight (48) hours in advance. Utility interruptions may require overtime work for all trades involved, and shall be provided by the contractor at no additional cost to the government.
- "Hot Work" permits are required. Notify the COTR twenty-four (24) hours prior to commencement of work.
- Manufacturers' trade names and numbers used herein identify a minimum standard. Subject to approval of the Contracting Officer, other products may be substituted, provided they are equivalent to those specified and meet the requirements of the technical specifications and drawings.

GENERAL SHEET NOTES

- (E) EQUIPMENT IS SHOWN FOR REFERENCE ONLY.
- COORDINATE PIPING, INSTRUMENTATION, AND VALVE LOCATIONS WITH PIPING/MECHANICAL CONTRACTOR. SEE SHEET 47-M6 FOR INFORMATION.
- DIAGRAMS ARE SCHEMATIC IN NATURE AND INTENDED TO SHOW THE GENERAL LOCATION OF SENSORS, CONTROLLED DEVICES, ETC. SEE POINT MATRICES, SEQUENCE OF OPERATIONS, AND SPECIFICATIONS FOR ADDITIONAL REQUIREMENTS, SENSORS, AND DEVICES. PIPING IS SHOWN FOR REFERENCE ONLY. SEE PIPING DIAGRAMS AND PLANS.
- DEVICE AND NETWORK CABLING IS NOT SHOWN. PROVIDE ALL NECESSARY CONTROL WIRING AND CONDUIT AS NECESSARY FOR A COMPLETE AND OPERATIONAL SYSTEM. SEE ELECTRICAL SHEETS AND SPECIFICATIONS FOR INFORMATION.

SEQUENCES OF OPERATION

CONTROLS

THE CHILLERS SHALL BE FURNISHED WITH A FACTORY INSTALLED AND TESTED MICROPROCESSOR-BASED CONTROL PANEL. THE PANEL SHALL INCLUDE ALL CONTROLS AND SEQUENCES AS NECESSARY FOR THE SAFE AND RELIABLE STAND-ALONE OPERATION OF THE CHILLER. THE CHILLER CONTROL PANEL SHALL INCORPORATE A FULLY-FUNCTIONAL INTERFACE WHICH SHALL MAKE ALL INTERNAL CHILLERS POINTS AVAILABLE TO THE FRONT-END.

ALL DEVICES SHOWN WITH AN NT SYMBOL SHALL BE EQUIPPED WITH A GATEWAY TO THE MANUFACTURER'S STANDARD SYSTEM BUS. THIS GATEWAY SHALL MAKE AVAILABLE TO THE DDC SYSTEM AND FRONT-END ALL MONITORED VALUES, SETPOINTS, AND SYSTEM INFORMATION.

GENERAL CONTROLS NOTES

THERE IS AN EXISTING ALC DDC SYSTEM SERVING THE (E) POWER PLANT INCLUDING THE (E) CHILLER CCU-1, COOLING TOWER CT-1, AND THEIR ASSOCIATED PUMPS. ALL POINTS FROM THE (E) ALC CHILLED WATER SYSTEM CONTROLS SHALL BE INTEGRATED WITH THE NEW CHILLED WATER SYSTEM CONTROLS TO FORM A COMPLETE AND INTEGRATED SYSTEM. SEE SPECIFICATION SECTION 15920 FOR MORE INFORMATION.

CHILLER SEQUENCING

THE CHILLER SHALL BE ENABLED THROUGH EITHER A PROGRAM FUNCTION (I.E. TIME OF DAY) OR MANUALLY BY AN OPERATOR. THE CHILLER SHALL BE STARTED IN THE FOLLOWING MANNER:

START DESIGNATED PRIMARY CHILLED WATER PUMP
WHEN PUMP OPERATION AND FLOW STATUS IS CONFIRMED, START THE CHILLER. ONCE STARTED, THE CHILLER SHALL OPERATE THROUGH ITS OWN OPERATING AND SAFETY CONTROLS.

UPON SHUTDOWN OF THE CHILLER, EITHER THROUGH AN ALARM (LOW FLOW, LOW TEMPERATURE, ETC.) OR A CAPACITY REDUCTION, THE CHILLER AND ASSOCIATED PUMPS SHALL GO THROUGH THE FOLLOWING SHUTDOWN SEQUENCE:

STOP CHILLER OPERATION
AFTER A USER ADJUSTABLE TIME DELAY (> 5 MINUTES) STOP THE PRIMARY CHILLED WATER PUMP AND THEN THE DESIGNATED CONDENSER WATER PUMP.

TWO (2) FIELD INSTALLED FLOW SWITCHES IN THE CHILLED WATER SUPPLY LINE IN SERIES SHALL LOCK OUT THE CHILLER UNTIL FLOW IS PROVEN AND CHILLED WATER RETURN. SAMPLES ARE TO BE TAKEN EVERY MINUTE AND AVERAGED FOR THE TREND LOG TO DISPLAY IN 30 MINUTE UNITS. THIS TREND LOG SHALL BE AVAILABLE ON DEMAND. MONITOR THE ALARM CONTACTS ON THE CHILLER AND REPORT ANY ALARM TO THE LAN. THE CHILLER SHALL NOT RESTART AUTOMATICALLY AFTER A POWER FAILURE.

MONITOR THE CHILLED WATER SUPPLY AND RETURN TEMPERATURES, KILOWATT USAGE (CHILLER AND CHILLED WATER PUMP), AND THE CHILLER ALARM CIRCUIT. PROVIDE A TREND LOG OF OUTDOOR AIR, CHILLED WATER SUPPLY, AND CHILLED WATER RETURN. SAMPLES ARE TO BE TAKEN EVERY MINUTE AND AVERAGED FOR THE TREND LOG TO DISPLAY IN 30 MINUTE UNITS. THIS TREND LOG SHALL BE AVAILABLE ON DEMAND. MONITOR THE ALARM CONTACTS ON THE CHILLER AND REPORT ANY ALARM TO THE LAN. THE CHILLER SHALL NOT RESTART AUTOMATICALLY AFTER A POWER FAILURE.

COOLING TOWERS SEQUENCE OF OPERATION

UPON ACTIVATION OF THE CALL FOR A CHILLER, THE ASSOCIATED CONDENSER WATER PUMP SHALL START, THE FIRST COOLING TOWER CELL SHALL BE ENERGIZED AND BOTH COOLING TOWER CELL ISOLATION VALVES SHALL OPEN. UPON A RISE IN LEAVING CONDENSER WATER TEMPERATURE TO 75° F BOTH FANS OF THE ASSOCIATED COOLING TOWER CELL SHALL START. BOTH COOLING TOWER FANS SHALL BE MODULATED IN PARALLEL TO MAINTAIN A CONSTANT LEAVING WATER TEMPERATURE OF 75° F. ALL TEMPERATURE CONTROLLERS SHALL HAVE VARIABLE SETPOINTS.

IF THE CONDENSER WATER PUMP FAILS AN ALARM SHALL BE ENERGIZED.

THE LEAD COOLING TOWER CELLS SHALL BE ALTERNATED ON A WEEKLY BASIS.

COOLING TOWER BASIN MAKEUP SHALL BE OPERATED BY A MANUFACTURER SUPPLIED BASIN FLOAT VALVE.

ON A DROP IN TOWER BASIN WATER TEMPERATURE TO 40° F AN ALARM SHALL BE ENERGIZED, CT BASIN HEATERS SHALL BE ENERGIZED, AND CONDENSER WATER PIPE HEAT TRACING SHALL BE ENERGIZED.

PIPING SYSTEM HEAT TRACING
UPON A DROP IN PIPE TEMPERATURE TO 40° DEG F, THE PIPE HEAT TRACING SHALL BE ENERGIZED.

REFRIGERANT MONITOR SEQUENCE OF OPERATION
REFRIGERANT MONITOR RDM-1 SHALL CONTINUOUSLY SAMPLE BOTH ZONES (EAST ROOM AND WEST ROOM). UPON DETECTION OF REFRIGERANT IN THE EAST ROOM, DAMPER CD-1 SHALL STROKE FULL OPEN, DAMPER CD-2 SHALL STROKE FULL CLOSED, (E) EXHAUST FAN EF-17 SHALL BE ENERGIZED, AND AN ALARM SHALL BE SENT TO THE BUILDING CONTROL SYSTEM. UPON DETECTION OF REFRIGERANT IN THE WEST ROOM, DAMPER CD-2 SHALL STROKE FULL CLOSED, DAMPER CD-3 SHALL STROKE FULL OPEN, EXHAUST FAN EF-17B SHALL BE DE-ENERGIZED, EXHAUST FAN EF-17A SHALL BE ENERGIZED, AND AN ALARM SHALL BE SENT TO THE BUILDING CONTROL SYSTEM.

VENTILATION FAN SEQUENCE OF OPERATION
EXHAUST FAN EF-17B SERVES THE VENTILATION REQUIREMENT FOR BOTH THE EAST AND WEST ROOMS IN THE POWER PLANT. THERMOSTATS T-1 (EAST ROOM) AND T-2 (WEST ROOM) SHALL BE MONITORED. UPON A RISE IN TEMPERATURE IN EITHER SPACE TO 94° DEG F, EXHAUST FAN EF-17B SHALL BE ENERGIZED, AND DAMPERS CD-1, CD-2, AND CD-3 SHALL OPEN. VFD SHALL MODULATE FAN SPEED AS NECESSARY TO MAINTAIN SETPOINT.

NOTE: EXISTING CONTROL DEVICES TO REMAIN, PROGRAMMING, ETC. FOR THIS EQUIPMENT IS VIA EXISTING JOHNSON NAE. IF CONTRACTOR UTILIZES JOHNSON CONTROLS SYSTEM, EXISTING CONTROLLERS, PROGRAMMING, ETC. TO REMAIN. IF AUTOMATED LOGIC (ON OTHER) HEAD-IN SYSTEM IS UTILIZED, MODIFY/ REPLACE COMPONENTS, RE-PROGRAM, ETC. AS REQUIRED TO MATCH EXISTING.

POINT MATRICES

MATRICES AND/OR POINTS SHOWN IN THIN ARE EXISTING TO REMAIN. VERIFY ALL (E) POINTS, DEVICES, AND SENSORS, AND PROVIDE AS NECESSARY.

(E) P-1		
SYSTEM	(E) PRIMARY CHILLED WATER PUMP CCU-1	
DESCRIPTION	TYPE	DEVICE
PUMP START/STOP	DO	HARD-WIRED
PUMP STATUS	AI	HARD-WIRED CURRENT TRANSDUCER
P-2		
SYSTEM	PRIMARY CHILLED WATER PUMP CCU-2	
DESCRIPTION	TYPE	DEVICE
PUMP START/STOP	DO	HARD-WIRED
PUMP STATUS	AI	HARD-WIRED CURRENT TRANSDUCER
P-5		
SYSTEM	PRIMARY CHILLED WATER PUMP CCU-3	
DESCRIPTION	TYPE	DEVICE
PUMP START/STOP	DO	HARD-WIRED
PUMP STATUS	AI	HARD-WIRED CURRENT TRANSDUCER
P-6		
SYSTEM	CONDENSER WATER PUMP CCU-2	
DESCRIPTION	TYPE	DEVICE
PUMP START/STOP	DO	HARD-WIRED
PUMP STATUS	AI	HARD-WIRED CURRENT TRANSDUCER
P-7		
SYSTEM	CONDENSER WATER PUMP CCU-2	
DESCRIPTION	TYPE	DEVICE
PUMP START/STOP	DO	HARD-WIRED
PUMP STATUS	AI	HARD-WIRED CURRENT TRANSDUCER
P-1		
SYSTEM	SCHW PUMP (B47)	
DESCRIPTION	TYPE	DEVICE
PUMP START/STOP	DO	HARD-WIRED
PUMP SPEED	AO	HARD-WIRED
ON/OFF STATUS	DI	NETWORK
VFD IN BYPASS	DI	NETWORK
ALARM	DI	NETWORK
ACTUAL SPEED	AI	NETWORK
POWER	AI	NETWORK
P-2		
SYSTEM	SCHW PUMP (B47)	
DESCRIPTION	TYPE	DEVICE
PUMP START/STOP	DO	HARD-WIRED
PUMP SPEED	AO	HARD-WIRED
ON/OFF STATUS	DI	NETWORK
VFD IN BYPASS	DI	NETWORK
ALARM	DI	NETWORK
ACTUAL SPEED	AI	NETWORK
POWER	AI	NETWORK
P-3		
SYSTEM	SCHW PUMP (B47)	
DESCRIPTION	TYPE	DEVICE
PUMP START/STOP	DO	HARD-WIRED
PUMP SPEED	AO	HARD-WIRED
ON/OFF STATUS	DI	NETWORK
VFD IN BYPASS	DI	NETWORK
ALARM	DI	NETWORK
ACTUAL SPEED	AI	NETWORK
POWER	AI	NETWORK
(E) P-3		
SYSTEM	(E) SCHW PUMP (POWER PLANT)	
DESCRIPTION	TYPE	DEVICE
PUMP START/STOP	DO	HARD-WIRED
PUMP SPEED	AO	HARD-WIRED
ON/OFF STATUS	DI	NETWORK
VFD IN BYPASS	DI	NETWORK
ALARM	DI	NETWORK
ACTUAL SPEED	AI	NETWORK
POWER	AI	NETWORK
(E) P-4		
SYSTEM	(E) SCHW PUMP (POWER PLANT)	
DESCRIPTION	TYPE	DEVICE
PUMP START/STOP	DO	HARD-WIRED
PUMP SPEED	AO	HARD-WIRED
ON/OFF STATUS	DI	NETWORK
VFD IN BYPASS	DI	NETWORK
ALARM	DI	NETWORK
ACTUAL SPEED	AI	NETWORK
POWER	AI	NETWORK

SCHWS/R		
SYSTEM	SECONDARY CHILLED WATER LOOP (CLINICAL ADDN)	
DESCRIPTION	TYPE	DEVICE
SCHWS TEMP	AI	HARD-WIRED
SCHWR TEMP	AI	HARD-WIRED
SCHWS FLOW	DI	HARD-WIRED
LOOP DIFF PRESS	AI	HARD-WIRED
SCHWS/R		
SYSTEM	SECONDARY CHILLED WATER LOOP (MAIN HOSPITAL)	
DESCRIPTION	TYPE	DEVICE
SCHWS TEMP	AI	HARD-WIRED
SCHWR TEMP	AI	HARD-WIRED
SCHWS FLOW	DI	HARD-WIRED
LOOP DIFF PRESS	AI	HARD-WIRED

PCHWS/R		
SYSTEM	PRIMARY/SECONDARY INTERFACE	
DESCRIPTION	TYPE	DEVICE
CHW FLOW	AI	HARD-WIRED
CHW DIRECTION	DI	HARD-WIRED

RDM-1		
SYSTEM	REFRIGERANT MONITOR	
DESCRIPTION	TYPE	DEVICE
WEST ROOM PPM	AI	HARD-WIRED
EAST ROOM PPM	AI	HARD-WIRED
ALARM	DI	HARD-WIRED

(E) CCU-1		
SYSTEM	500 TON CENTRIFUGAL CHILLER	
DESCRIPTION	TYPE	DEVICE
CHILLER START/STOP	DO	HARD-WIRED
CHWR FLOW SWITCH	DI	HARD-WIRED
CHWS TEMP	AI	HARD-WIRED
CHWR FLOW	AI	HARD-WIRED
CWTT TEMP	AI	HARD-WIRED
CWTT FLOW SWITCH	DI	HARD-WIRED
CHWS SETPOINT	AO	NETWORK
EVAP TEMP	AI	NETWORK
EVAP PRESSURE	AI	NETWORK
COND TEMP	AI	NETWORK
COND PRESSURE	AI	NETWORK
OIL TEMP	AI	NETWORK
OIL PRESSURE	AI	NETWORK
CURRENT LIMIT	AI	NETWORK
% KW	AI	NETWORK
STATUS	DI	NETWORK
ALARM	DI	NETWORK

CCU-2		
SYSTEM	550 TON CENTRIFUGAL CHILLER	
DESCRIPTION	TYPE	DEVICE
CHILLER START/STOP	DO	HARD-WIRED
CHWR FLOW SWITCH	DI	HARD-WIRED
CHWS TEMP	AI	HARD-WIRED
CHWR FLOW	AI	HARD-WIRED
CWTT TEMP	AI	HARD-WIRED
CWTT FLOW SWITCH	DI	HARD-WIRED
CHWS SETPOINT	AO	NETWORK
EVAP TEMP	AI	NETWORK
EVAP PRESSURE	AI	NETWORK
COND TEMP	AI	NETWORK
COND PRESSURE	AI	NETWORK
OIL TEMP	AI	NETWORK
OIL PRESSURE	AI	NETWORK
CURRENT LIMIT	AI	NETWORK
% KW	AI	NETWORK
STATUS	DI	NETWORK
ALARM	DI	NETWORK

CCU-3		
SYSTEM	350 TON CENTRIFUGAL CHILLER	
DESCRIPTION	TYPE	DEVICE
CHILLER START/STOP	DO	HARD-WIRED
CHWR FLOW SWITCH	DI	HARD-WIRED
CHWS TEMP	AI	HARD-WIRED
CHWR FLOW	AI	HARD-WIRED
CWTT TEMP	AI	HARD-WIRED
CWTT FLOW SWITCH	DI	HARD-WIRED
CHWS SETPOINT	AO	NETWORK
EVAP TEMP	AI	NETWORK
EVAP PRESSURE	AI	NETWORK
COND TEMP	AI	NETWORK
COND PRESSURE	AI	NETWORK
OIL TEMP	AI	NETWORK
OIL PRESSURE	AI	NETWORK
CURRENT LIMIT	AI	NETWORK
% KW	AI	NETWORK
STATUS	DI	NETWORK
ALARM	DI	NETWORK

CT-2		
SYSTEM	INDUCED DRAFT COOLING TOWER	
DESCRIPTION	TYPE	DEVICE
CT FAN 1 START/STOP	DO	HARD-WIRED
CT FAN 1 SPEED	DO	HARD-WIRED TO VFD
CT FAN 1 VIBRATION SWITCH	DI	NETWORK
CT FAN 1 VFD IN BYPASS	DI	NETWORK
CT FAN 1 VFD ALARM	DI	NETWORK
CT FAN 1 ACTUAL SPEED	AI	NETWORK
CT FAN 1 POWER	AI	NETWORK
CT FAN 2 START/STOP	DO	HARD-WIRED
CT FAN 2 SPEED	DO	HARD-WIRED
CT FAN 2 VIBRATION SWITCH	DI	NETWORK
CT FAN 2 VFD IN BYPASS	DI	NETWORK
CT FAN 2 VFD ALARM	DI	NETWORK
CT FAN 2 ACTUAL SPEED	AI	NETWORK
CT FAN 2 POWER	AI	NETWORK
CT CELL 1 INLET VALVE	DO	HARD-WIRED
CT CELL 2 INLET VALVE	DO	HARD-WIRED
CT CELL 1 OUTLET VALVE	DO	HARD-WIRED
CT CELL 2 OUTLET VALVE	DO	HARD-WIRED
CT CELL 1 BYPASS	DO	HARD-WIRED
CT CELL 2 BYPASS	DO	HARD-WIRED
BASIN TEMP	AI	HARD-WIRED
HEAT TRACING STATUS	DI	HARD-WIRED MONITOR WITH CS
BASIN HEATER STATUS	DI	HARD-WIRED MONITOR WITH CS
CWTT TEMP	AI	HARD-WIRED
AMBIENT TEMP	AI	HARD-WIRED

(E) EF-17		
SYSTEM	(E) EXHAUST FAN (REFRIG PURGE) EAST ROOM	
DESCRIPTION	TYPE	DEVICE
FAN START/STOP	DO	HARD-WIRED
FAN STATUS	DI	HARD-WIRED

EF-17A		
SYSTEM	EXHAUST FAN (REFRIG PURGE) WEST ROOM	
DESCRIPTION	TYPE	DEVICE
FAN START/STOP	DO	HARD-WIRED
FAN STATUS	DI	HARD-WIRED

EF-17B		
SYSTEM	EXHAUST FAN (VENTILATION)	
DESCRIPTION	TYPE	DEVICE
FAN START/STOP	DO	HARD-WIRED
FAN SPEED	AO	HARD-WIRED
ON/OFF STATUS	DI	NETWORK
VFD IN BYPASS	DI	NETWORK
ALARM	DI	NETWORK
ACTUAL SPEED	AI	NETWORK
POWER	AI	NETWORK


CD-1,2,3		
SYSTEM	POWER PLANT AIR FLOW DAMPERS	
DAMPER CD-1 OPEN	DO	HARD-WIRED NC DAMPER
DAMPER CD-2 OPEN	DO	HARD-WIRED NC DAMPER
DAMPER CD-3 OPEN	DO	HARD-WIRED NC DAMPER

CONFIDENTIAL: THESE DRAWINGS MUST BE RETURNED TO FACILITY MANAGEMENT SERVICE, PROJECT SECTION, UPON COMPLETION, OR UPON FINAL USE BY THE CONTRACTOR FOR BIDDING PURPOSES.

BUILDING IS FULLY SPRINKLERED


BID DOCUMENTS	ARCHITECT PROJECT NO.	2007-30
Drawing Title CONTROL DIAGRAMS - CHILLER ROOM BUILDING 47 - BASE BID	Project Title VA MEDICAL CENTER REPLACE HVAC CONTROLS	Date 03-13-08 Project No. 637-08-103
Approved By:	Building Number 47	Checked MPM
Note: Asbestos Containing Building Materials (ACBM) are present. Thermal Systems Insulation (TSI) and Miscellaneous ACBM are present in various locations.	Drawn WTJ	DRAWING NO. M004
	Location ASHEVILLE, NC.	Dwg. 5 of 29

Office of Facilities
Department of Veterans Affairs

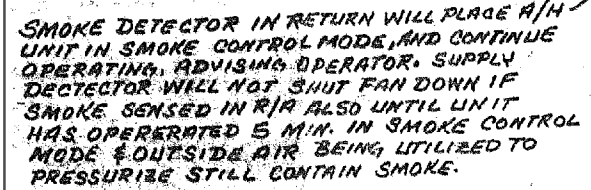


FROM 12-23-86 RECORD DWGS. - "ENERGY MANAGEMENT SYSTEM"
NOT TO SCALE

NOT TO SCALE

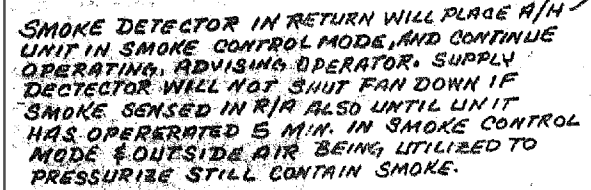


FROM POWERS CONTROLS AS-BUILTS - "'84-'86"
NOT TO SCALE

NOT TO SCALE

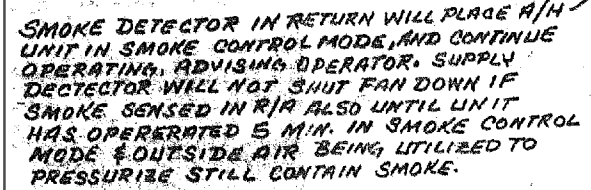


FROM "'91 RECORD DWGS." - ENERGY REDUCTION PROJECT #2

NOT TO SCALE

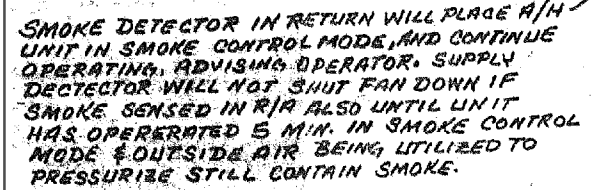


FROM 12-23-86 RECORD DWGS. - "ENERGY MANAGEMENT SYSTEM"

NOT TO SCALE

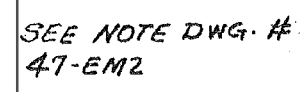


FROM 12-23-86 RECORD DWGS. - "ENERGY MANAGEMENT SYSTEM"

NOT TO SCALE

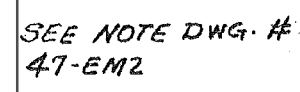

FROM POWERS CONTROLS AS-BUILTS - "'84-'86"

FROM F O
NOT TO SCALE

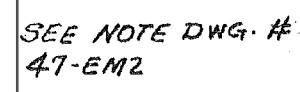


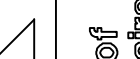
FROM POWERS CONTROLS AS-BUILTS - "'84-'86"

NOT TO SCALE

GENERAL NOTE:

- GENERAL NOTE:**
1. Contractor shall verify all dimensions.
2. Schedule on site inspections with the project COTR.
3. All work shall comply with OSHA, NFPA and all other applicable safety codes and regulations at all times.
4. All work shall be performed by craftsmen who are journeymen of the trade in which they are performing work.
5. Contractor superintendent shall report to the COTR each morning before work begins, at which the daily schedule shall be discussed.
6. Contractor shall maintain dust control at all times. Contractor shall use "stick mats" outside each work area and shall erect barriers to minimize dust/dirt, spreading/track to the greatest extent possible.
7. All debris from the project shall be kept clean and debris shall be removed from the jobsite daily.
8. All materials and equipment shall be stored in neat and organized fashion. Corridors shall be kept clean of all debris and obstructions to allow safe passage for employees, patients, visitors and workers. Dispose of all trash and discarded materials and maintain storage within the confines of the job site or other approved areas.
9. All damages incurred to adjacent areas shall be repaired and restored to original condition by the contractor at no additional cost to the government.

BUILDING IS FULLY SPRINKLERED

BID DOCUMENTS		ARCHITECT PROJECT NO. 2007-30		UPON COMPLETION, OR UPON FINAL USE BY THE CONTRACTOR FOR BIDDING PURPOSES.	
Drawing Title CONTROLS SEQUENCE OF OPERATION BUILDING 47 - BASE BID		Project Title VA MEDICAL CENTER REPLACE HVAC CONTROLS		Date 03-13-08	
				Project No. 637-08-103	
Approved By:		Building Number 47	Checked MM	Drawn WTJ	 Office of Facilities
Note: Asbestos Containing Building Materials (ACBM) are present. Thermal Systems Insulation (TSI) and Miscellaneous ACBM are present in various locations.		Location ASHEVILLE, N.C.		DRAWING NO. M005	
				Dwg. 6 Of 29	
				 Department of Veterans Affairs	

A/C - 6
SEQUENCE OF OPERATION
AREAS SERVED: OPERATING SUITES (100% OUTSIDE AIR)

Air handling unit will be controlled from ECC when starter is placed in automatic position. Exhaust fan #F-41/5 interlocked with A/C-6 to start and operate when it starts. Air handling units will operate continuously on schedule and modes directed by ECC. Existing freestat will shut down fan on temperatures at water coils below 38°. Chilled water pumps will start and coil valves will open to provide freeze protection. Existing firestat and smoke detectors in exhaust and supply ducts will remain in service and will shut down exhaust and/or air handling supply fan and activate signal to fire alarm system. Smoke detectors may be reset by operator from ECC. Additional alarms will be provided for O.R. auxiliary chiller compressors No. 1 and No. 2 lockout, freeze/heat low temperature, dual filter clogged, and coil filter media run-out. (CONTINUED AT PUGH)

ECC will select from five operating modes: Automatic, normal cooling (main chiller plant only), auxiliary cooling (auxiliary chiller only when main plant down), supplemental cooling (both chillers main first, auxiliary supplementing as needed without causing main chiller plant to operate for just O.R. load or causing chilled water from main plant to be reset down below load needs in rest of hospital just for O.R. zone), emergency cooling (all C.W. pumps including trans-injection pump) and all chillers available operating). ECC will start and stop auxiliary chiller and respective pumps automatically as O.R. load and schedule dictate. When A/H-6 fan is on outside air and fire dampers will open. Freestat operation will normally stop A/H fan and close dampers, unless being used for smoke removal mode. The ECC operator will be advised of fire/smoke conditions and extent, and will have ability to override smoke/fire detectors and freestat fan shutdown function to start selected supply and/or exhaust fan as appropriate for smoke removal. Heat recovery run-around coil will transfer energy when system is operating. Pre-heat steam valve and face and by-pass coil/damper will operate to maintain 50° temperature. A/H-6 discharge air temperature will be reset based on space temperature and requirements in zone, as function of hottest zone. When outside air is not sufficient to satisfy cooling needs, the chilled water valves will modulate. If main chiller plant is operating, cooling coil CC-6A will provide cooling if not adequate to satisfy load needs cooling coil CC-6A will be sequenced to supplement. Auxiliary O.R. chiller will be switched on along with respective chilled water pumps. If main chiller plant is not operating, auxiliary chiller will provide cooling needs as described above. Humidity sensor in Room A-270 will modulate humidifier steam valve and shall be limited by a high limit sensor in discharge air duct, to 85% R.H. The thirteen individual operating rooms and auxiliary spaces shall each have sensors to monitor and control temperature and RH, sensors located behind R/A grill in respective spaces. A/H-6 discharge air will be reset down as needed to maintain O.R. setpoints. When main chiller is operating, C.W. valve signal will reset chilled water supply from main chiller plant down. When O.R. only zone requiring chilled water or main chiller plant down then auxiliary chiller and associated C.W. valve will be reset and controlled. Re-heat coil 3-way valves will be modulated as needed to control temperature and/or humidity. Zone humidifier steam valve will be modulated to add humidity when needed. A/H-6 discharge air temperature will be lowered and re-heat coil utilized as needed to reduce zone humidity.

FROM 12-23-86 RECORD DWGS. - "ENERGY MANAGEMENT SYSTEM"
NOT TO SCALE

SEQUENCE OF OPERATION
AC-4
AREAS SERVED: OPERATING SUITES

AC-4 MAY BE STARTED AND STOPPED FROM THE HOA OR THE MOTOR STARTER OR FROM THE ECC. EXHAUST FAN E-41 IS INTERLOCKED TO START AND STOP WITH THE SUPPLY FAN.

WHEN AC-4 IS SHUTDOWN, THE FIRE, SMOKE AND OUTSIDE AIR DAMPERS WILL CLOSE AND THE CONTROL VALVES WILL ASSUME THEIR NORMAL POSITIONS.

THE FREEZESTAT (T-58) WILL SHUTDOWN AD-6 IF THE PREHEAT AIR TEMPERATURE FALLS TO 38 DEG. F. THE CHILLED WATER PUMPS WILL START AND ALL COIL VALVES WILL OPEN TO PROVIDE FREEZE PROTECTION. THE ECC OPERATOR WILL BE ADVISED OF A FREEZE CONDITION.

THE SUPPLY AIR SMOKE DETECTOR (SD-93) WILL SHUT DOWN AC-4 AND ADVISE THE ECC OPERATOR IF SMOKE IS DETECTED.

A SHUTDOWN OF AC-4 BY A SMOKE/FREEZE SITUATION MAY BE OVERTIDDEN FROM THE ECC.

THE HEAT RECOVERY PUMP WILL OPERATE WHEN THE SYSTEM IS OPERATING AND THE OUTSIDE AIR TEMPERATURE IS BELOW 55 DEG. F OR ABOVE 63 DEG. F.

THE PREHEAT STEAM VALVE (V-20) WILL OPEN IF THE COIL DISCHARGE TEMPERATURE FALLS BELOW 50 DEG. F. THE FACE AND BY PASS DAMPERS WILL MODULATE TO MAINTAIN A DISCHARGE AIR TEMPERATURE OF 50 DEG. F.

IF THE MAIN CHILLER PLANT IS OPERATING, CHILLED WATER VALVE (V-21) WILL MODULATE TO MAINTAIN THE DESIRED SUPPLY AIR TEMPERATURE. IF THE MAIN CHILLER PLANT IS NOT OPERATING OR IF ADDITIONAL COOLING IS NEEDED, THE AUXILIARY CHILLER WILL BE STARTED ALONG WITH THE ASSOCIATED CHILLER WATER PUMPS AND CHILLED WATER VALVE (V-22) WILL BE MODULATED AS REQUIRED.

AC-4 SUPPLY AIR TEMPERATURE WILL BE RESET FROM THE WARMEST O.R. ROOM.

HUMIDITY SENSOR (H-18) IN ROOM A-270 WILL MODULATE THE HUMIDIFIER VALVE (V-23) TO MAINTAIN 30% RH. A HUMIDITY HIGH LIMIT IN THE SUPPLY AIR WILL LIMIT THE DISCHARGE AIR RH TO 63%.

REHEAT COILS AND ZONE HUMIDIFIERS (SEE SCHEDULE ABOVE) WILL MAINTAIN ZONE CONDITIONS OF DEG. F X RH.

FROM POWERS CONTROLS AS-BUILTS - "'84-'86"
NOT TO SCALE

H/V -2
SEQUENCE OF OPERATION
AREA SERVED: KITCHEN (100% OUTSIDE AIR)

Heating ventilating unit will be controlled from ECC when starter is placed in automatic position. Heating ventilating unit will operate continuously on scheduled directed by ECC. Existing firestat in exhaust fans #B-26 and E-28 ducts will remain in service to shut down exhaust fan, H/V-2 fan and signal fire alarm system. New smoke detector installed in H/V unit's discharge air duct will shut fan down and activate fire alarm system. The ECC operator will be advised of fire/smoke condition and will have ability to override smoke/fire detector fan shut-down function and start selected supply or exhaust fans as may be appropriate for smoke removal. When H/V-2 fan is shut down for unoccupied night mode outside air damper will close. Pre-heat coils will be modulated and sequenced to maintain space temperature, fan to operate on high or low speed generally for heating mode. The humidity sensor located in exhaust fan E-28 duct will modulate humidifier steam valve as required to control minimum humidity. When space temperature increases, H/V-2 fan will operate on slow and/or fast speed to ventilate. Kitchen personnel will have ability to override fan speed selected by ECC logic and run fan on slow, fast or off as desired, manually during authorized time schedules. H/V-2 unit will be shut down at night. Room sensor will activate if needed to maintain minimum 40° space temperature, during unoccupied times. Fan E-2 will operate when H/V-2 operates. It will select speed same as H/V-2. Range hood fan E-25 cannot operate unless H/V-2 is operating. A local control speed selection switch will be installed adjacent to hood to allow operator to start/stop and select speed of fan.

FROM 12-23-86 RECORD DWGS. - "ENERGY MANAGEMENT SYSTEM"
NOT TO SCALE

HV-2
Area Served: Kitchen

HV-2 may be started and stopped from the local control switch or from the REC when the local switch is in the "Auto" position. Exhaust fan E-28 will operate at the same speed as HV-2.

HV-2 will operate on low speed if the outside air temperature is below 55°F, and high speed above 55°F. The outside air damper (D-30) will open when the unit starts and close when the unit stops.

E-26 will not operate unless HV-2 is operating. A local control switch will select the speed of the fan.

HV-2 will start if the space temperature falls below 40°F.

Freeostat (T-76) will shut down HV-2 if the supply air temperature falls below 38°F. All coil valves will open to provide freeze protection. The ECC operator will be advised of a freeze condition.

Supply air smoke detector (SD-68) will shut down the unit and advise the ECC operator if smoke is detected.

Firestats (T-74, T-75) are wired in a series loop and will advise the ECC operator if a high temperature condition exists in any of the exhaust fans.

Room temperature sensor (TT-30) will control the preheat coil valve (V-35) and the cooling coil valve (V-36) to maintain space temperature. Temperature sensor (TT-32) will maintain a minimum discharge temperature of 55°F.

Humidity sensor (H-48) will modulate the humidifier steam valve (W) to maintain the space relative humidity.

FROM POWERS CONTROLS AS-BUILTS - "'84-'86"
NOT TO SCALE

SEQUENCE OF OPERATION
AUXILIARY CHILLER

IN THE AUTOMATIC MODE, THE ECC WILL SELECT THE CHILLER(S) COMBINATION FOR MOST EFFICIENT OPERATION. THE AUXILIARY CHILLER WILL BE STARTED IF:

1. AC-6 REQUIRES COOLING AND THE MAIN CHILLER PLANT IS DOWN.
2. AC-6 REQUIRES MORE COOLING THAN THE MAIN CHILLER PLANT CAN PROVIDE.

IN THE MANUAL MODE, THE ECC OPERATOR MAY START OR STOP THE AUXILIARY CHILLER AND ASSOCIATED WATER PUMPS AS DESIRED.

ON A SIGNAL TO START, THE CHILLED WATER PUMP (P-12 OR P-13 AS SELECTED BY THE OPERATOR) WILL START. AFTER FLOW IS PROVEN THE AUXILIARY CHILLER WILL BE STARTED.

PUMP P-14 WILL BE STARTED IF THE MAIN CHILLER PLANT IS OPERATING, THE AUXILIARY CHILLER IS OPERATING, AND AC-6 REQUIRES MORE COOLING. A MESSAGE WILL BE SENT TO THE OPERATOR CONSOLE TO MANUALLY OPEN VALVES FOR THIS MODE AND TO CLOSE THEN WHEN THIS MODE IS TERMINATED.

PUMP P-15 WILL BE STARTED IF 2ND OR 4TH FLOOR ICU'S RISE ABOVE DEGREES.

FROM 12-23-86 RECORD DWGS. - "ENERGY MANAGEMENT SYSTEM"
NOT TO SCALE

AUXILIARY O.R. CHILLER
SEQUENCE OF OPERATION
AREA SERVED: OPERATING ROOM SUITE AND ICU'S

When A/C-6 (O.R.) and ICU units are operating and need more cooling than central chiller plant can provide, or if need cooling when main chiller plant down, then auxiliary chiller and chilled water pumps will start and operate. Refer to A/C-6 Sequence of Operation.

In emergency cooling mode, chilled water pumps will operate and main system injection pump, P-14, will also operate. Operator will be advised by ECC to manually open valves and close when operation in this mode is terminated.

Chiller efficiency and cooling load will be monitored by ECC and operator advised when should start main chiller plant and allow auxiliary chiller system to revert to stand-by/supplemental mode.

FROM POWERS CONTROLS AS-BUILTS - "'84-'86"
NOT TO SCALE

SEQUENCE OF OPERATION
ROOMS DD09 & DD06A

WHEN HV-2 IS OPERATING, ROOM DROP TEMPERATURE AND HUMIDITY SENSORS (TT-93, HT-19) WILL CONTROL REHEAT COIL RH-8 STEAM VALVE (V-39) AND HUMIDIFIER H-11 VALVE TO MAINTAIN ROOM CONDITIONS OF DEGREES AND % RH.

ROOM DD06A WILL BE CONTROLLED SIMILARLY BY RETURN AIR SENSORS (TT-95 AND HT-21).

ALARMS A-1 THROUGH A-11 WILL BE DISPLAYED AT CONSOLE 1 AND 2 ON THE CRT AND WILL BE DOCUMENTED ON THE EVENT PLOTTER.

EXISTING TEMPERATURE AND HUMIDITY CHART RECORDERS WILL REMAIN BUT WILL BE RECORDING ONLY INSTRUMENTS.

FROM POWERS CONTROLS AS-BUILTS - "'84-'86"
NOT TO SCALE

NOTE: FURNISH NEW CONTROL DEVICES, CONTROLLERS, CONTROL WIRING/ CONDUIT, REPROGRAMMING, ETC...

GENERAL NOTE:
1. Contractor shall field verify all dimensions.
2. Schedule on site inspections with the project COTR.
3. Contractor shall comply with OSHA, EPA, NFPA and all other applicable safety codes and regulations at all times.
4. All work shall be performed by craftsmen who are journeymen of the trade in which they are performing work.

7. Contractor to maintain the job site in a neat and orderly fashion at all times. Corridors shall be kept clean of all debris and obstructions to allow safe passage for employees, visitors and workers. Dispose of all trash and discarded materials and maintain storage within the confines of the job site or other approved areas.
8. All damages incurred to adjacent areas shall be repaired and restored to original condition by the contractor at no additional cost to the government.

9. All materials removed shall become property of the contractor, to be disposed off site unless scheduled to be reinstated or turned over to the VA.
10. Contractor superintendent shall carry a pager and/or install a job site telephone. Furnish numbers to the project COTR upon contract award.
11. Contractor shall schedule all utility interruptions with the project COTR at least forty-eight (48) hours in advance. Utility interruptions may require overtime work for all trades involved, and shall be provided by the contractor at no additional cost to the government.
12. "Hot Work" permits are required. Notify the COTR twenty-four (24) hours prior to commencement of work.

13. Manufacturers' trade names and numbers used herein identify a minimum standard. Subject to approval of the Contracting Officer, other products shall be considered, provided they are equivalent to these standards and meet the requirements of the technical specifications and drawings.

Revisions	Date

Seal:

ARN & M
ENGINEERS
Reece, Noland & McElrath, Inc.
409 North Haywood Street / PO Box 540
Waynesville, North Carolina 28786
WAYNESVILLE: 828-454-8851 FAX: 828-454-4200
NOLAND@ARN-ENGINEERS.COM © 2004 WWW.RNM-ENGINEERS.COM

batson
architects
Greenville Commons 220 N. Main Street, Suite 403 Greenville, South Carolina 29601 864.233.2222

POWER PLANT

QUAD 'D' QUAD 'A'

QUAD 'C' QUAD 'B'


KEY PLAN

BUILDING IS FULLY SPRINKLERED			
BID DOCUMENTS		ARCHITECT PROJECT NO. 2007-30	
Drawing Title CONTROLS SEQUENCE OF OPERATION BUILDING 47 - BASE BID		Date 03-13-08	
Approved By:		Project No. 637-08-103	
Note: Asbestos Containing Building Materials (ACBM) are present. Thermal Systems Insulation (TSI) and Miscellaneous ACBM are present in various locations.		Drawing NO. M006	
Location ASHEVILLE, N.C.		Dwg. 7 of 29	

Project Title VA MEDICAL CENTER REPLACE HVAC CONTROLS	Building Number 47	Checked NRM	Drawn WTJ
Office of Facilities			

CONFIDENTIAL: THESE DRAWINGS MUST BE RETURNED TO FACILITY MANAGEMENT SERVICE, PROJECT SECTION, UPON COMPLETION, OR UPON FINAL USE BY THE CONTRACTOR FOR BIDDING PURPOSES.

Department of Veterans Affairs

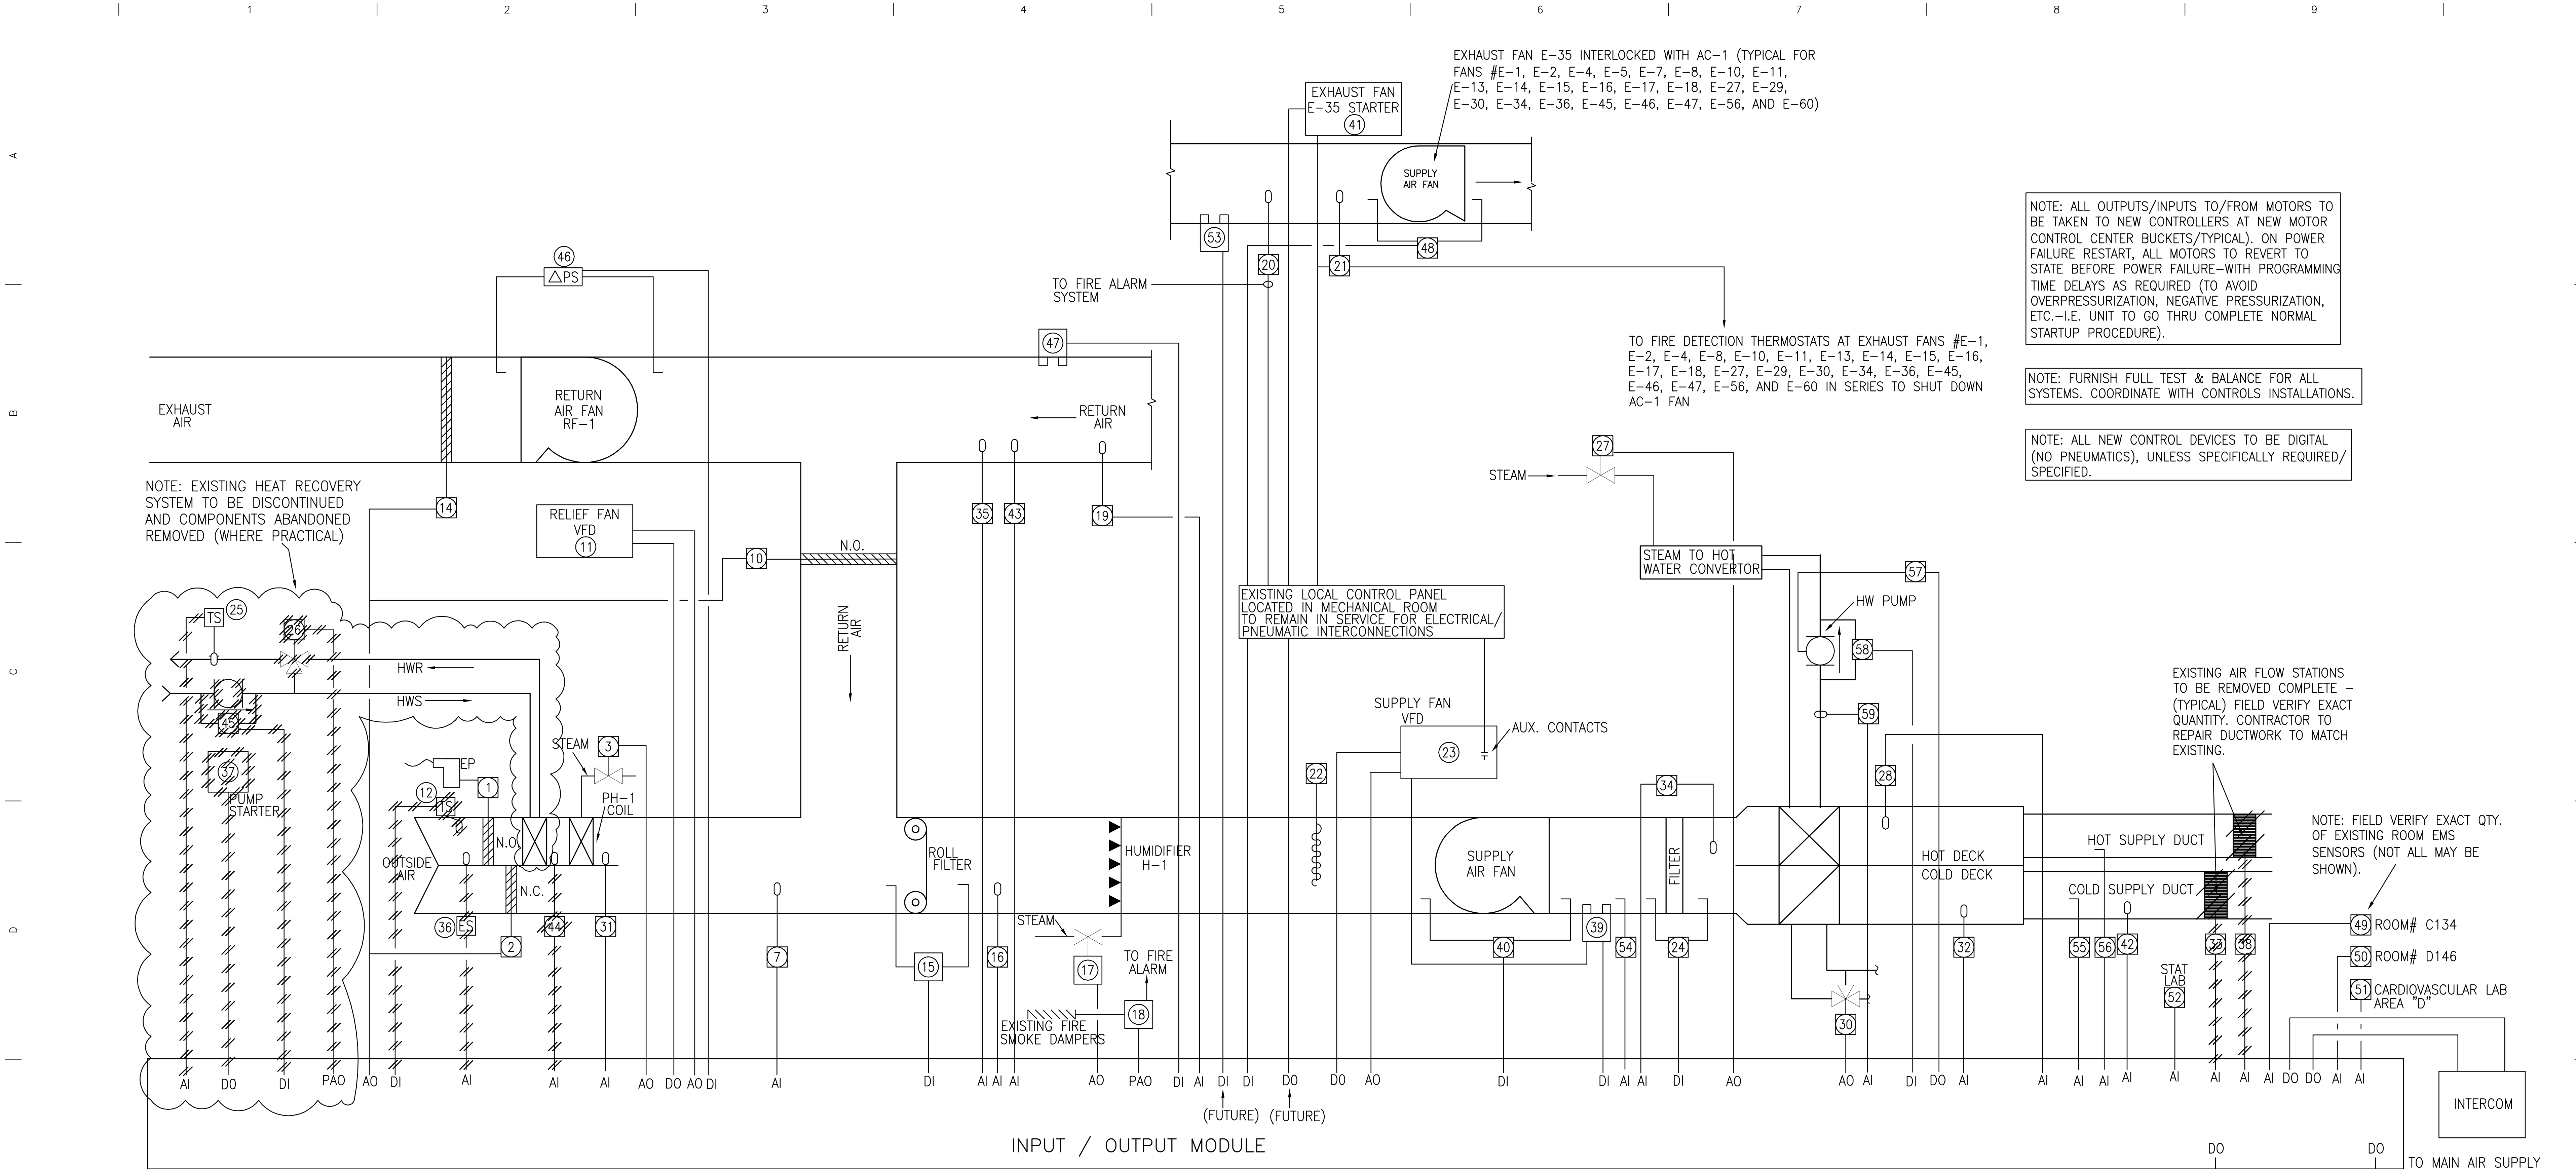

NOTE: ALL OUTPUTS/INPUTS TO/FROM MOTORS TO BE TAKEN TO NEW CONTROLLERS AT NEW MOTOR CONTROL CENTER BUCKETS/TYPICAL. ON POWER FAILURE RESTART, ALL MOTORS TO REVERT TO STATE BEFORE POWER FAILURE-WITH PROGRAMMING TIME DELAYS AS REQUIRED (TO AVOID OVERPRESSURIZATION, NEGATIVE PRESSURIZATION, ETC.-I.E. UNIT TO GO THRU COMPLETE NORMAL STARTUP PROCEDURE).

NOTE: FURNISH FULL TEST & BALANCE FOR ALL SYSTEMS. COORDINATE WITH CONTROLS INSTALLATIONS.

NOTE: ALL NEW CONTROL DEVICES TO BE DIGITAL (NO PNEUMATICS), UNLESS SPECIFICALLY REQUIRED/SPECIFIED.

EXISTING AIR FLOW STATIONS TO BE REMOVED COMPLETE - (TYPICAL) FIELD VERIFY EXACT QUANTITY. CONTRACTOR TO REPAIR DUCTWORK TO MATCH EXISTING.

NOTE: FIELD VERIFY EXACT QTY. OF EXISTING ROOM EMS SENSORS (NOT ALL MAY BE SHOWN).

NOTE: FURNISH NEW CONTROL DEVICES, CONTROLLERS, CONTROL WIRING/ CONDUIT, REPROGRAMMING, ETC...

1. EXISTING PNEUMATIC DAMPER ACTUATOR TO BE REPLACED WITH NEW ELECTRONIC ACTUATOR (MIN. O/A)

2. EXISTING ECONOMIZER PNEUMATIC DAMPER ACTUATOR TO BE REPLACED WITH NEW ELECTRONIC ACTUATOR.

3. EXISTING 2" N.O. STEAM VALVE PNEUMATIC ACTUATOR TO BE REPLACED WITH NEW ELECTRONIC ACTUATOR.

4. (NOT USED)

5. (NOT USED)

6. (NOT USED)

7. EXISTING FREEZE PROTECTION SENSOR TO BE REPLACED WITH NEW TEMPERATURE SENSOR.

8. (NOT USED)

9. (NOT USED)

10. EXISTING ECONOMIZER PNEUMATIC DAMPER ACTUATOR TO BE REPLACED WITH NEW ELECTRONIC ACTUATOR.

11. EXISTING RELIEF FAN VFD TO REMAIN (START / STOP & FAN SPEED VIA EMS).

12. EXISTING HEAT RECOVERY HIGH LIMIT THERMOSTAT TO BE REMOVED.

13. (NOT USED)

14. EXISTING PNEUMATIC DAMPER ACTUATOR FOR ECONOMIZER RELIEF DAMPER TO BE REPLACED WITH ELECTRONIC ACTUATOR.

15. EXISTING DIFFERENTIAL PRESSURE SWITCH TO BE REPLACED WITH NEW.

16. NEW DUCT HUMIDITY SENSOR (MIXED AIR)

17. EXISTING HUMIDIFIER STEAM VALVE. ACTUATOR TO BE REPLACED WITH NEW ELECTRONIC ACTUATOR.

18. EXISTING FIRE DAMPER ACTUATOR TO REMAIN IN SERVICE, (FURNISH E/P RELAYS AS REQUIRED).

19. EXISTING HUMIDITY SENSOR TO BE REPLACED.

20. EXISTING SPDT ELECTRIC REMOTE BULB THERMOSTAT TO REMAIN IN SERVICE.

21. EXISTING FIRE DETECTION THERMOSTAT TO REMAIN IN SERVICE.

22. EXISTING FREEZE DETECTION THERMOSTAT TO BE REPLACED.

23. EXISTING SUPPLY FAN VFD TO REMAIN (START / STOP & FAN SPEED VIA EMS).

24. EXISTING DIFFERENTIAL PRESSURE SWITCH, TO BE REPLACED.
25. EXISTING HEAT RECOVERY LOOP TEMP SENSOR TO BE REMOVED.

26. EXISTING HEAT RECOVERY 3-WAY BYPASS VALVE OUTPUT TO BE REMOVED.

27. EXISTING 2-1/2" N.C. STEAM VALVE PNEUMATIC ACTUATOR TO BE REPLACED WITH NEW ELECTRONIC ACTUATOR.

28. EXISTING DRY BULB TEMPERATURE SENSOR TO BE REPLACED WITH NEW TEMPERATURE SENSOR.

29. (NOT USED)

30. EXISTING 6" 3-WAY CHILLED WATER VALVE PNEUMATIC ACTUATOR TO BE REPLACED WITH NEW ELECTRONIC ACTUATOR.

31. NEW DUCT TEMP. SENSOR.

32. EXISTING DUCT SENSOR TO BE REPLACED WITH NEW TEMPERATURE SENSOR.

33. EXISTING AIR FLOW MEASURING STATION INPUT TO BE REMOVED.

34. EXISTING MIXED AIR SENSOR TO BE REPLACED WITH NEW TEMPERATURE SENSOR.

35. EXISTING ENTHALPY SENSOR TO BE REPLACED.

36. EXISTING ENTHALPY OUTSIDE AIR SENSOR TO BE REPLACED.

37. EXISTING HEAT RECOVERY COIL PUMP STARTER OUTPUT TO BE REMOVED.

38. EXISTING AIR FLOW MEASURING STATION INPUT TO BE REMOVED.

39. EXISTING DUCT SMOKE DETECTOR TO REMAIN.

40. EXISTING DIFFERENTIAL PRESSURE SWITCH TO BE REPLACED.

41. EXISTING EXHAUST FAN STARTER TO REMAIN (TYP OF 24)

42. EXISTING DUCT HUMIDITY SENSOR TO BE REPLACED (HIGH LIMIT).

43. EXISTING DUCT TEMP. SENSOR TO BE REPLACED (R/A).

44. EXISTING DUCT TEMP. SENSOR TO BE REMOVED.

45. EXISTING DIFFERENTIAL PRESSURE SWITCH FOR HEAT RECOVERY PUMP TO BE REMOVED.

46. EXISTING DIFFERENTIAL PRESSURE SWITCH TO BE REPLACED WITH NEW.

47. EXISTING DUCT SMOKE DETECTOR TO REMAIN.

48. EXISTING DIFFERENTIAL PRESSURE SWITCH TO BE REPLACED.

49. EXISTING ROOM SENSOR LOCATED IN DIRECTOR'S OFFICE #C134 TO BE REPLACED. (FIELD VERIFY)
50. EXISTING ROOM SENSOR LOCATED IN GENERAL LAB #D146 TO BE REPLACED. (FIELD VERIFY)

51. EXISTING ROOM SENSOR LOCATED IN CARDIOVASCULAR LAB - AREA "D" TO BE REPLACED. (FIELD VERIFY)

52. EXISTING ROOM SENSOR LOCATED IN STAT LAB TO BE REPLACED. (FIELD VERIFY)

53. FUTURE SMOKE DETECTOR.

54. REPLACE EXISTING DUCT STATIC PRESSURE SENSOR

55. REPLACE EXISTING DUCT STATIC PRESSURE SENSOR LOCATED IN DUCT NEAR SURGICAL CLINICS AREA.

56. REPLACE DUCT STATIC PRESSURE SENSOR LOCATED IN DUCT NEAR SURGICAL CLINICS AREA

57. EXISTING PUMP STARTER TO REMAIN.

58. EXISTING DIFFERENTIAL PRESSURE SWITCH TO BE REPLACED.

59. EXISTING WATER TEMP. SENSOR TO BE REPLACED.

GENERAL NOTE:

1. Contractor shall field verify all dimensions.
2. Schedule on site inspections with the project COTR.
3. Contractor shall comply with OSHA, EPA, NFPA and all other applicable safety codes and regulations at all times.
4. All work shall be performed by craftsmen who are journeymen of the trade in which they are performing work.
5. Contractor superintendent shall report to the COTR each morning before work begins, at which the daily schedule shall be discussed.
6. Contractor shall maintain dust control at all times. Contractor shall use "tidy mat" outside each work area and shall erect barriers to minimize dust/dirt, spreading/tracking to the greatest extent possible.
7. Contractor to maintain the job site in a neat and orderly fashion at all times. Corridors shall be kept clean of all debris and obstructions to allow safe passage for employees, visitors and workers. Dispose of all trash and discarded materials and maintain storage within the confines of the job site or other approved areas.
8. All damages incurred to adjacent areas shall be repaired and restored to original condition by the contractor at no additional cost to the government.
9. All materials removed shall become property of the contractor, to be disposed off site unless scheduled to be reinstalled or turned over to the VA.
10. Contractor superintendent shall carry a pager and/or install a job site telephone. Furnish numbers to the project COTR upon contract award.
11. Contractor shall schedule all utility interruptions with the project COTR at least forty-eight (48) hours in advance. Utility interruptions may require overtime work for all trades involved, and shall be provided by the contractor at no additional cost to the government.
12. "Hot Work" permits are required. Notify the COTR twenty-four (24) hours prior to commencement of work.
13. Manufacturers' trade names and numbers used herein identify a minimum standard. Subject to approval of the Contracting Officer, other products shall be considered, provided they are equivalent to these standards and meet the requirements of the technical specifications and drawings.

BUILDING IS FULLY SPRINKLERED

BID DOCUMENTS

Drawing Title
CONTROL DIAGRAM - A/C #1
BUILDING 47 - BASE BID

Approved By:

Note: Asbestos Containing Building Materials (ACBM) are present. Thermal Systems Insulation (TSI) and Miscellaneous ACBM are present in various locations.

ARCHITECT PROJECT NO.

VA MEDICAL CENTER
REPLACE HVAC CONTROLS

Building Number

47

Location

ASHEVILLE, N.C.

2007-30

Date

03-13-08

Project No.

637-08-103

DRAWING NO.







M101


Dwg. 8 of 29

CONFIDENTIAL: THESE DRAWINGS MUST BE RETURNED TO FACILITY MANAGEMENT SERVICE, PROJECT SECTION, UPON COMPLETION, OR UPON FINAL USE BY THE CONTRACTOR FOR BIDDING PURPOSES.



Revisions	Date

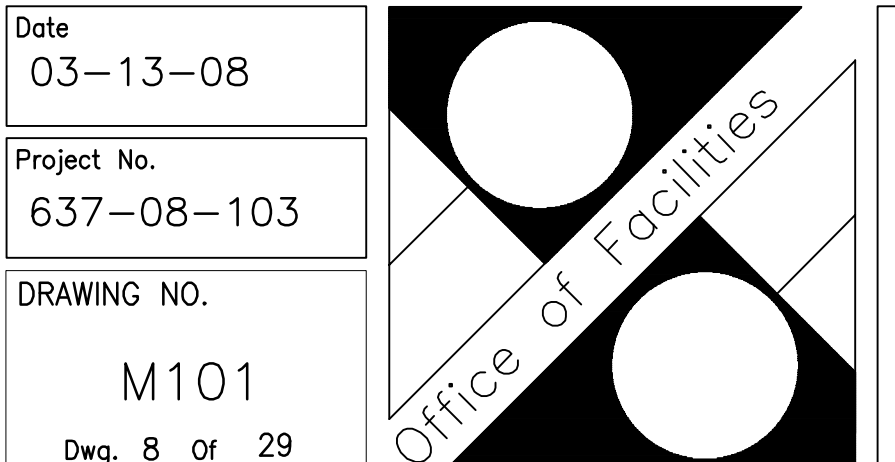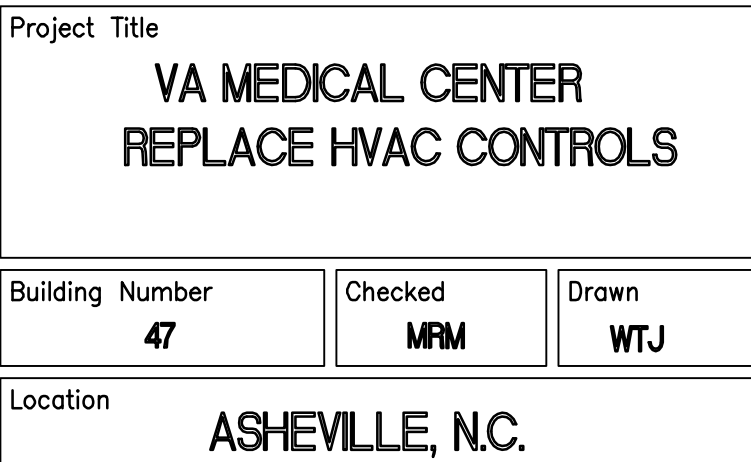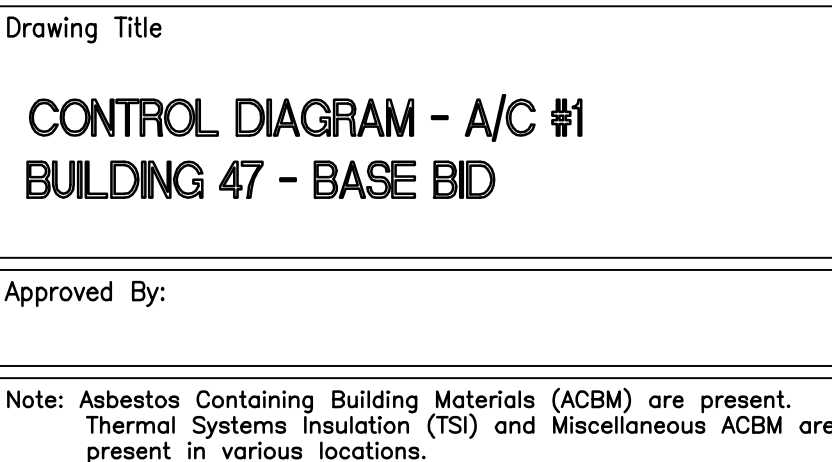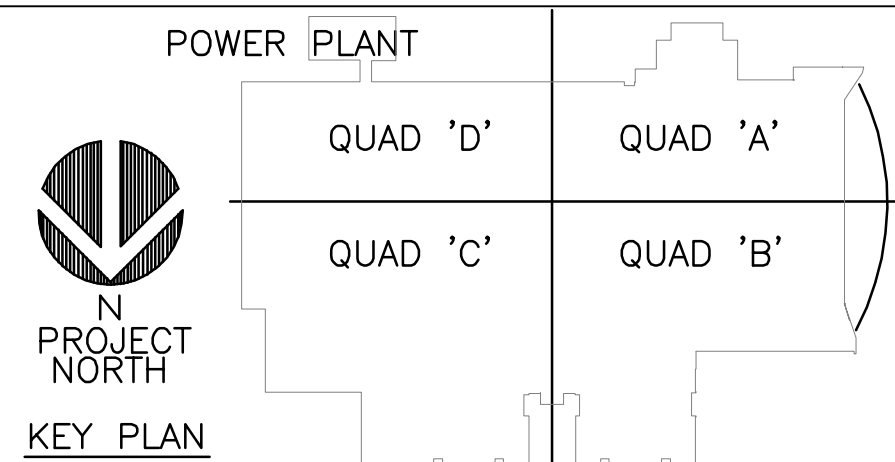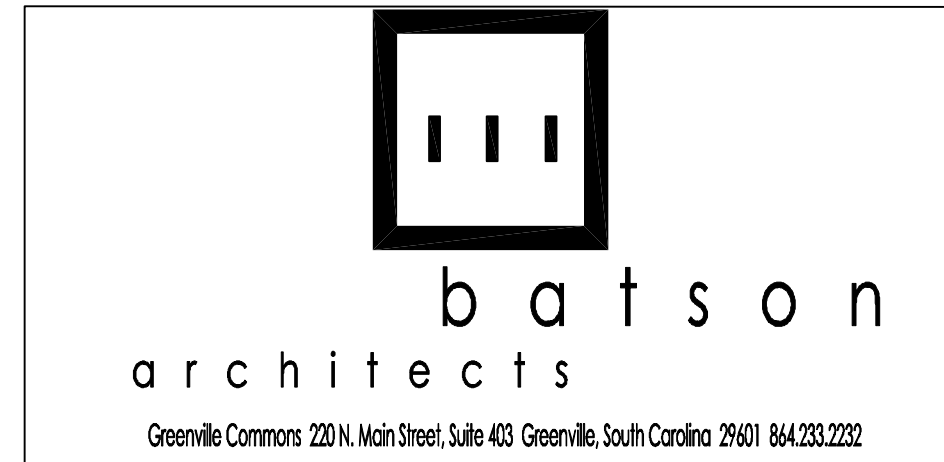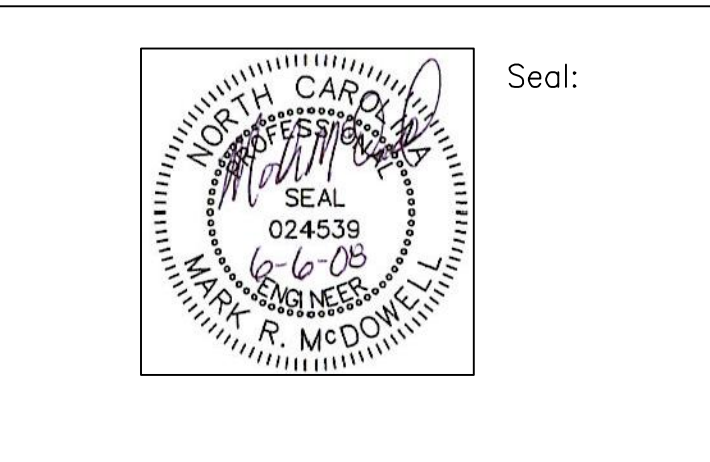

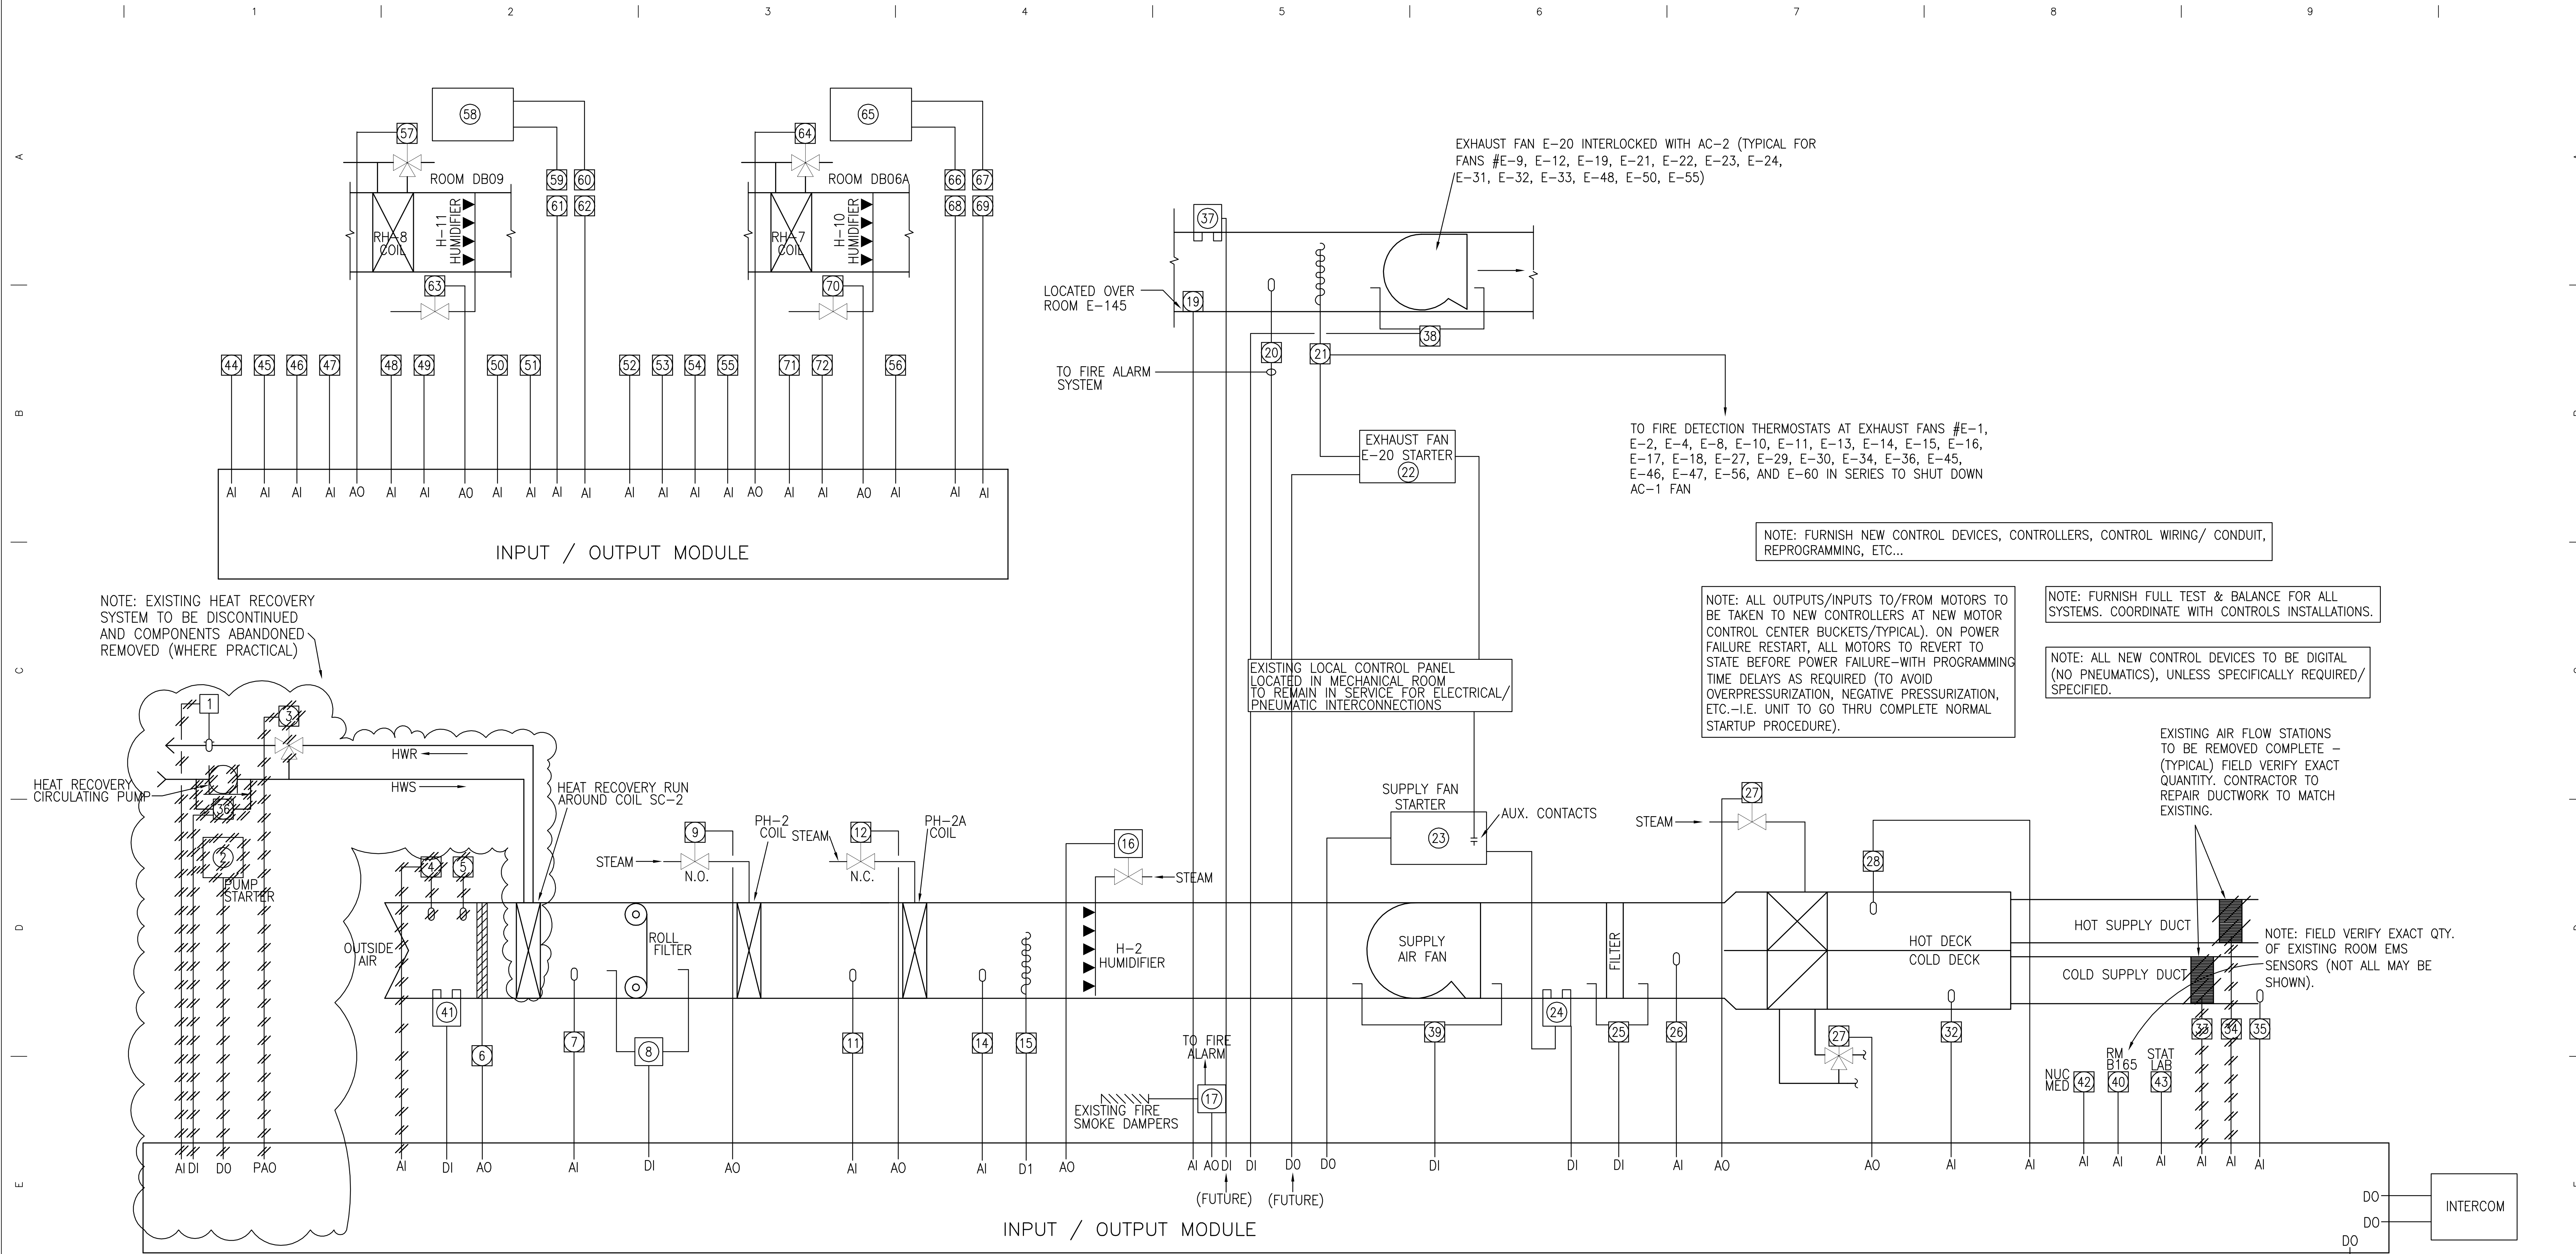

1. EXISTING HEAT RECOVERY WATER LOOP TEMPERATURE SENSOR TO BE REMOVED.

2. EXISTING HEAT RECOVERY COIL PUMP STARTER OUTPUT TO BE REMOVED.

3. EXISTING HEAT RECOVERY 3-WAY BYPASS VALVE OUTPUT TO BE REMOVED.

4. EXISTING TEMP SENSOR TO BE REMOVED.

5. (NOT USED).

6. EXISTING OUTSIDE AIR DAMPER PNEUMATIC ACTUATOR TO BE REPLACED WITH ELECTRONIC ACT.

7. EXISTING THERMOSTAT TO BE REPLACED WITH NEW TEMPERATURE SENSOR.

8. EXISTING DIFFERENTIAL PRESSURE SWITCH TO BE REPLACED WITH NEW.

9. EXISTING 2" N.O. STEAM VALVE WITH PNEUMATIC ACTUATOR TO BE REPLACED WITH ELECTRONIC ACT.

10. (NOT USED).

11. EXISTING TEMPERATURE SENSOR TO BE REPLACED W/ NEW.

12. EXISTING 2" N.C. STEAM VALVE WITH PNEUMATIC ACTUATOR TO BE REPLACED WITH ELECTRONIC ACT.

13. (NOT USED).

14. EXISTING TEMPERATURE SENSOR TO BE REPLACED W/ NEW.

15. EXISTING FREEZE DETECTION SENSOR TO BE REPLACED.

16. EXISTING HUMIDIFIER STEAM VALVE PNEUMATIC ACTUATOR TO BE REPLACED WITH ELECTRONIC ACT.

17. EXISTING FIRE DAMPER ACTUATOR TO REMAIN.

18. PNEUMATIC TO ELECTRIC TRANSDUCER TO REMAIN.
19. EXISTING PNEUMATIC HUMIDITY SENSOR TO REMAIN.

20. EXISTING SPDT ELECTRIC REMOTE BULB THERMOSTAT TO REMAIN IN SERVICE.

21. EXISTING FIRE DETECTION THERMOSTAT TO REMAIN.

22. EXISTING EXHAUST FAN STARTER TO REMAIN. (TYPICAL OF 14)

23. EXISTING SUPPLY FAN STARTER TO REMAIN.

24. EXISTING DUCT SMOKE DETECTOR TO REMAIN.

25. EXISTING DIFFERENTIAL PRESSURE SWITCH, TO BE REPLACED.

26. EXISTING TEMPERATURE SENSOR TO BE REPLACED.

27. EXISTING 1-1/2" N.C. STEAM VALVE WITH PNEUMATIC ACTUATOR TO BE REPLACED WITH ELECTRONIC ACT.

28. EXISTING TEMPERATURE SENSOR TO BE REPLACED WITH NEW TEMPERATURE SENSOR.

29. (NOT USED).

30. EXISTING 6" N.C. 3-WAY CHILLED WATER VALVE PNEUMATIC ACTUATOR TO BE REPLACED WITH NEW ELECTRONIC ACT.

31. (NOT USED).

32. EXISTING ELECTRONIC TEMPERATURE SENSOR TO BE REPLACED WITH NEW TEMPERATURE SENSOR.

33. EXISTING AIR STATION TO BE REMOVED.

34. EXISTING AIR STATION TO BE REMOVED.

35. EXISTING ENTHALPY SENSOR TO BE REPLACED.

36. DIFFERENTIAL PRESSURE SENSOR TO BE REPLACED.
37. EXISTING DUCT SMOKE DETECTOR TO REMAIN (TYP. OF 14) (FUTURE)

38. EXISTING DIFFERENTIAL PRESSURE SWITCH TO BE REPLACED. (TYP OF 14)

39. EXISTING DIFFERENTIAL PRESSURE SWITCH TO BE REPLACED. (TYP OF 14)

40. EXISTING ROOM EMS SENSOR TO BE REPLACED (COORDINATE QUANTITY)- ANA. LAB

41. EXISTING DUCT DETECTOR TO REMAIN

42. EXISTING ROOM EMS SENSOR TO BE REPLACED (COORDINATE QUANTITY)- NUC. LAB

43. EXISTING ROOM EMS SENSOR TO BE REPLACED (COORDINATE QUANTITY) - STAT LAB

44. EXISTING ROOM EMS TEMP. SENSOR TO BE REPLACED (ROOM D103)

45. EXISTING ROOM EMS HUMIDITY SENSOR TO BE REPLACED (ROOM D103)

46. EXISTING ROOM DB06A FILTER ALARM (DP SWITCH) TO BE REPLACED.

47. EXISTING ROOM DB09 FILTER ALARM (DP SWITCH) TO BE REPLACED.

48. EXISTING ROOM MORGUE FILTER ALARM (DP SWITCH) TO BE REPLACED.

49. EXISTING RESERVE OXYGEN SENSOR / ALARM TO BE REPLACED.

50. EXISTING RESERVE NITROGEN OXIDE SENSOR / ALARM TO BE REPLACED.

51. EXISTING OXYGEN LOW PRESSURE SENSOR / ALARM TO BE REPLACED.

52. EXISTING NITROGEN OXIDE LOW SENSOR / ALARM TO BE REPLACED.

53. EXISTING MEDICAL AIR SENSOR / ALARM TO BE REPLACED.

54. EXISTING EMERGENCY GENERATOR OPER. ALARM TO BE REPLACED.
55. EXISTING EMERGENCY GENERATOR TROUBLE-OFF ALARM TO BE REPLACED.

56. EXISTING EMERGENCY GENERATOR PRE SIGN. ALARM TO BE REPLACED.

57. EXISTING N.O. STEAM VALVE WITH PNEUMATIC ACTUATOR TO BE REPLACED WITH ELECTRONIC ACT.

58. EXISTING TEMPERATURE AND HUMIDITY CONTROLLER / RECORDER TO BE REPLACED (MONITORING)

59. EXISTING ROOM TEMP SENSOR IN ROOM DB09 TO BE REPLACED

60. EXISTING ROOM HUMIDITY SENSOR IN ROOM DB09 TO BE REPLACED

61. EXISTING ROOM TEMP SENSOR IN ROOM DB09 TO BE REPLACED

62. EXISTING ROOM HUMIDITY SENSOR IN ROOM DB09 TO BE REPLACED

63. EXISTING HUMIDIFIER STEAM VALVE PNEUMATIC ACTUATOR TO BE REPLACED WITH ELECTRONIC ACT.

64. EXISTING N.O. STEAM VALVE WITH PNEUMATIC ACTUATOR TO BE REPLACED WITH ELECTRONIC ACT.

65. EXISTING TEMPERATURE AND HUMIDITY CONTROLLER / RECORDER TO BE REPLACED (MONITORING)

66. EXISTING ROOM TEMP SENSOR IN ROOM DB06A TO BE REPLACED

67. EXISTING ROOM HUMIDITY SENSOR IN ROOM DB06A TO BE REPLACED

68. EXISTING ROOM TEMP SENSOR IN ROOM DB06A TO BE REPLACED

69. EXISTING ROOM HUMIDITY SENSOR IN ROOM DB06A TO BE REPLACED

70. EXISTING HUMIDIFIER STEAM VALVE PNEUMATIC ACTUATOR TO BE REPLACED WITH ELECTRONIC ACT.


71. EXISTING ROOM EMS TEMP. SENSOR TO BE REPLACED (ROOM D117)

72. EXISTING ROOM EMS HUMIDITY SENSOR TO BE REPLACED (ROOM D117)

GENERAL NOTE:

1. Contractor shall field verify all dimensions.
2. Schedule on site inspections with the project COTR.
3. Contractor shall comply with OSHA, EPA, NFPA and all other applicable safety codes and regulations at all times.
4. All work shall be performed by craftsmen who are journeymen of the trade in which they are performing work.
5. Contractor superintendent shall report to the COTR each morning before work begins, at which the daily schedule shall be discussed.
6. Contractor shall maintain dust control at all times. Contractor shall use "sticky mat" outside each work area and shall erect barriers to minimize dust/dirt, spreading/tracking to the greatest extent possible.
7. Contractor to maintain the job site in a neat and orderly fashion at all times. Corridors shall be kept clean of all debris and obstructions to allow safe passage for employees, patients, visitors and workers. Dispose of all trash and discarded materials and maintain storage within the confines of the job site or other approved areas.
8. All damage incurred to adjacent areas shall be repaired and restored to original condition by the contractor at no additional cost to the government.
9. All materials removed shall become property of the contractor, to be disposed off site unless scheduled to be reinstalled or turned over to the VA.
10. Contractor superintendent shall carry a pager and/or install a job site telephone. Furnish numbers to the project COTR upon contract award.
11. Contractor shall schedule all utility interruptions with the project COTR at least forty-eight (48) hours in advance. Utility interruptions may require overtime work for all trades involved, and shall be provided by the contractor at no additional cost to the government.
12. "Hot Work" permits are required. Notify the COTR twenty-four (24) hours prior to commencement of work.
13. Manufacturers' trade names and numbers used herein identify a minimum standard. Subject to approval of the Contracting Officer, other products shall be considered, provided they are equivalent to these standards and meet the requirements of the technical specifications and drawings.

<div>Revisions</div> <div>Date</div>		<div>Seal:</div> <div></div>	<div>RM&M ENGINEERS</div> <div>Reece, Noland & McElrath, Inc.</div> <div>499 North Haywood Street / PO Box 540</div> <div>Waynesville, North Carolina 28786</div> <div>WAYNESVILLE: 828-454-0851 FAX: 828-454-0200 Asheville: 828-251-3390</div> <div>MALDEN: 800-828-8888</div>	<div></div> <div>batson architects</div> <div>Greenville Commons 220 N. Main Street, Suite 405 Greenville, South Carolina 29601 864.233.2222</div>	<div>POWER PLANT</div> <div></div> <div>KEY PLAN</div>	<div>BUILDING IS FULLY SPRINKLERED</div> <div>BID DOCUMENTS</div> <div>Drawing Title</div> <div>CONTROL DIAGRAM - A/C #2</div> <div>BUILDING 47 - BASE BID</div> <div>Approved By:</div> <div>Note: Asbestos Containing Building Materials (ACBM) are present. Thermal Systems Insulation (TSI) and Miscellaneous ACBM are present in various locations.</div>		<div>ARCHITECT PROJECT NO. 2007-30</div> <div>Project Title</div> <div>VA MEDICAL CENTER</div> <div>REPLACE HVAC CONTROLS</div> <div>Building Number</div> <div>47</div> <div>Location</div> <div>ASHEVILLE, N.C.</div> <div>Date</div> <div>03-13-08</div> <div>Project No.</div> <div>637-08-103</div> <div>Checked</div> <div>MRM</div> <div>Drawn</div> <div>WTJ</div> <div>Drawing No.</div> <div>M102</div> <div>Dwg. 9 of 29</div>		<div>CONFIDENTIAL: THESE DRAWINGS MUST BE RETURNED TO FACILITY MANAGEMENT SERVICE, PROJECT SECTION, UPON COMPLETION, OR UPON FINAL USE BY THE CONTRACTOR FOR BIDDING PURPOSES.</div> <div></div> <div>Department of Veterans Affairs</div>
--------------------------------------	--	------------------------------	--	--	--	--	--	---	--	--

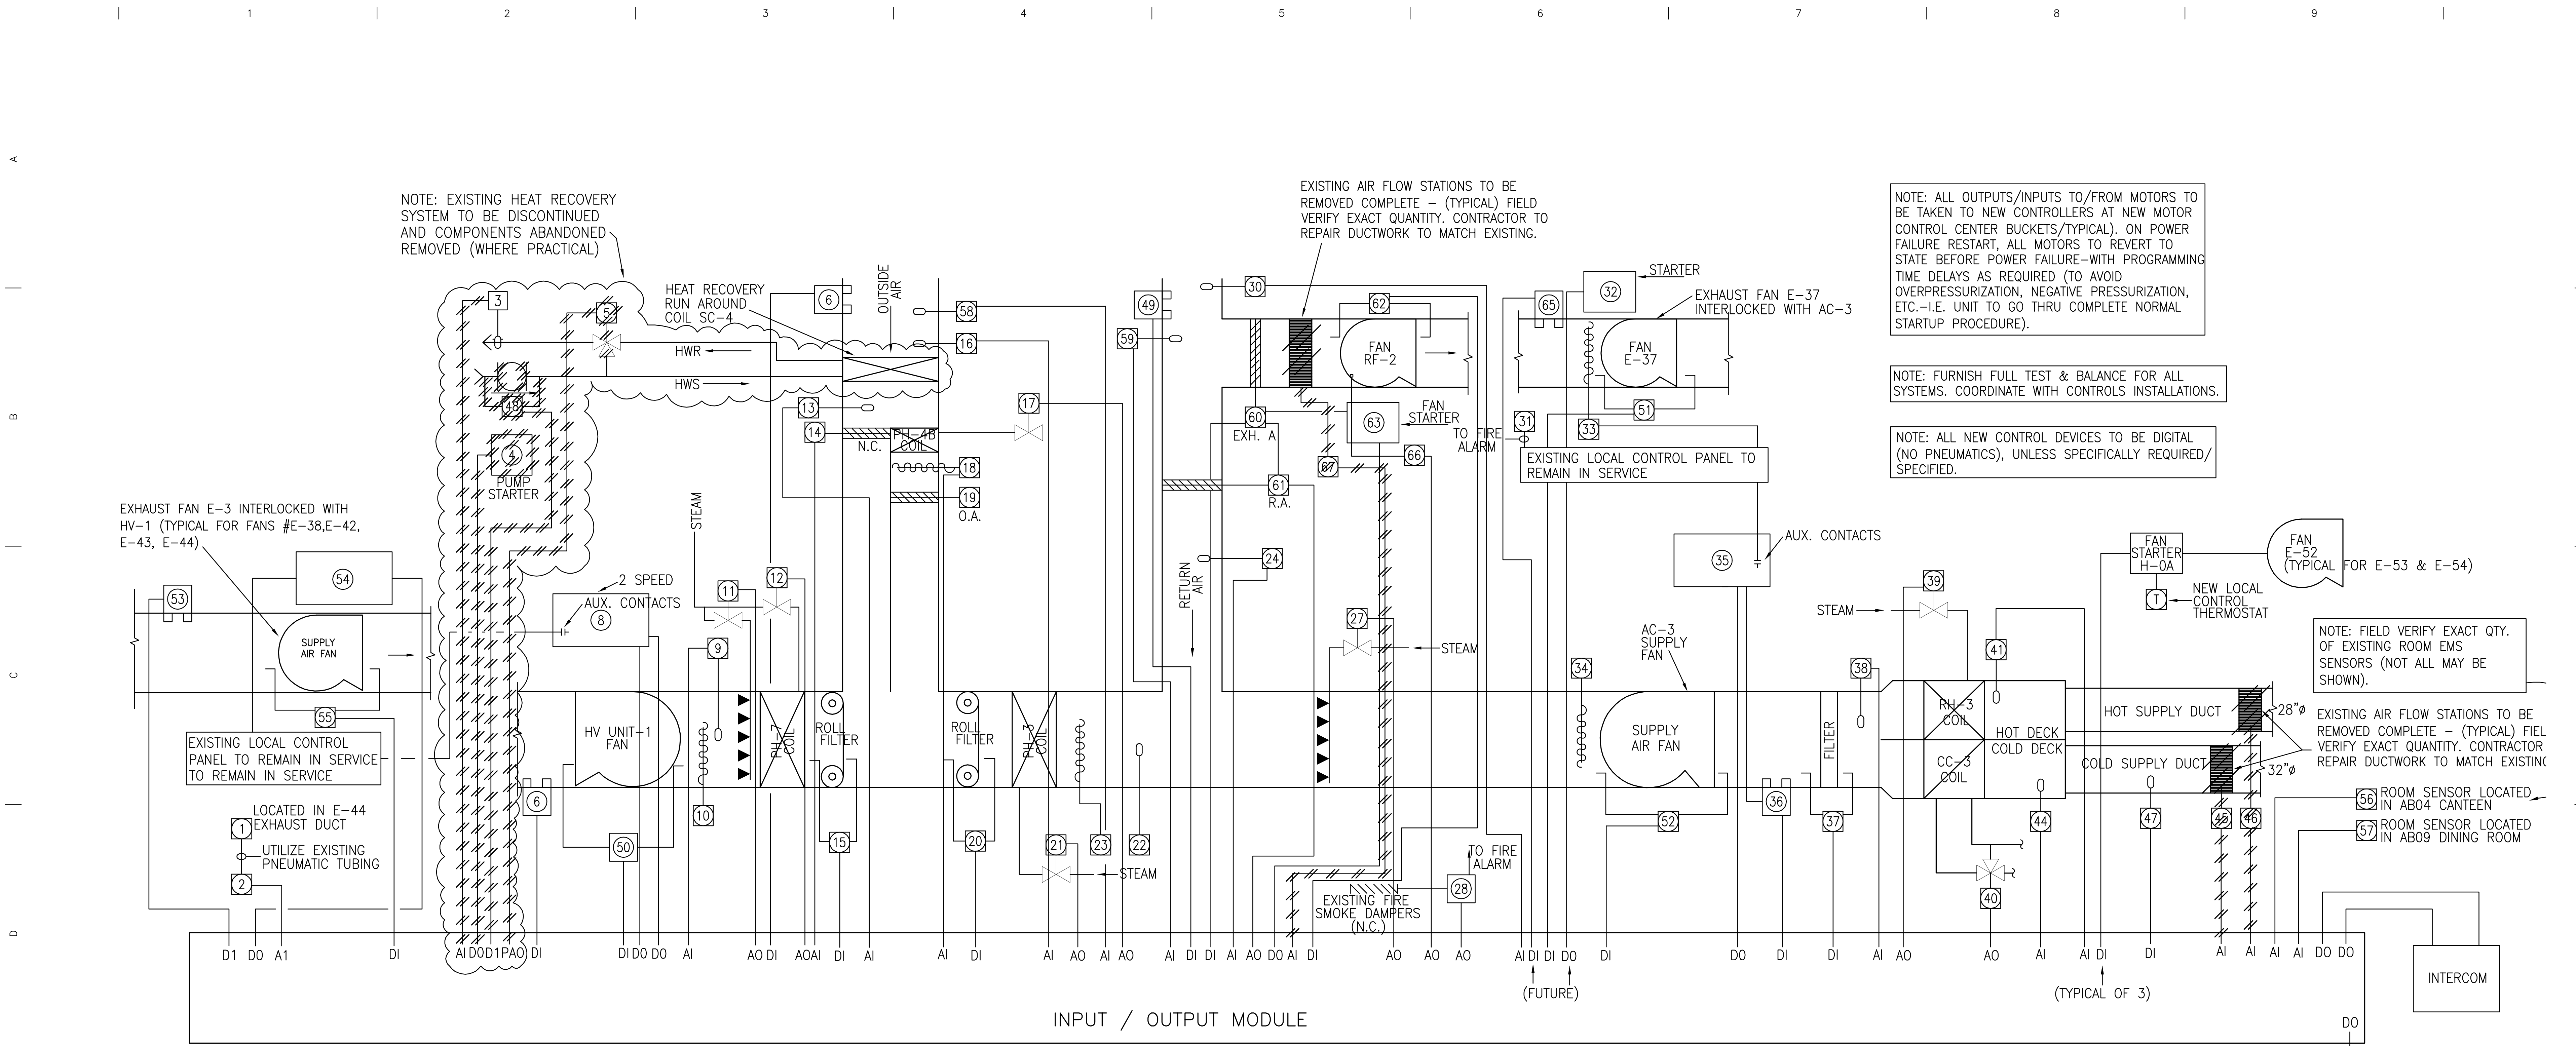

1. EXISTING PNEUMATIC HUMIDISTAT TO REMAIN.

2. EXISTING PNEUMATIC TO ELECTRIC TRANSDUCER TO REMAIN.

3. EXISTING HEAT RECOVERY WATER LOOP TEMPERATURE SENSOR TO BE REMOVED.

4. EXISTING HEAT RECOVERY COIL PUMP STARTER OUTPUT TO BE REMOVED.

5. EXISTING HEAT RECOVERY 3-WAY BYPASS VALVE OUTPUT TO BE REMOVED.

6. EXISTING DUCT SMOKE DETECTOR TO REMAIN.

7. (NOT USED).

8. EXISTING HV-1 UNIT FAN STARTER TO REMAIN.

9. EXISTING THERMOSTAT TO BE REPLACED WITH NEW TEMPERATURE SENSOR.

10. EXISTING FREEZE DETECTION THERMOSTAT TO BE REPLACED.

11. EXISTING HUMIDIFIER STEAM VALVE PNEUMATIC ACTUATOR TO BE REPLACED WITH ELECTRONIC ACTUATOR.

12. EXISTING 2-1/2" N.O. STEAM VALVE WITH PNEUMATIC ACTUATOR TO BE REPLACED WITH ELECTRONIC ACTUATOR

13. EXISTING TEMPERATURE SENSOR TO BE REPLACED WITH NEW TEMPERATURE SENSOR.

14. EXISTING PNEUMATIC DAMPER ACTUATOR FOR ECONOMIZER RELIEF DAMPER TO BE REPLACED WITH ELECTRONIC ACTUATOR.

15. EXISTING DIFFERENTIAL PRESSURE SWITCH TO BE REPLACED.

16. EXISTING TEMPERATURE SENSOR TO BE REPLACED WITH NEW TEMPERATURE SENSOR.

17. EXISTING 2" N.O. STEAM VALVE PNEUMATIC ACTUATOR TO BE REPLACED WITH ELECTRONIC ACTUATOR.

18. EXISTING TEMPERATURE SENSOR TO BE REPLACED WITH NEW TEMPERATURE SENSOR.

19. EXISTING OUTSIDE AIR DAMPER PNEUMATIC ACTUATOR TO BE REPLACED WITH ELECTRONIC ACTUATOR.

20. EXISTING DIFFERENTIAL PRESSURE SWITCH TO BE REPLACED.

21. EXISTING 1" N.O. STEAM VALVE PNEUMATIC ACTUATOR TO BE REPLACED WITH ELECTRONIC ACTUATOR.

22. EXISTING TEMPERATURE SENSOR TO BE REPLACED WITH NEW TEMPERATURE SENSOR.

23. (NOT USED).

24. NEW TEMPERATURE SENSOR TO BE REPLACED WITH NEW TEMPERATURE SENSOR.
25. (NOT USED).

26. (NOT USED).

27. EXISTING HUMIDIFIER STEAM VALVE PNEUMATIC ACTUATOR TO BE REPLACED WITH ELECTRONIC ACTUATOR.

28. EXISTING FIRE DAMPER ACTUATOR TO REMAIN IN SERVICE.

29. NOT USED.

30. EXISTING HUMIDITY SENSOR TO BE REPLACED (RETURN DUCT)

31. EXISTING THERMOSTAT TO BE REPLACED.

32. EXISTING EXHAUST FAN STARTER TO REMAIN.

33. EXISTING FIRE DETECTION SENSOR TO REMAIN.

34. EXISTING FREEZE DETECTION SENSOR TO BE REPLACED.

35. EXISTING SUPPLY FAN STARTER TO REMAIN.

36. EXISTING SMOKE DETECTOR TO REMAIN.

37. EXISTING DIFFERENTIAL PRESSURE SWITCH TO BE REPLACED.

38. EXISTING TEMPERATURE SENSOR TO BE REPLACED WITH NEW.

39. EXISTING 1-1/4" N.C. STEAM VALVE WITH PNEUMATIC ACTUATOR TO BE REPLACED WITH ELECTRONIC ACTUATOR.

40. EXISTING 4" 3-WAY CHILLED WATER VALVE PNEUMATIC ACTUATOR TO BE REPLACED WITH ELECTRONIC ACTUATOR.

41. EXISTING TEMPERATURE SENSOR TO BE REPLACED WITH NEW TEMPERATURE SENSOR.

42. (NOT USED).

43. (NOT USED).

44. EXISTING TEMPERATURE SENSOR TO BE REPLACED.

45. EXISTING AIR STATION TO BE REMOVED.

46. EXISTING AIR STATION TO BE REMOVED.

47. EXISTING HUMIDITY SENSOR TO BE REPLACED.

48. EXISTING DIFFERENTIAL PRESSURE SWITCH TO BE REPLACED.

49. EXISTING SMOKE DETECTOR TO REMAIN(RETURN AIR DUCT).
50. EXISTING DIFFERENTIAL PRESSURE SWITCH TO BE REPLACED.

51. EXISTING DIFFERENTIAL PRESSURE SWITCH TO BE REPLACED.

52. EXISTING DIFFERENTIAL PRESSURE SWITCH TO BE REPLACED.

53. EXISTING SMOKE DETECTOR TO REMAIN (EXHAUST AIR) (TYPICAL OF 5) (FUTURE).

54. EXISTING EXHAUST FAN STARTER TO REMAIN (TYPICAL OF 5).

55. EXISTING DIFFERENTIAL PRESSURE SWITCH TO BE REPLACED.

56. EXISTING ROOM EMS SENSOR TO BE REPLACED (COORDINATE QUANTITY)- AB04 CANTEEN.

57. EXISTING ROOM EMS SENSOR TO BE REPLACED (COORDINATE QUANTITY)- AB09 DINING ROOM.

58. EXISTING OUTSIDE AIR ENTHALPY SENSOR TO BE REPLACED.

59. EXISTING RETURN AIR ENTHALPY SENSOR TO BE REPLACED.

60. EXISTING RELIEF AIR DAMPER PNEUMATIC ACTUATOR TO BE REPLACED WITH ELECTRONIC ACTUATOR.

61. EXISTING RETURN AIR DAMPER PNEUMATIC ACTUATOR TO BE REPLACED WITH ELECTRONIC ACTUATOR.

62. EXISTING DIFFERENTIAL PRESSURE SWITCH TO BE REPLACED.

63. EXISTING FAN STARTER TO REMAIN.

64. EXISTING AIR SMOKE DETECTOR TO REMAIN.

65. FUTURE SMOKE DETECTOR.

66. EXISTING RF-2 INLET VANES PNEUMATIC ACTUATOR TO BE REPLACED WITH ELECTRONIC ACTUATOR.

67. EXISTING AIR FLOW SENSOR TO BE REMOVED.
- NOTE: FURNISH NEW CONTROL DEVICES, CONTROLLERS, CONTROL WIRING/ CONDUIT, REPROGRAMMING, ETC...

GENERAL NOTE:
1. Contractor shall field verify all dimensions.
2. Schedule on site inspections with the project COTR.
3. Contractor shall comply with OSHA, EPA, NFPA and all other applicable safety codes and regulations at all times.
4. All work shall be performed by craftsmen who are journeymen of the trade in which they are performing work.

5. Contractor superintendent shall report to the COTR each morning before work begins, at which the daily schedule shall be discussed.
6. Contractor shall maintain dust control at all times. Contractor shall use "tidy mats" outside each work area and shall erect barriers to minimize dust/dirt, spreading/tracking to the greatest extent possible.
7. Contractor to maintain the job site in a neat and orderly fashion at all times. Corridors shall be kept clean of all debris and obstructions to allow safe passage for employees, patients, visitors and workers. Dispose of all trash and discarded materials and maintain storage within the confines of the job site or other approved areas.
8. All damages incurred to adjacent areas shall be repaired and restored to original condition by the contractor at no additional cost to the government.

9. All materials removed shall become property of the contractor, to be disposed off site unless scheduled to be reinstalled or turned over to the VA.
10. Contractor superintendent shall carry a pager and/or install a job site telephone. Furnish numbers to the project COTR upon contract award.

11. Contractor shall schedule all utility interruptions with the project COTR at least forty-eight (48) hours in advance. Utility interruptions may require overtime work for all trades involved, and shall be provided by the contractor at no additional cost to the government.
12. "Hot Work" permits are required. Notify the COTR twenty-four (24) hours prior to commencement of work.

13. Manufacturers' trade names and numbers used herein identify a minimum standard. Subject to approval of the Contracting Officer, other products shall be considered, provided they are equivalent to these standards and meet the requirements of the technical specifications and drawings.

BUILDING IS FULLY SPRINKLERED

BID DOCUMENTS

ARCHITECT PROJECT NO. 2007-30

Drawing Title
CONTROL DIAGRAM - A/C #3
BUILDING 47 - BASE BID

Approved By:

Project Title
VA MEDICAL CENTER
REPLACE HVAC CONTROLS

Date
03-13-08

Project No.
637-08-103

Building Number
47

Checked
NFM

Drawn
WTJ

DRAWING NO.
M103

Location
ASHEVILLE, N.C.

Dwg. 10 of 29

Revisions

Date

Seal:

RECEIVED
CAROLINA
SEAL
024538
10-6-08
MARK R. MCOWEN, L.L.C.
REGISTERED PROFESSIONAL ENGINEER

RM ENGINEERS

Reece, Noland & McElrath, Inc.

409 North Haywood Street / PO Box 540
Waynesville, North Carolina 28786

WAYNESVILLE 828-424-9851 FAX 828-424-6200
MAIL@RNMENGINEERS.COM © 2006 WWW.RNMENGINEERS.COM

batson architects

Greenville Commons 220 N. Main Street, Suite 403 Greenville, South Carolina 29601 864.233.2232

POWER PLANT

QUAD 'D' QUAD 'A'


QUAD 'C' QUAD 'B'

KEY PLAN


CONFIDENTIAL: THESE DRAWINGS MUST BE RETURNED TO FACILITY MANAGEMENT SERVICE, PROJECT SECTION, UPON COMPLETION, OR UPON FINAL USE BY THE CONTRACTOR FOR BIDDING PURPOSES.

Office of Facilities

Department of Veterans Affairs

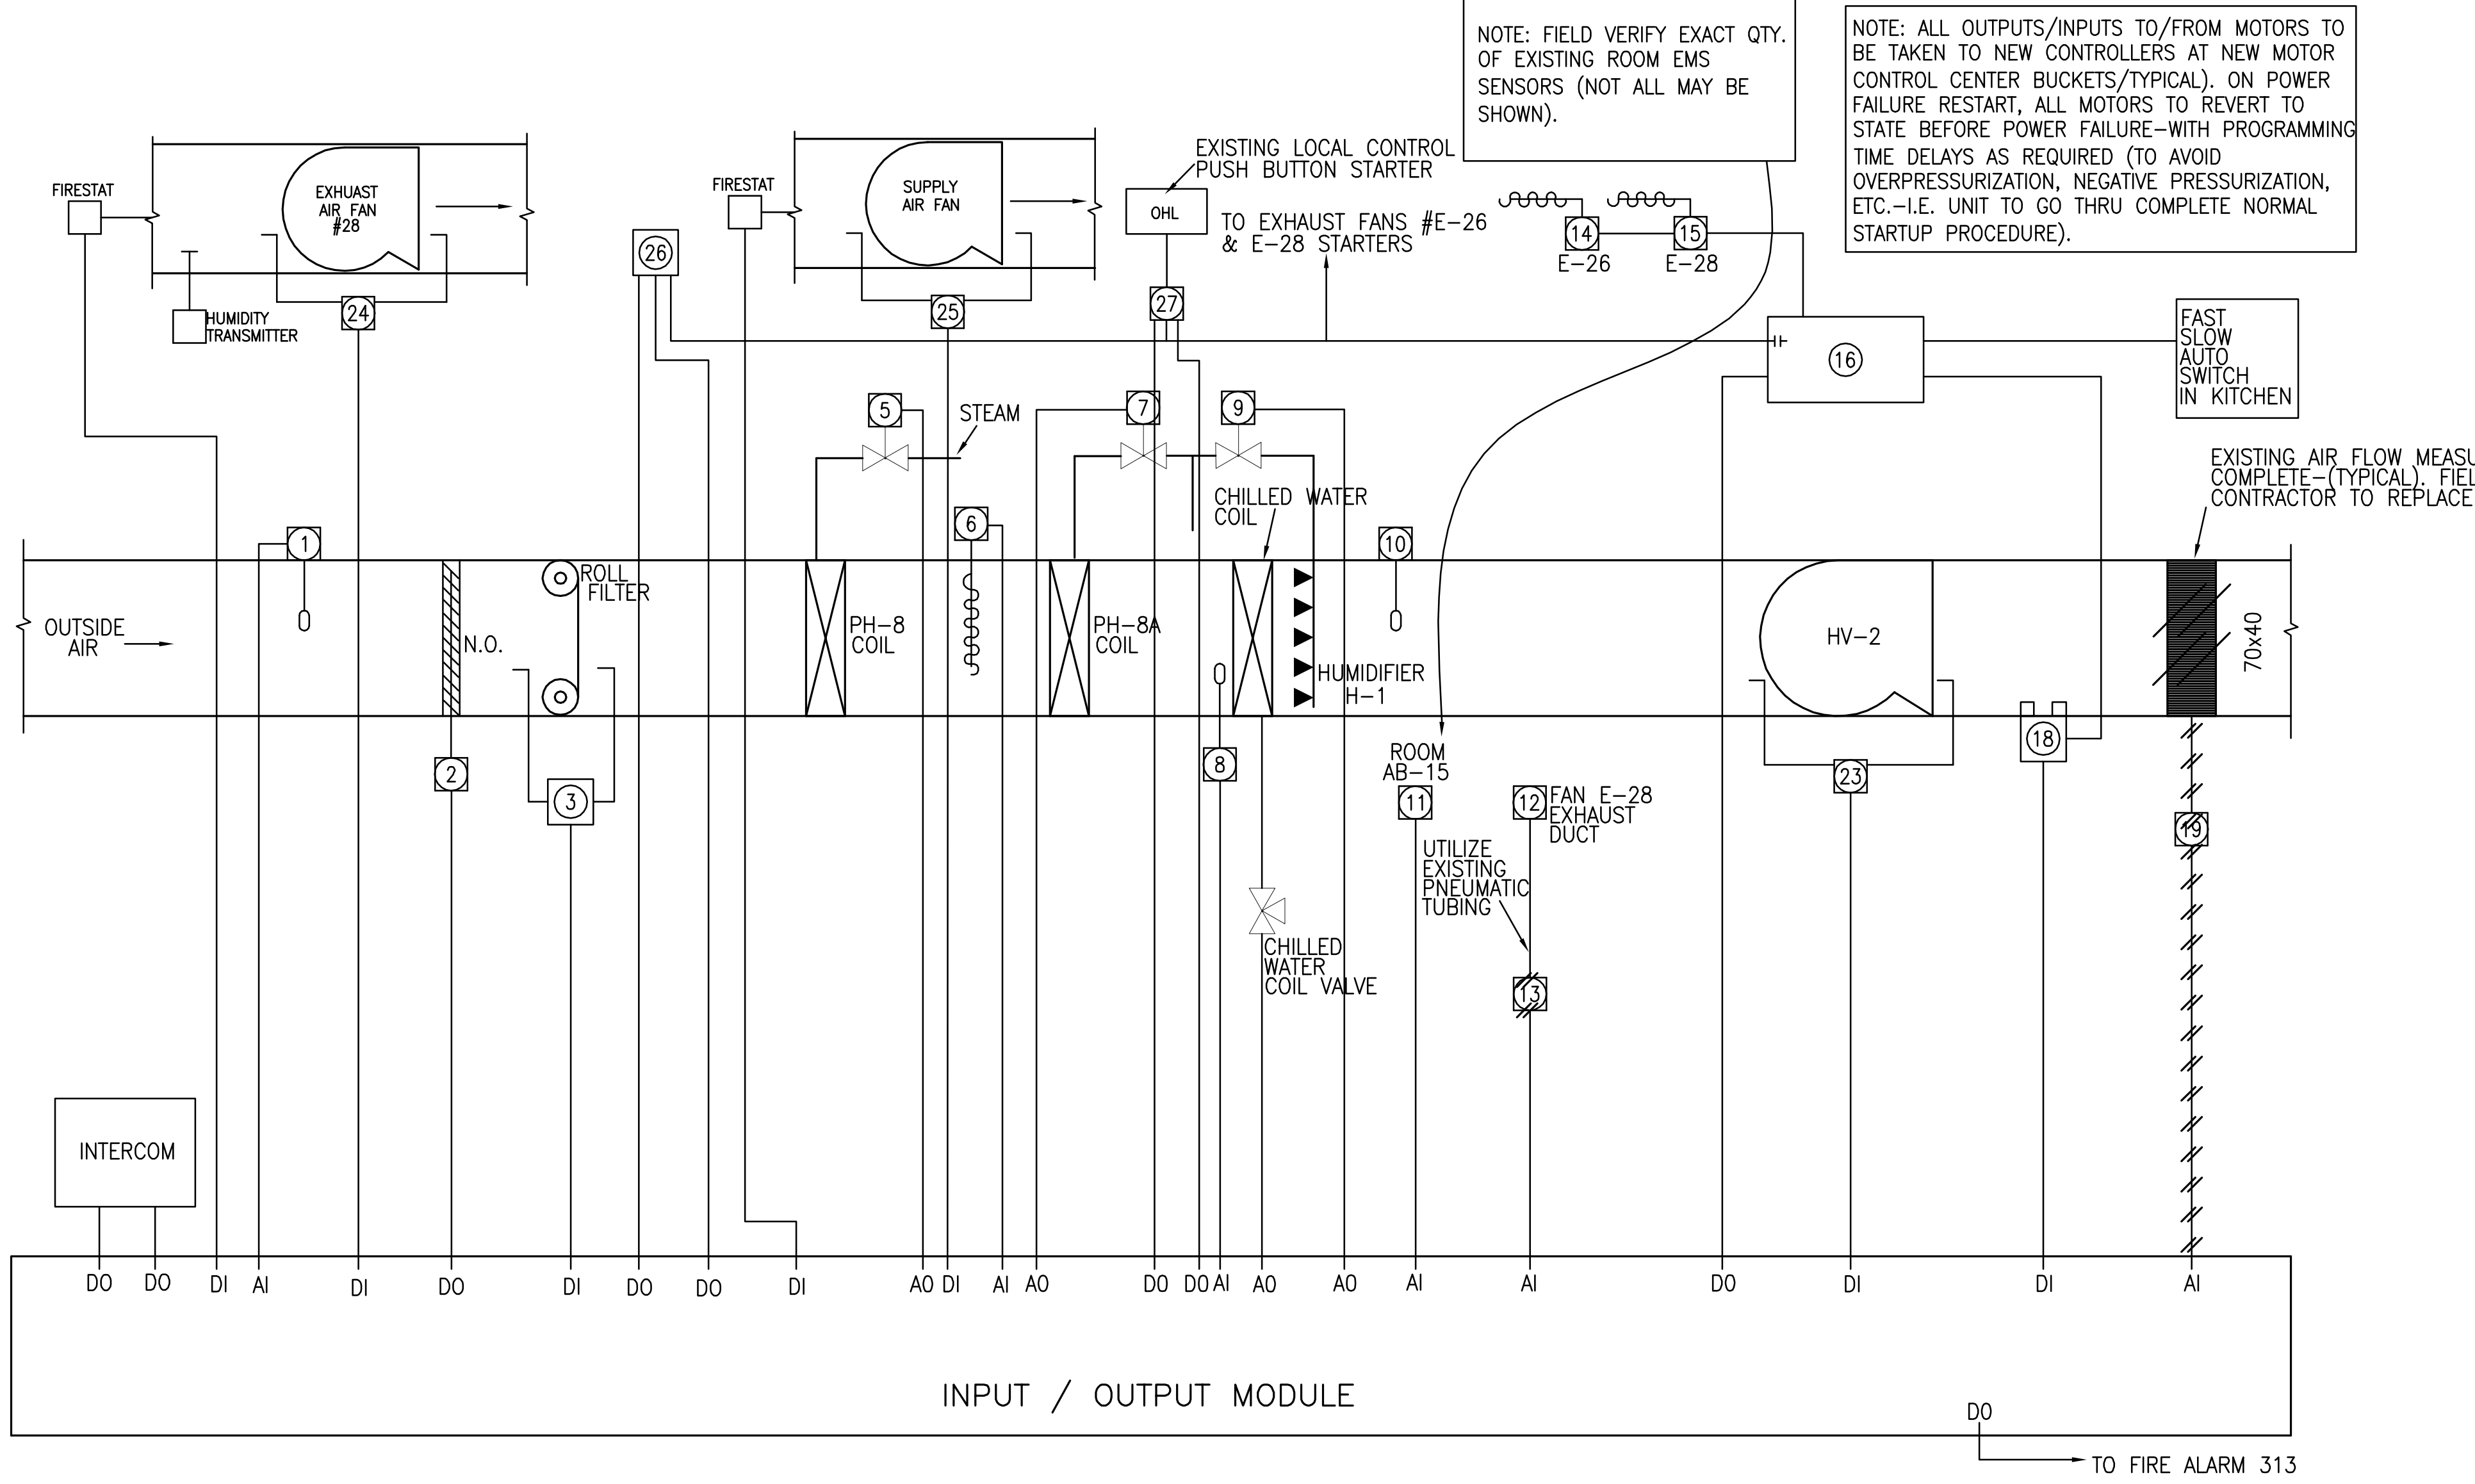

- EXISTING TEMPERATURE SENSOR TO BE REPLACED.
- EXISTING OUTSIDE AIR DAMPER PNEUMATIC ACTUATOR TO BE REPLACED WITH ELECTRONIC ACTUATOR.
- EXISTING DIFFERENTIAL PRESSURE SWITCH TO BE REPLACED.
- EXISTING TEMPERATURE SENSOR TO BE REPLACED.
- EXISTING STEAM VALVE PNEUMATIC ACTUATOR TO BE REPLACED WITH ELECTRONIC ACTUATOR.
- EXISTING TEMPERATURE SENSOR TO BE REPLACED.
- EXISTING STEAM VALVE WITH PNEUMATIC ACTUATOR TO BE REPLACED WITH ELECTRONIC ACTUATOR.
- EXISTING TEMPERATURE SENSOR TO BE REPLACED WITH NEW TEMPERATURE SENSOR.
- EXISTING STEAM VALVE PNEUMATIC ACTUATOR TO BE REPLACED WITH ELECTRONIC ACTUATOR.
- (NOT USED).
- EXISTING ROOM TEMPERATURE SENSOR TO BE REPLACED.
- EXISTING EXHAUST DUCT HYGROSTAT TO BE REPLACED.
- PNEUMATIC TO ELECTRIC RELAY TO BE REMOVED.
- EXISTING FIRE DETECTION THERMOSTAT AT EXHAUST FAN E-26 TO REMAIN.
- EXISTING FIRE DETECTION THERMOSTAT AT EXHAUST FAN E-28 TO REMAIN.
- EXISTING SUPPLY FAN STARTER TO REMAIN.
- (NOT USED).
- EXISTING SMOKE DETECTOR TO REMAIN.
- EXISTING AIR FLOW SENSOR TO BE REMOVED.
- (NOT USED).
- (NOT USED).
- (NOT USED).
- EXISTING DIFFERENTIAL PRESSURE SWITCH TO BE REPLACED.
- EXISTING DIFFERENTIAL PRESSURE SWITCH TO BE REPLACED.
- EXISTING DIFFERENTIAL PRESSURE SWITCH TO BE REPLACED.
- EXISTING FAN #E-28 STARTER (2-SPEED) TO REMAIN.
- EXISTING FAN #E-26 STARTER (2-SPEED) TO REMAIN.

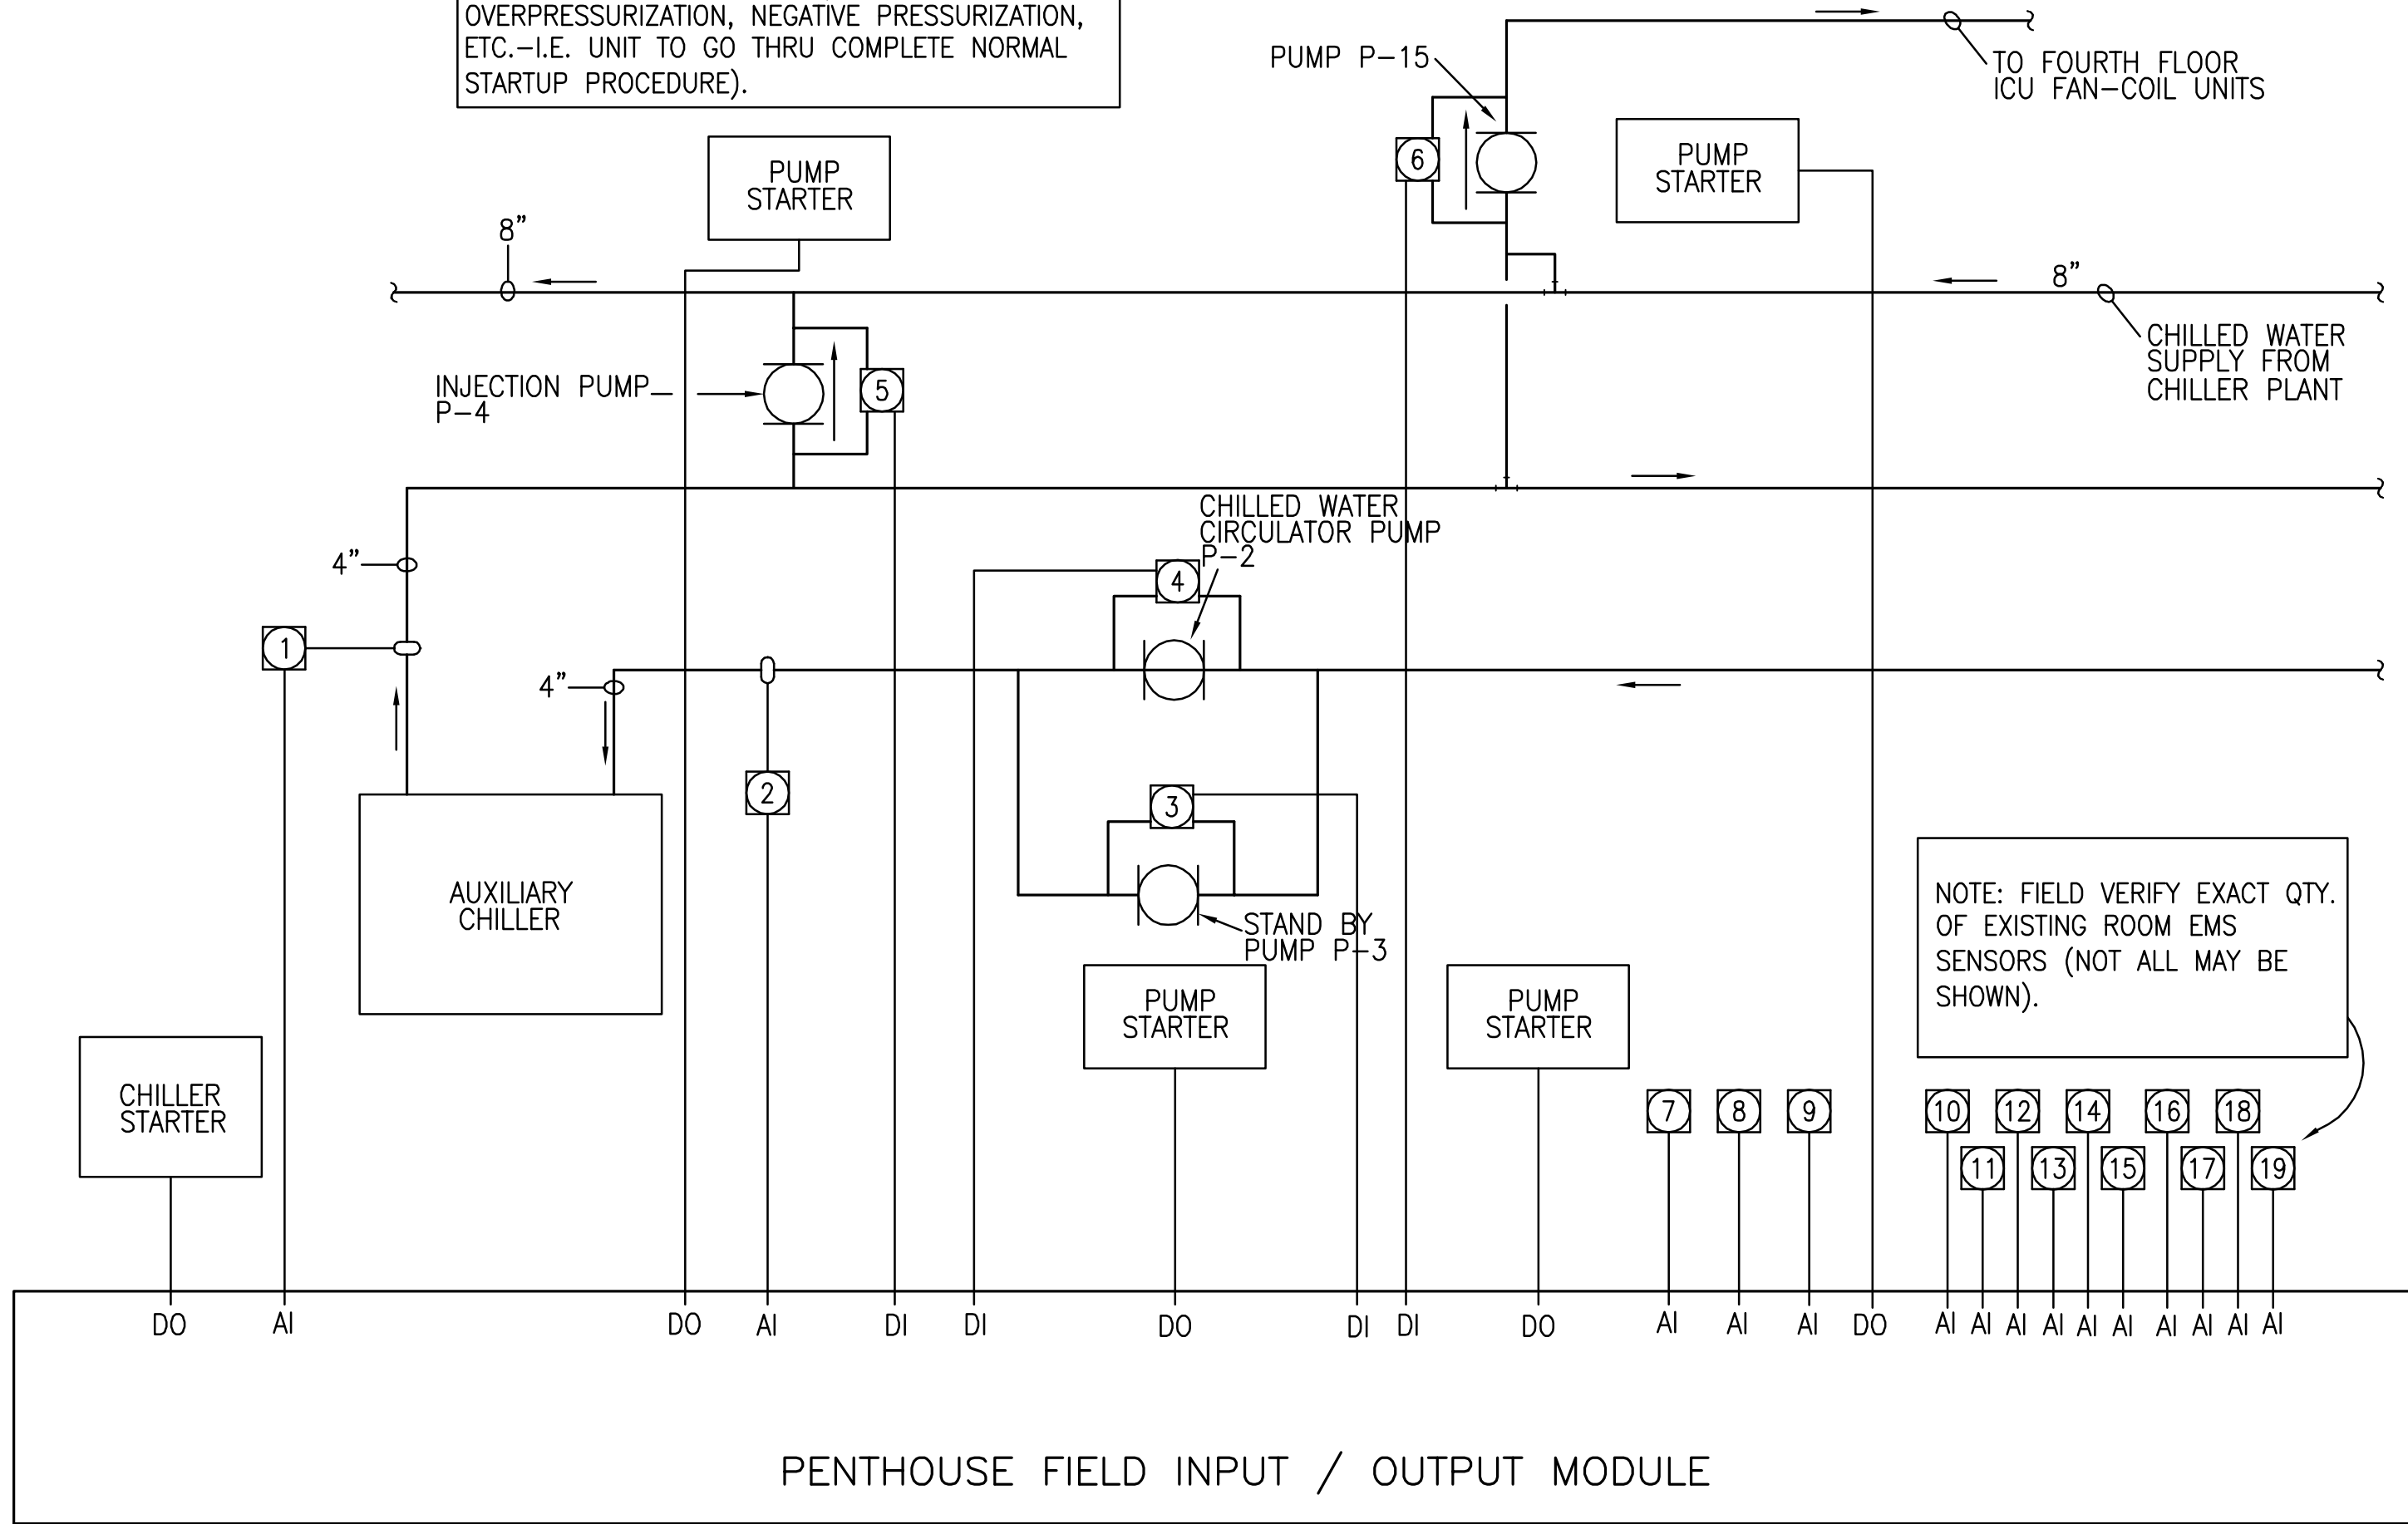

- EXISTING CHILLED WATER SUPPLY TEMPERATURE SENSOR TO BE REPLACED.
- EXISTING CHILLED WATER RETURN TEMPERATURE SENSOR TO BE REPLACED.
- EXISTING DIFFERENTIAL PRESSURE SWITCH TO BE REPLACED.
- EXISTING DIFFERENTIAL PRESSURE SWITCH TO BE REPLACED.
- EXISTING DIFFERENTIAL PRESSURE SWITCH TO BE REPLACED.
- EXISTING DIFFERENTIAL PRESSURE SWITCH TO BE REPLACED.
- EXISTING TEMPERATURE SENSOR IN NURSES STATION ROOM #A113 TO BE REPLACED.
- EXISTING TEMPERATURE SENSOR IN NURSES STATION ROOM #A148 TO BE REPLACED.
- EXISTING TEMPERATURE SENSOR IN NURSES STATION ROOM #A232 TO BE REPLACED.
- EXISTING TEMPERATURE SENSOR IN NURSES STATION ROOM #A252 TO BE REPLACED.
- EXISTING TEMPERATURE SENSOR IN NURSES STATION ROOM #A323 TO BE REPLACED.
- EXISTING TEMPERATURE SENSOR IN NURSES STATION ROOM #A352 TO BE REPLACED.
- EXISTING TEMPERATURE SENSOR IN NURSES STATION ROOM #B319 TO BE REPLACED.
- EXISTING TEMPERATURE SENSOR IN NURSES STATION ROOM #A423 TO BE REPLACED.
- EXISTING TEMPERATURE SENSOR IN NURSES STATION ROOM #A452 TO BE REPLACED.
- EXISTING TEMPERATURE SENSOR IN NURSES STATION ROOM #B419 TO BE REPLACED.
- EXISTING TEMPERATURE SENSOR IN NURSES STATION ROOM #A523 TO BE REPLACED.
- EXISTING TEMPERATURE SENSOR IN NURSES STATION ROOM #A552 TO BE REPLACED.
- EXISTING TEMPERATURE SENSOR IN NURSES STATION ROOM #B519 TO BE REPLACED.

GENERAL NOTE:

- Contractor shall field verify all dimensions.
- Schedule on site inspections with the project COTR.
- Contractor shall comply with OSHA, EPA, NFPA and all other applicable safety codes and regulations at all times.
- All work shall be performed by craftsmen who are journeymen of the trade in which they are performing work.
- Contractor superintendent shall report to the COTR each morning before work begins, at which the daily schedule shall be discussed.
- Contractor shall maintain dust control at all times. Contractor shall use "tidy mot" outside each work area and shall erect barriers to minimize dust/dirt, spreading/tracking to the greatest extent possible.
- All damages incurred to adjacent areas shall be repaired and restored to original condition by the contractor at no additional cost to the government.
- Contractor shall maintain the job site in a neat and orderly fashion at all times. Corridors shall be kept clean of all debris and obstructions to allow safe passage for employees, visitors and workers. Dispose of all trash and discarded materials and maintain storage within the confines of the job site or other approved areas.
- All materials removed shall become property of the contractor, to be disposed off site unless scheduled to be reinstalled or turned over to the VA.
- Contractor superintendent shall carry a pager and/or install a job site telephone. Furnish numbers to the project COTR upon contract award.
- Contractor shall schedule all utility interruptions with the project COTR at least forty-eight (48) hours in advance. Utility interruptions may require overtime work for all trades involved, and shall be provided by the contractor at no additional cost to the government.
- "Hot Work" permits are required. Notify the COTR twenty-four (24) hours prior to commencement of work.
- Manufacturers' trade names and numbers used herein identify a minimum standard. Subject to approval of the Contracting Officer, other products may be considered, provided they are equivalent to these standards and meet the requirements of the technical specifications and drawings.

BUILDING IS FULLY SPRINKLERED

BID DOCUMENTS		ARCHITECT PROJECT NO. 2007-30	
Drawing Title: CONTROL DIAGRAM - H/V #2: O.R. AUX. CHILLER SYSTEM: AND MAIN BOILER ROOM		Project Title: VA MEDICAL CENTER REPLACE HVAC CONTROLS	
Approved By:		Date: 03-13-08	
Note: Asbestos Containing Building Materials (ACBM) are present. Thermal Systems Insulation (TSI) and Miscellaneous ACBM are present in various locations.		Project No. 637-08-103	
Location: ASHEVILLE, N.C.		Building Number: 47	
		Checked: NFM	
		Drawn: WTJ	
		Drawing No. M104	
		Dwg. 11 of 29	

Revisions: _____ Date: _____

Seal:


ARN&M ENGINEERS
Reece, Noland & McElrath, Inc.
409 North Haywood Street / PO Box 540
Waynesville, North Carolina 28786
WAYNESVILLE: 828-454-8851 FAX: 828-424-4200 ASHEVILLE: 828-251-0380
MAIL@ARNENGINEERS.COM © 2006 WWW.ARNENGINEERS.COM

batson architects
Greenville Commons 220 N. Main Street, Suite 403 Greenville, South Carolina 29601 864.233.2222

POWER PLANT
QUAD 'D' QUAD 'A'
QUAD 'C' QUAD 'B'
KEY PLAN

CONFIDENTIAL: THESE DRAWINGS MUST BE RETURNED TO FACILITY MANAGEMENT SERVICE, PROJECT SECTION, UPON COMPLETION, OR UPON FINAL USE BY THE CONTRACTOR FOR BIDDING PURPOSES.

Office of Facilities
Department of Veterans Affairs



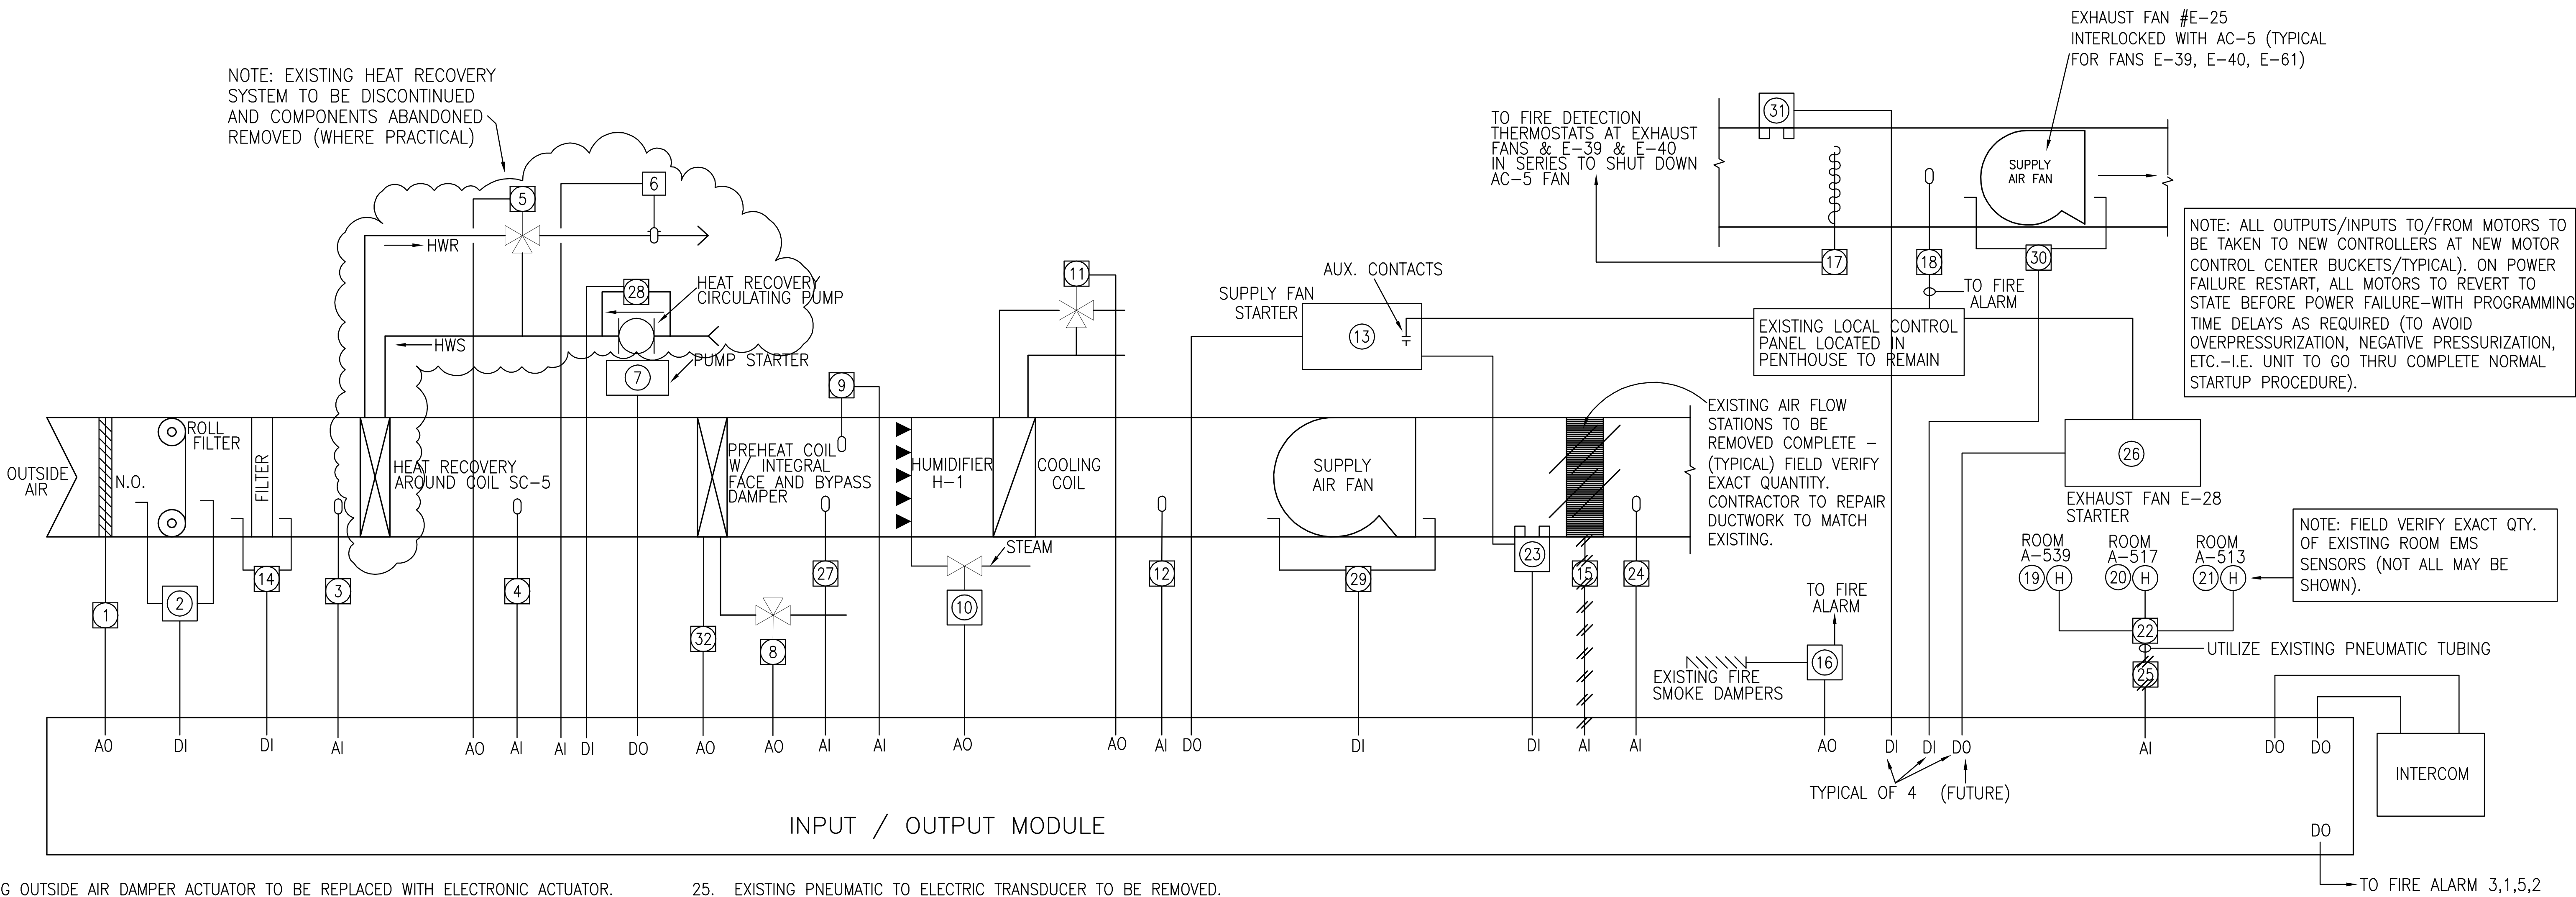


- EXISTING OUTSIDE AIR DAMPER ACTUATOR TO BE REPLACED WITH ELECTRONIC ACTUATOR.
- EXISTING DIFFERENTIAL PRESSURE SWITCH TO BE REPLACED.
- EXISTING TEMPERATURE SENSOR TO BE REPLACED WITH NEW.
- EXISTING TEMPERATURE SENSOR TO BE REPLACED WITH NEW.
- EXISTING HEAT RECOVERY 3-WAY (BY-PASS) VALVE TO BE REMOVED.
- EXISTING HEAT RECOVERY WATER LOOP TEMPERATURE SENSOR TO BE REMOVED.
- EXISTING HEAT RECOVERY CIRCULATING PUMP STARTER TO BE REMOVED.
- EXISTING STEAM VALVE ACTUATOR TO BE REPLACED WITH ELECTRONIC ACTUATOR.
- EXISTING NEW TEMPERATURE SENSOR TO BE REPLACED.
- EXISTING STEAM VALVE ACTUATOR TO BE REPLACED WITH ELECTRONIC ACTUATOR.
- EXISTING 3-WAY CHILLED WATER VALVE ACTUATOR TO BE REPLACED WITH ELECTRONIC ACTUATOR.
- EXISTING TEMPERATURE SENSOR TO BE REPLACED.
- EXISTING SUPPLY FAN STARTER TO REMAIN.
- EXISTING DIFFERENTIAL PRESSURE SWITCH TO BE REPLACED.
- EXISTING AIR FLOW SENSOR TO BE REMOVED.
- EXISTING FIRE DAMPER ACTUATOR TO REMAIN IN SERVICE.
- EXISTING FIRE DETECTION THERMOSTAT (TYPICAL OF 3) TO REMAIN IN SERVICE.
- EXISTING THERMOSTAT TO BE REPLACED.
- EXISTING ROOM HUMIDISTAT TO BE REPLACED.
- EXISTING ROOM HUMIDISTAT TO BE REPLACED.
- EXISTING ROOM HUMIDISTAT TO BE REPLACED.
- EXISTING 3 POINT AVERAGING RELAY TO BE REPLACED.
- EXISTING SMOKE DETECTOR TO REMAIN.
- EXISTING HUMIDITY SENSOR TO BE REPLACED.
- EXISTING PNEUMATIC TO ELECTRIC TRANSDUCER TO BE REMOVED.
- EXISTING EXHAUST FAN STARTER (TYPICAL OF 3) TO REMAIN IN SERVICE.
- EXISTING FREEZESTAT TO BE REPLACED.
- EXISTING DIFFERENTIAL PRESSURE SWITCH TO BE REMOVED.
- EXISTING DIFFERENTIAL PRESSURE SWITCH TO BE REPLACED.
- EXISTING DIFFERENTIAL PRESSURE SWITCH TO BE REPLACED.
- EXISTING SMOKE DETECTOR TO REMAIN (TYPICAL OF 4) (FUTURE).
- EXISTING BYPASS DAMPER ACTUATOR TO BE REPLACED WITH ELECTRONIC ACTUATOR.



GENERAL NOTE:


- Contractor shall field verify all dimensions.
- Schedule on site inspections with the project COTR.
- Contractor shall comply with OSHA, EPA, NFPA and all other applicable safety codes and regulations at all times.
- All work shall be performed by craftsmen who are journeymen of the trade in which they are performing work.
- Contractor superintendent shall report to the COTR each morning before work begins, at which the daily schedule shall be discussed.
- Contractor shall maintain dust control at all times. Contractor shall use "tidy mat" outside each work area and shall erect barriers to minimize dust/dirt, spreading/tracking to the greatest extent possible.
- All damages incurred to adjacent areas shall be repaired and restored to original condition by the contractor at no additional cost to the government.
- All materials removed shall become property of the contractor, to be disposed off site unless scheduled to be reinstalled or turned over to the VA.
- Contractor superintendent shall carry a pager and/or install a job site telephone. Furnish numbers to the project COTR upon contract award.
- Contractor shall schedule all utility interruptions with the project COTR at least forty-eight (48) hours in advance. Utility interruptions may require overtime work for all trades involved, and shall be provided by the contractor at no additional cost to the government.
- "Hot Work" permits are required. Notify the COTR twenty-four (24) hours prior to commencement of work.
- Manufacturers' trade names and numbers used herein identify a minimum standard. Subject to approval of the Contracting Officer, other products shall be considered, provided they are equivalent to these standards and meet the requirements of the technical specifications and drawings.

Revisions	Date

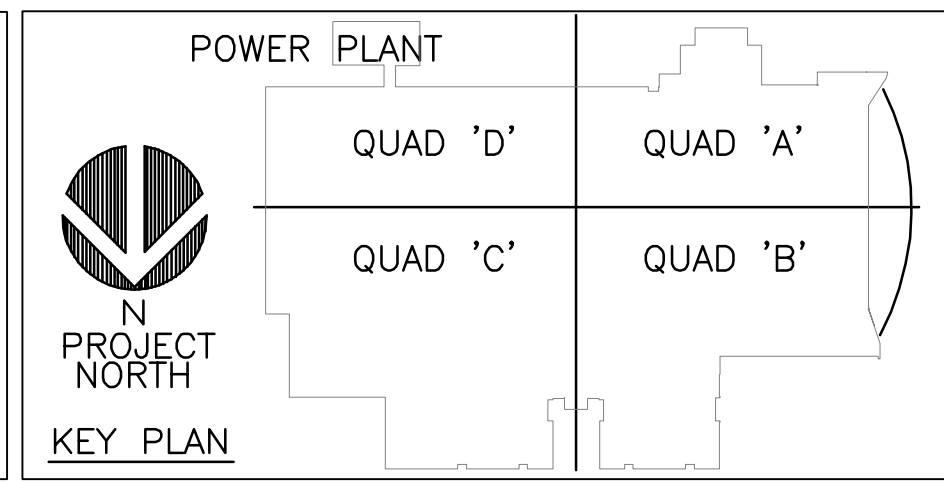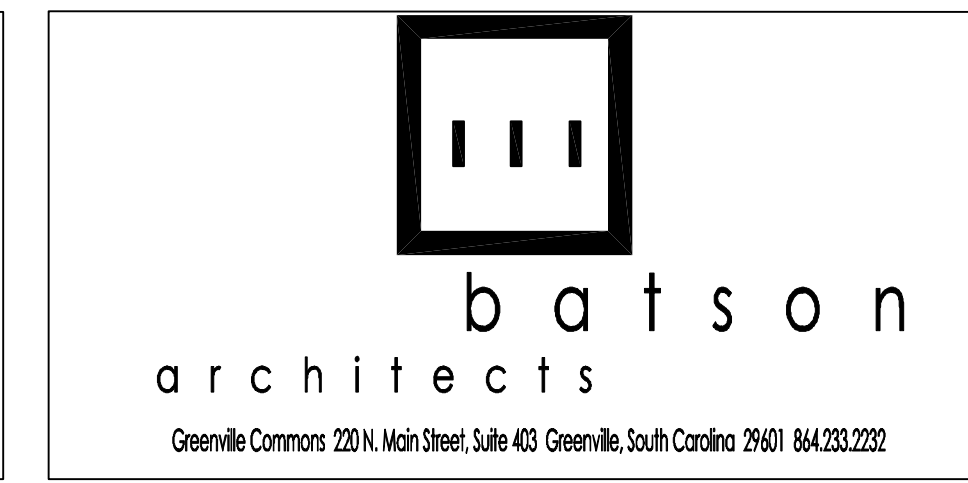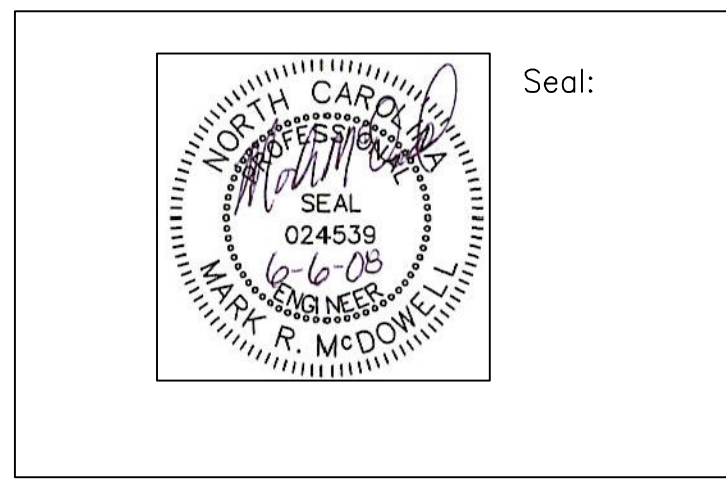

BUILDING IS FULLY SPRINKLERED		CONFIDENTIAL: THESE DRAWINGS MUST BE RETURNED TO FACILITY MANAGEMENT SERVICE, PROJECT SECTION UPON COMPLETION, OR UPON FINAL USE BY THE CONTRACTOR FOR BIDDING PURPOSES.	
BID DOCUMENTS		ARCHITECT PROJECT NO. 2007-30	
Drawing Title CONTROL DIAGRAM - A/C #5 BUILDING 47 - BASE BID		Date 03-13-08	
Approved By:		Project No. 637-08-103	
Note: Asbestos Containing Building Materials (ACBM) are present. Thermal Systems Insulation (TSI) and Miscellaneous ACBM are present in various locations.		Building Number 47	
Location ASHEVILLE, N.C.		Checked MPM	
		Drawn WTJ	
		DRAWING NO. M105	
		Dwg. 12 of 29	

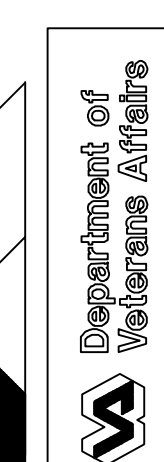

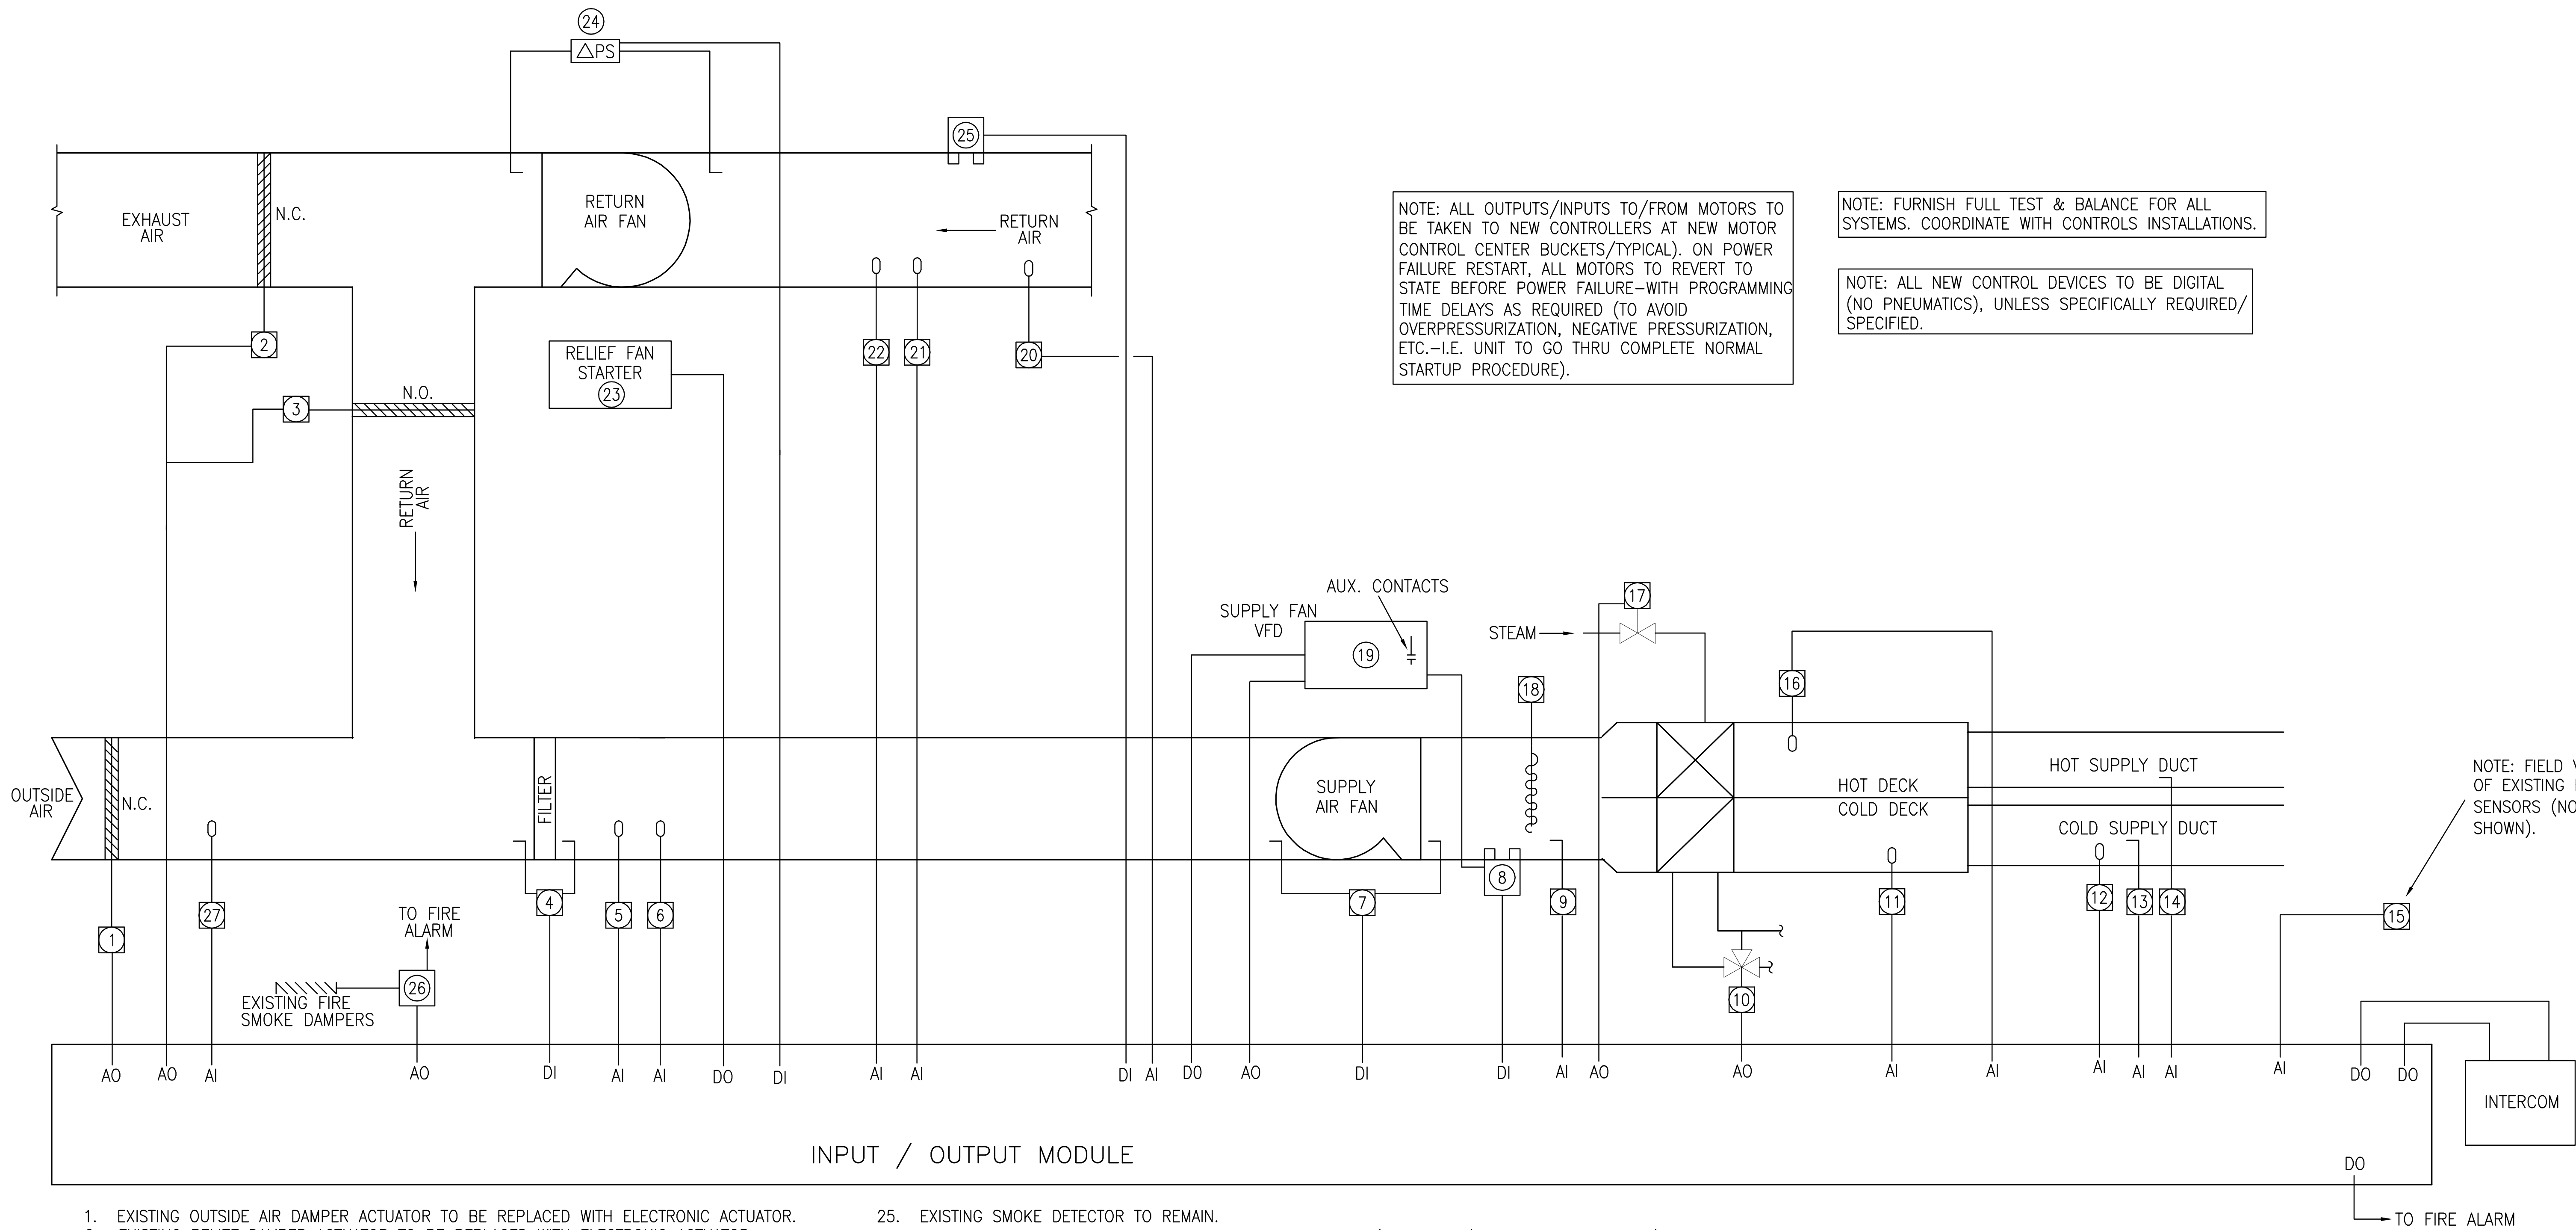



1. EXISTING OUTSIDE AIR DAMPER ACTUATOR TO BE REPLACED WITH ELECTRONIC ACTUATOR.
2. EXISTING RELIEF DAMPER ACTUATOR TO BE REPLACED WITH ELECTRONIC ACTUATOR.
3. EXISTING RETURN AIR DAMPER ACTUATOR TO BE REPLACED WITH ELECTRONIC ACTUATOR.
4. EXISTING DIFFERENTIAL PRESSURE SWITCH TO BE REPLACED.
5. EXISTING TEMPERATURE SENSOR TO BE REPLACED WITH NEW (MIXED AIR)
6. EXISTING DUCT HUMIDITY SENSOR (MIXED AIR) TO BE REPLACED WITH NEW.
7. EXISTING DIFFERENTIAL PRESSURE SWITCH TO BE REPLACED.
8. EXISTING SMOKE DETECTOR TO REMAIN.
9. REPLACE EXISTING DUCT STATIC PRESSURE SENSOR.
10. EXISTING 3-WAY CHILLED WATER VALVE ACTUATOR TO BE REPLACED WITH ELECTRONIC ACTUATOR.
11. EXISTING TEMPERATURE SENSOR TO BE REPLACED WITH NEW
12. EXISTING DUCT HUMIDITY SENSOR TO BE REPLACED (HIGH LIMIT).
13. REPLACE EXISTING DUCT STATIC PRESSURE SENSOR (FIELD VERIFY EXACT LOCATION).
14. REPLACE EXISTING DUCT STATIC PRESSURE SENSOR (FIELD VERIFY EXACT LOCATION)
15. EXISTING ROOM SENSOR TO BE REPLACED (FIELD VERIFY EXACT QTY. / LOCATION)
16. EXISTING TEMPERATURE SENSOR TO BE REPLACED WITH NEW
17. EXISTING N.C. STEAM VALVE PNEUMATIC ACTUATOR TO BE REPLACED WITH NEW ELECTRONIC ACTUATOR.
18. EXISTING FREEZE PROTECTION THERMOSTAT TO BE REPLACED WITH NEW.
19. EXISTING SUPPLY FAN VFD TO REMAIN (START / STOP & FAN SPEED VIA EMS).
20. EXISTING HUMIDITY SENSOR TO BE REPLACED.
21. EXISTING DUCT TEMPERATURE SENSOR TO BE REPLACED (R/A).
22. EXISTING DUCT ENTHALPY SENSOR TO BE REPLACED.
23. EXISTING RELIEF FAN STARTER TO REMAIN.
24. EXISTING DIFFERENTIAL PRESSURE SWITCH TO BE REPLACED.
25. EXISTING SMOKE DETECTOR TO REMAIN.
26. EXISTING FIRE DAMPER ACTUATORS TO REMAIN IN SERVICE (FURNISH E/P RELAYS AS REQUIRED).
27. EXISTING DUCT TEMPERATURE SENSOR TO BE REPLACED (O/A).

NOTE: FURNISH NEW CONTROL DEVICES, CONTROLLERS, CONTROL WIRING/ CONDUIT, REPROGRAMMING, ETC...


GENERAL NOTE:


1. Contractor shall field verify all dimensions.
2. Schedule on site inspections with the project COTR.
3. Contractor shall comply with OSHA, EPA, NFPA and all other applicable safety codes and regulations at all times.
4. All work shall be performed by craftsmen who are journeymen of the trade in which they are performing work.
5. Contractor superintendent shall report to the COTR each morning before work begins, at which the daily schedule shall be discussed.
6. Contractor shall maintain dust control at all times. Contractor shall use "tidy mat" outside each work area and shall erect barriers to minimize dust/dirt, spreading/tracking to the greatest extent possible.
7. Contractor to maintain the job site in a neat and orderly fashion at all times. Corridors shall be kept clear of all debris and obstructions to allow safe passage for employees, visitors, visitors and workers. Dispose of all trash and discarded materials and maintain storage within the confines of the job site or other approved areas.
8. All damages incurred to adjacent areas shall be repaired and returned to original condition by the contractor at no additional cost to the government.
9. All materials removed shall become property of the contractor, to be disposed off site unless scheduled to be reinstalled or turned over to the VA.
10. Contractor superintendent shall carry a pager and/or install a job site telephone. Furnish numbers to the project COTR upon contract award.
11. Contractor shall schedule all utility interruptions with the project COTR at least forty-eight (48) hours in advance. Utility interruptions may require overtime work for all trades involved, and shall be provided by the contractor at no additional cost to the government.
12. "Hot Work" permits are required. Notify the COTR twenty-four (24) hours prior to commencement of work.
13. Manufacturers' trade names and numbers used herein identify a minimum standard. Subject to approval of the Contracting Officer, other products shall be considered, provided they are equivalent to these standards and meet the requirements of the technical specifications and drawings.

Revisions	Date

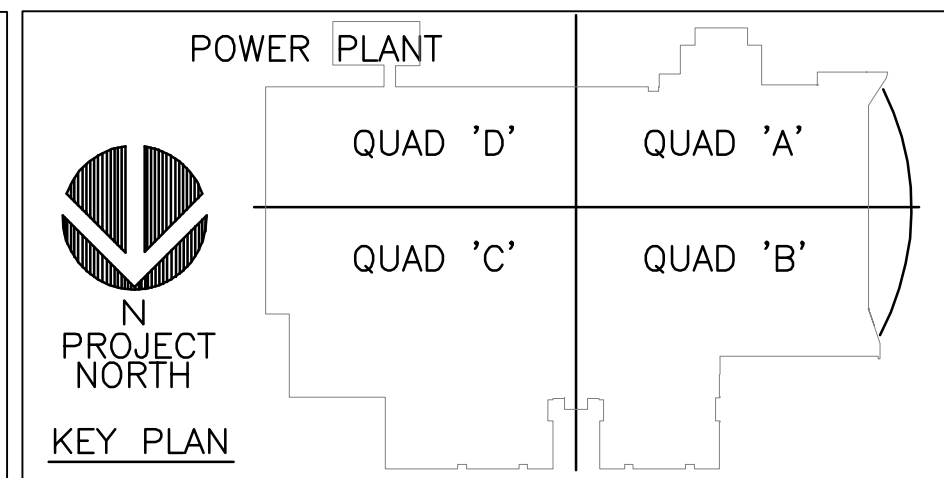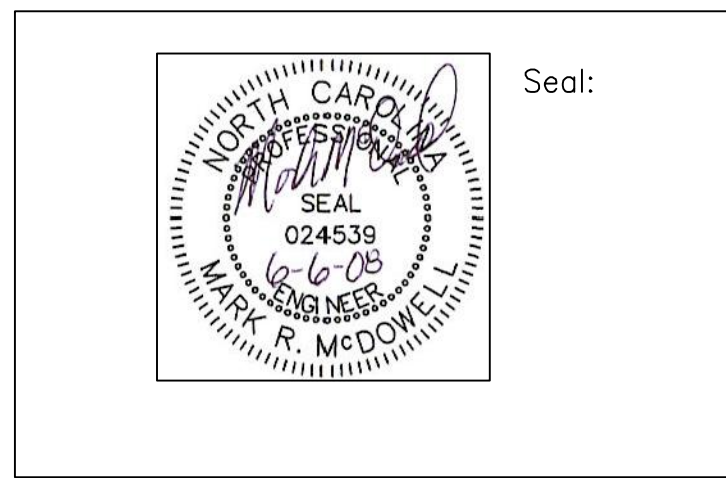


BUILDING IS FULLY SPRINKLERED		CONFIDENTIAL: THESE DRAWINGS MUST BE RETURNED TO FACILITY MANAGEMENT SERVICE, PROJECT SECTION UPON COMPLETION, OR UPON FINAL USE BY THE CONTRACTOR FOR BIDDING PURPOSES.	
BID DOCUMENTS		ARCHITECT PROJECT NO. 2007-30	
Drawing Title CONTROL DIAGRAM - A/C #7 BUILDING 47 - BASE BID		Date 03-13-08	
Approved By:		Project No. 637-08-103	
Note: Asbestos Containing Building Materials (ACBM) are present. Thermal Systems Insulation (TSI) and Miscellaneous ACBM are present in various locations.		Building Number 47	
Location ASHEVILLE, N.C.		Checked MPM	
		Drawn WTJ	
		DRAWING NO. M107	
		Dwg. 14 of 29	

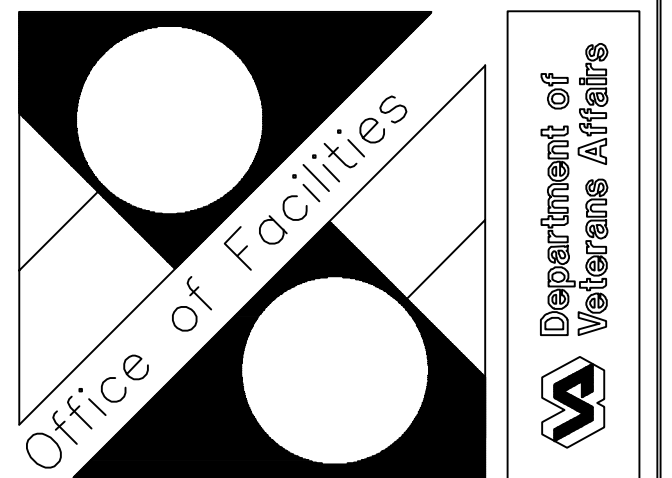

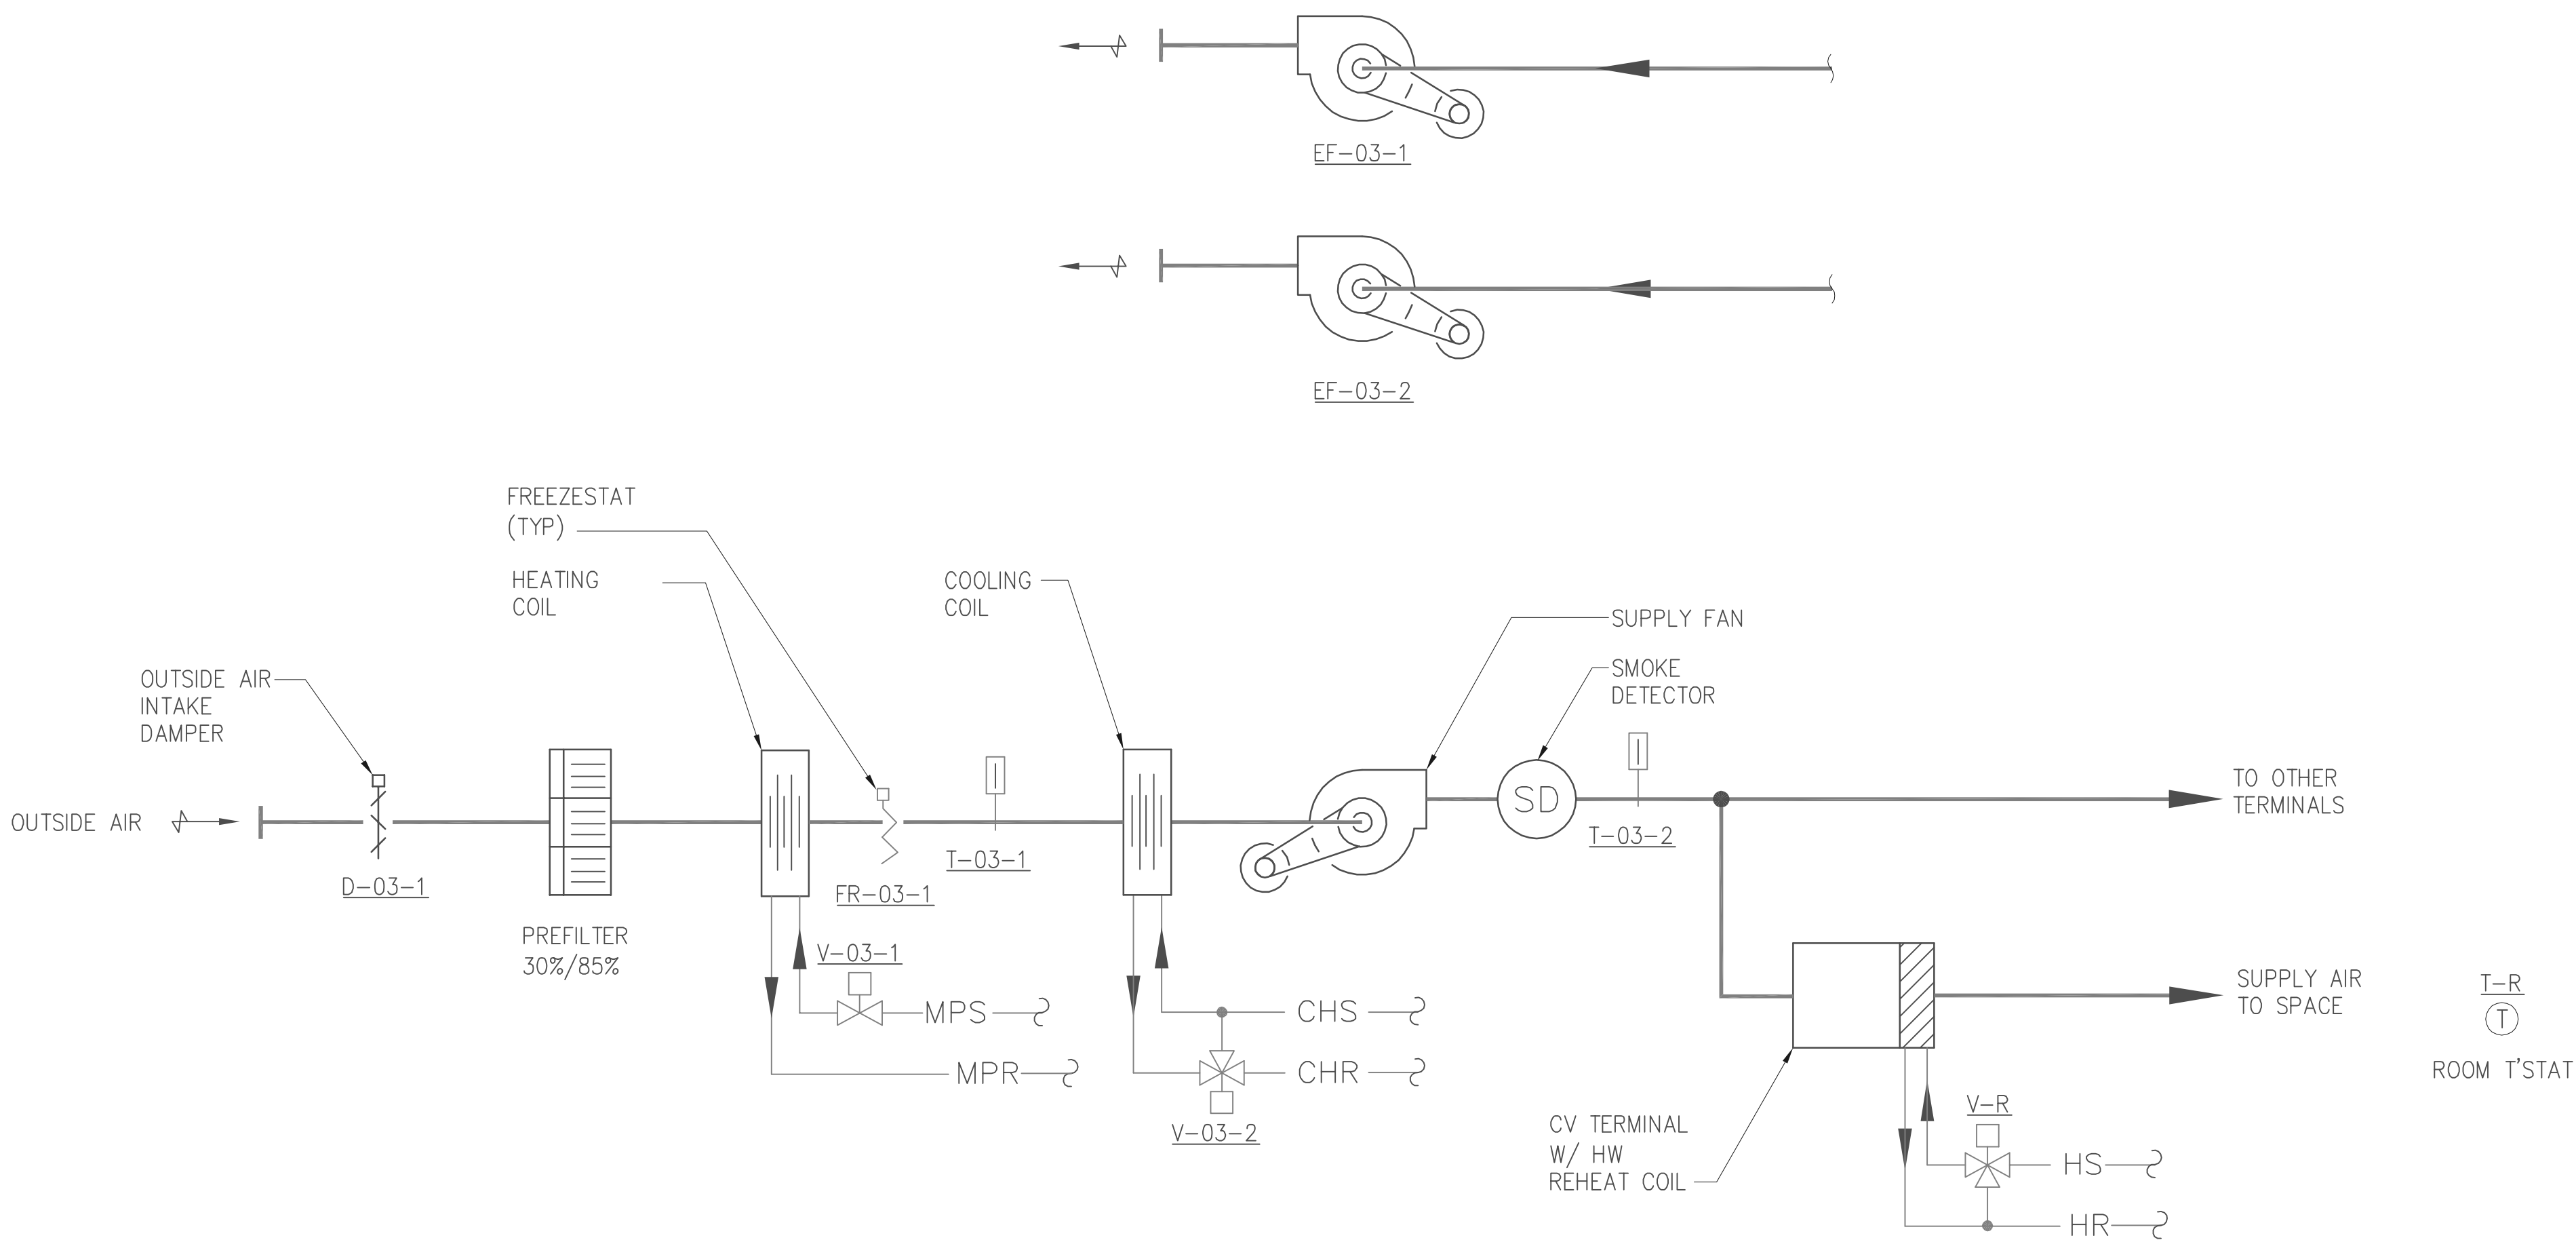

EXISTING A/C #8 CONTROL DIAGRAM

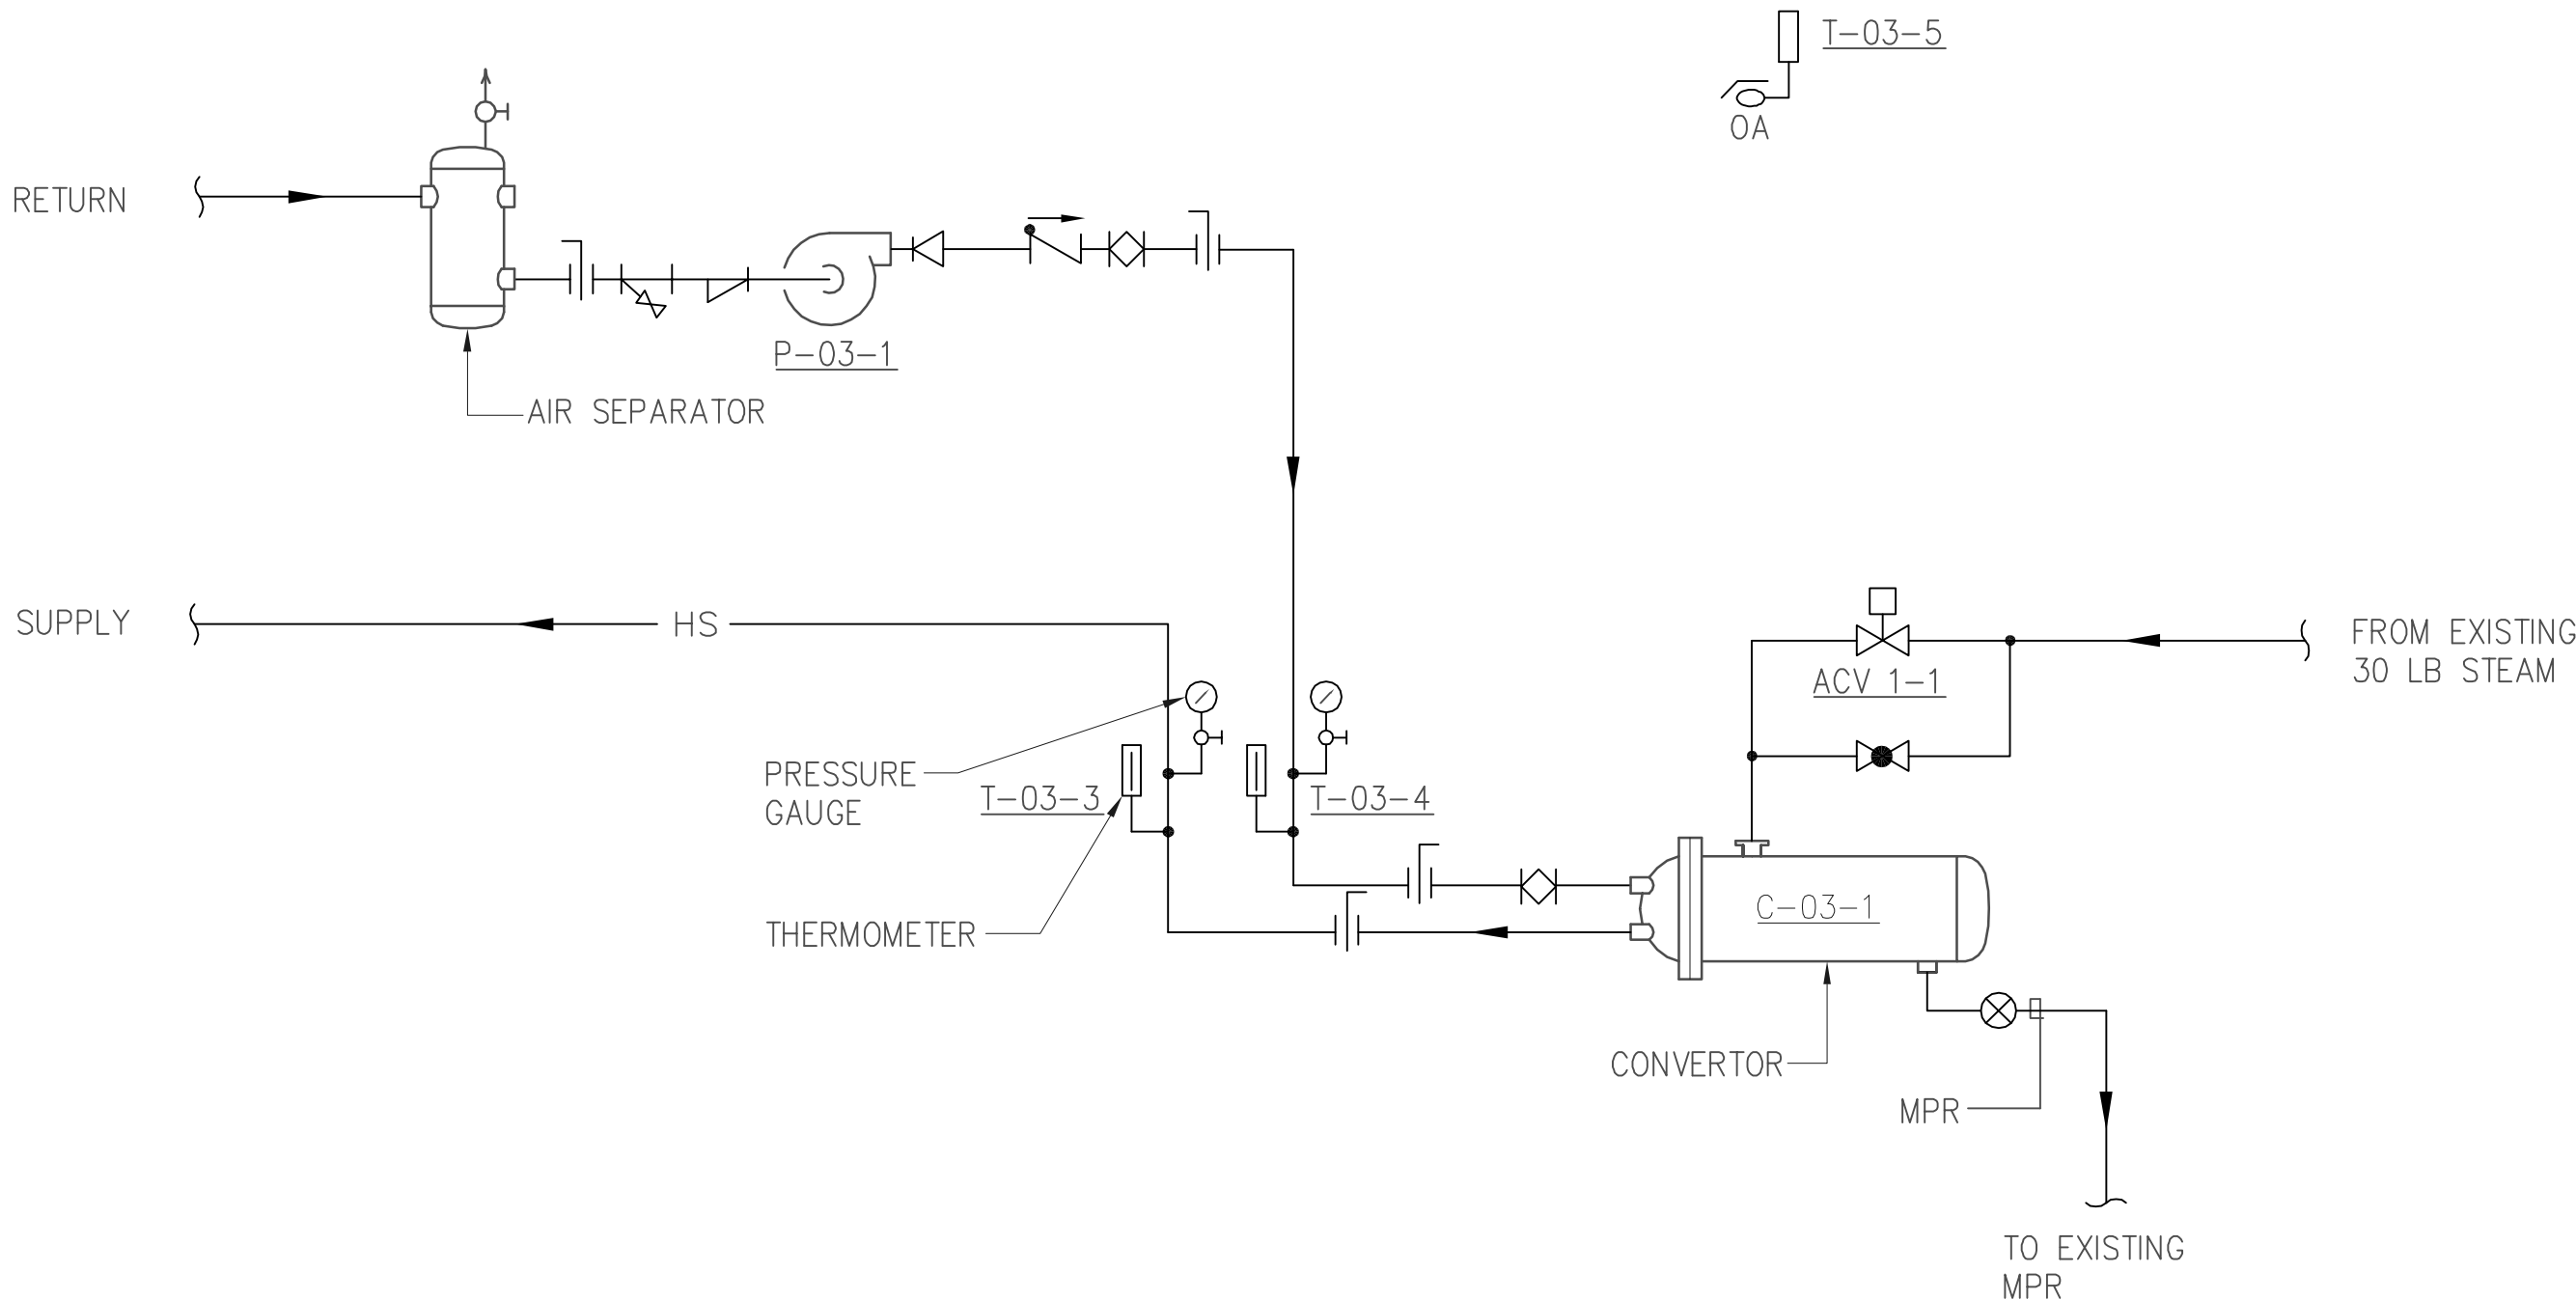

EXISTING STEAM TO HOT WATER CONVERTOR
CONTROL DIAGRAM

COORDINATE EXACT LOCATION FOR EQUIPMENT

NOTE: EXISTING CONTROL DEVICES TO REMAIN, UNLESS PNEUMATIC. REPLACE ALL PNEUMATIC OPERATORS, ACTUATORS, AND CONTROL DEVICES WITH ELECTRONIC. EXISTING CONTROL WIRING, PROGRAMMING, ETC. TO REMAIN WHERE PRACTICAL / POSSIBLE.

EXISTING INPUT/OUTPUT SUMMARY																																															
CODE: A - ANALOG B - BINARY X - FUNCTION REQUIRED * - REFER TO NOTES BELOW		CONTROL - OUTPUT						INDICATION - INPUT						SOFTWARE FUNCTION						REMARKS																											
		DEVICE			VARIABLE									PROGRAM																																	
		MOTOR	VALVE	DAMPER	VAR FREQ DRIVE	TEMPERATURE	HUMIDITY	PRESSURE	FLOW	LEVEL	TEMPERATURE	HUMIDITY	PRESSURE	STATIC PRESSURE	DIFF PRESSURE	FLOW	CONTACT	KILOWATT	KVA AND KVAR		POWER FACTOR	STATUS	ALARM	START-STOP	LEAD-LAG	S/S OPTIMIZATION	TREND	TOTALIZATION	ENERGY UNITS	SYSTEM GRAPHIC																	
SYSTEM	POINT DESCRIPTION																																														
A/C #8	SUPPLY FAN																			B																				X							
	EF-03-1																			B																											
	EF-03-2																			B																											
	DAMPER D-03-1																																														
	VALVE V-03-1																				A																										
	VALVE V-03-2																				A																										
	FREEZESTAT FR-03-1																							A																							
	TEMP SENSOR T-03-1																							A				A																			
	TEMP SENSOR T-03-2																							A				A																			
	TEMP SENSOR T-R																							A				A																			
	VALVE V-R																				A																										
C-03-1	PUMP P-03-1																			B																									X		
	TEMP SENSOR T-03-3																							A				A																			
	TEMP SENSOR T-03-4																							A				A																			
	TEMP SENSOR T-03-5																							A				A																			
	VALVE ACV-1-1																				A																										
NOTES:																																															

EXISTING SEQUENCE OF OPERATION

The CCMS shall determine the "Occupied and Unoccupied" modes of operation on a pre-determined schedule.

"Occupied Mode" - The Air Handling unit AC-8 shall start and the outside air damper D-03-1 shall open. Exhaust fans EF-03-1, EF-03-2 and the existing ETO Sterilizer exhaust fan, shall start subject to the fire alarm system and the freezestat FR-03-1. Discharge air temperature shall be maintained at 53 degrees F (adjustable) by discharge air temperature transmitter T-03-1 which shall modulate the NO steam valve V-03-1 on the preheat coil and the cooling coil valve V-03-1 in sequence.

Space temperature shall be maintained by space temperature transmitters T-R which shall modulate the 3-way hot water valves V-R on the constant volume reheat boxes.

When Air Handling unit AC-8 is operating, Hot Water Pump P-03-1 shall start and energize the controls for the hot water convertor C-03-1.

Hot water supply temperature shall be reset inversely as the outside air temperature by transmitters T-03-3 and T-03-5. Temperature transmitter T-03-3 shall modulate the steam valve ACV-1-1 on the hot water convertor C-03-1.

NOTE: ALL OUTPUTS/INPUTS TO/FROM MOTORS TO BE TAKEN TO NEW CONTROLLERS AT NEW MOTOR CONTROL CENTER BUCKETS/TYPICAL). ON POWER FAILURE RESTART, ALL MOTORS TO REVERT TO STATE BEFORE POWER FAILURE-WITH PROGRAMMING TIME DELAYS AS REQUIRED (TO AVOID OVERPRESSURIZATION, NEGATIVE PRESSURIZATION, ETC.-I.E. UNIT TO GO THRU COMPLETE NORMAL STARTUP PROCEDURE).

NOTE: FURNISH FULL TEST & BALANCE FOR ALL SYSTEMS. COORDINATE WITH CONTROLS INSTALLATIONS.

NOTE: ALL NEW CONTROL DEVICES TO BE DIGITAL (NO PNEUMATICS), UNLESS SPECIFICALLY REQUIRED/SPECIFIED.

GENERAL NOTE:

- Contractor shall field verify all dimensions.
- Schedule on site inspections with the project COTR.
- Contractor shall comply with OSHA, EPA, NFPA and all other applicable safety codes and regulations at all times.
- All work shall be performed by craftsmen who are journeymen of the trade in which they are performing work.
- Contractor superintendent shall report to the COTR each morning before work begins, at which the daily schedule shall be discussed.
- Contractor shall maintain dust control at all times. Contractor shall use "tidy mats" outside each work area and shall erect barriers to minimize dust/dirt, spreading/tracking to the greatest extent possible.
- All damage incurred to adjacent areas shall be repaired and restored to original condition by the contractor at no additional cost to the government.
- Contractor to maintain the job site in a neat and orderly fashion at all times. Corridors shall be kept clean of all debris and obstructions to allow safe passage for employees, visitors, visitors and workers. Dispose of all trash and discarded materials and maintain storage within the confines of the job site or other approved areas.
- All materials removed shall become property of the contractor, to be disposed off site unless scheduled to be reinstalled or turned over to the VA.
- Contractor superintendent shall carry a pager and/or install a job site telephone. Furnish numbers to the project COTR upon contract award.
- Contractor shall schedule all utility interruptions with the project COTR at least forty-eight (48) hours in advance. Utility interruptions may require overtime work for all trades involved, and shall be provided by the contractor at no additional cost to the government.
- "Hot Work" permits are required. Notify the COTR twenty-four (24) hours prior to commencement of work.
- Manufacturers' trade names and numbers used herein identify a minimum standard. Subject to approval of the Contracting Officer, other products may be considered, provided they are equivalent to these standards and meet the requirements of the technical specifications and drawings.

BUILDING IS FULLY SPRINKLERED

BID DOCUMENTS		ARCHITECT PROJECT NO. 2007-30	
Drawing Title CONTROL DIAGRAM - A/C #8 BUILDING 47 - BASE BID		Date 03-13-08	
Approved By:		Project No. 637-08-103	
Note: Asbestos Containing Building Materials (ACBM) are present. Thermal Systems Insulation (TSI) and Miscellaneous ACBM are present in various locations.		Drawing NO. M108	
Location ASHEVILLE, N.C.		Dwg. 13 of 29	

<p>Revisions</p>	<p>Date</p>
------------------	-------------

Seal:


POWER PLANT

QUAD 'D'	QUAD 'A'
QUAD 'C'	QUAD 'B'

KEY PLAN

CONFIDENTIAL: THESE DRAWINGS MUST BE RETURNED TO FACILITY MANAGEMENT SERVICE, PROJECT SECTION, UPON COMPLETION, OR UPON FINAL USE BY THE CONTRACTOR FOR BIDDING PURPOSES.

- KEYED NOTES
- (A) EXISTING MOTOR CONTROL CENTER "MCC-AN"
 - (B) EXISTING "AC-1"
 - (C) EXISTING MOTOR CONTROL CENTER "MCC-AE"
 - (D) EXISTING 1000KW GENERATOR
 - (E) (NOT USED)
 - (F) EXISTING 1000KVA TRANSFORMER STATIONS, 12,470V/480-277V
 - (G) EXISTING PANEL "EQ1" 800A MLO, 277/480V, EQUIPMENT BRANCH
 - (H) EXISTING PANEL "EQ2" 800A MLO, 277/480V, EQUIPMENT BRANCH
 - (I) EXISTING PANEL "C1" 800A MLO, 277/480V, CRITICAL BRANCH
 - (J) EXISTING PANEL "LS1" 400A MLO, 277/480V, LIFE SAFETY BRANCH
 - (K) EXISTING "GSI"
 - (L) EXISTING ATS EQ1
 - (M) EXISTING ATS EQ2
 - (N) EXISTING ATS C1
 - (O) EXISTING ATS LS1
 - (P) EXISTING DISTRIBUTION PANEL "DS1"
 - (Q) EXISTING DISTRIBUTION PANEL "DS2"
 - (R) EXISTING MAIN SERVICE GROUNDING TERMINAL BOX
 - (S) EXISTING TRANSFORMER "TSC"
 - (T) EXISTING PANEL "SCL"
 - (U) EXISTING 480V SWITCHGEAR "DB0A1"
 - (V) EXISTING "AC-2"
 - (W) EXISTING STEAM TO HOT WATER CONVERTOR #3
 - (X) EXISTING EMS SYSTEM OPERATOR WORKSTATION

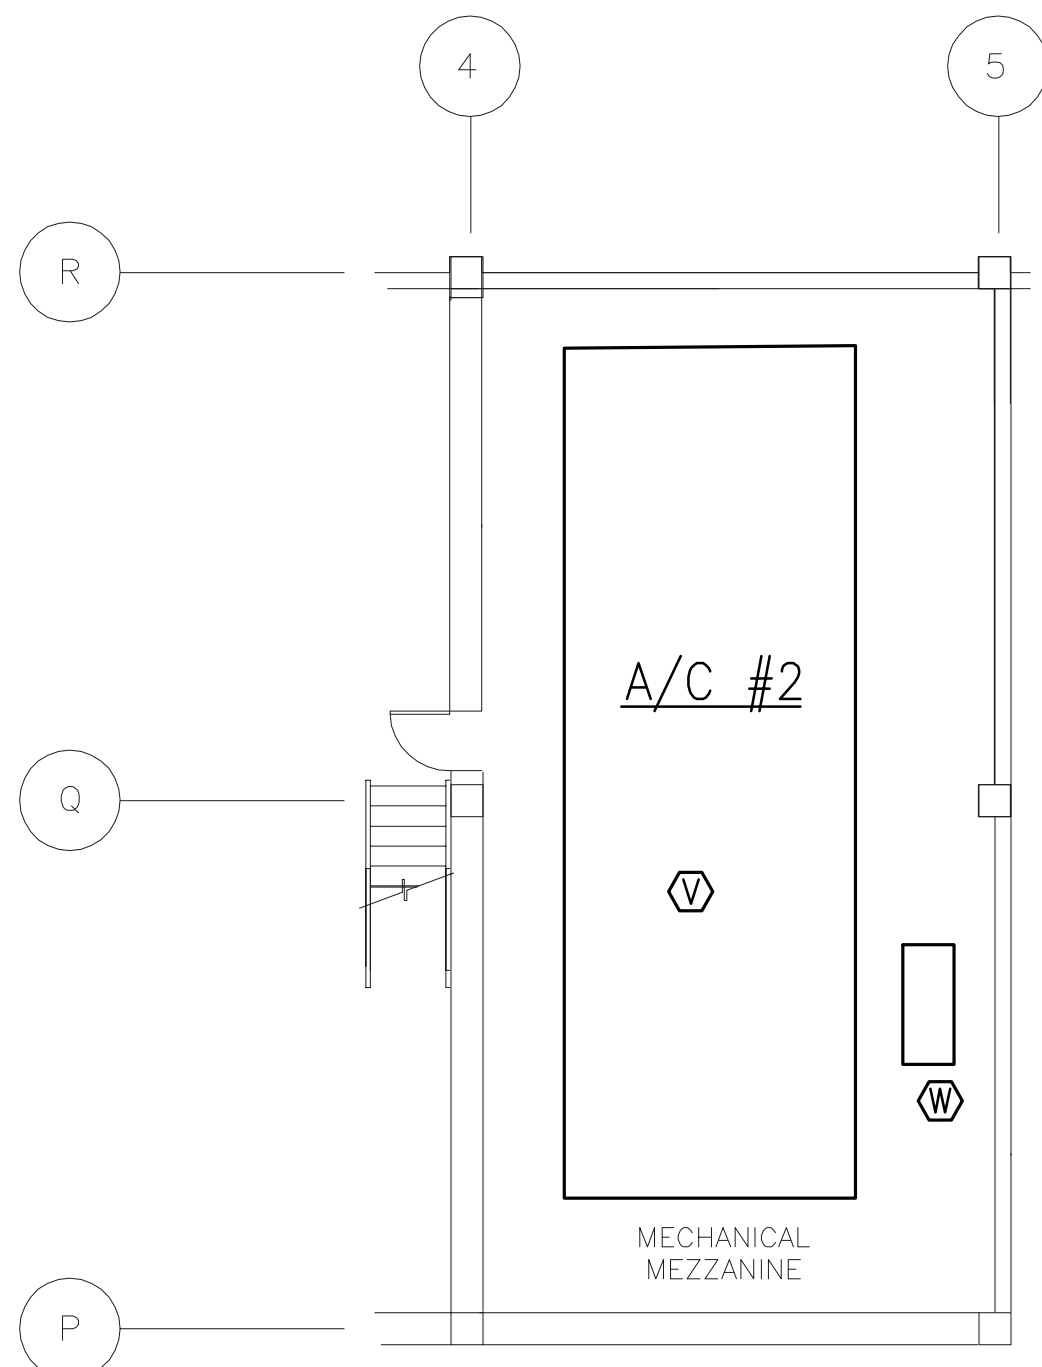

LARGE SCALE BASEMENT MECHANICAL PLAN
1/8" = 1'-0"

LARGE SCALE BASEMENT MECHANICAL MEZZANINE PLAN
1/4" = 1'-0"

GENERAL NOTE:

1. Contractor shall field verify all dimensions.
2. Schedule on site inspections with the project COTR.
3. Contractor shall comply with OSHA, EPA, NFPA and all other applicable safety codes and regulations at all times.
4. All work shall be performed by craftsmen who are journeymen of the trade in which they are performing work.

5. Contractor superintendent shall report to the COTR each morning before work begins, at which the daily schedule shall be discussed.
6. Contractor shall maintain dust control at all times. Contractor shall use "sticky mats" outside each work area and shall erect barriers to minimize dust/dirt, spreading/tracking to the greatest extent possible.
7. Contractor to maintain the job site in a neat and orderly fashion at all times. Corridors shall be kept clean of all debris and obstructions to allow safe passage for employees, patients, visitors and workers. Dispose of all trash and discarded materials and maintain storage within the confines of the job site or other approved areas.
8. All damages incurred to adjacent areas shall be repaired and returned to original condition by the contractor at no additional cost to the government.

9. All materials removed shall become property of the contractor, to be disposed off site unless scheduled to be reinstalled or turned over to the VA.
10. Contractor superintendent shall carry a pager and/or install a job site telephone. Furnish numbers to the project COTR upon contract award.
11. Contractor shall schedule all utility interruptions with the project COTR at least forty-eight (48) hours in advance. Utility interruptions may require overtime work for all trades involved, and shall be provided by the contractor at no additional cost to the government.
12. "Hot Work" permits are required. Notify the COTR twenty-four (24) hours prior to commencement of work.

13. Manufacturers' trade names and numbers used herein identify a minimum standard. Subject to approval of the Contracting Officer, other products shall be considered, provided they are equivalent to these standards and meet the requirements of the technical specifications and drawings.

BUILDING IS FULLY SPRINKLERED

<p>Revisions</p>		<p>Date</p>	<p>Seal:</p>	<p>Reece, Noland & McElrath, Inc.</p>	<p>batson architects</p>	<p>POWER PLANT</p>	<p>QUAD 'D' QUAD 'A'</p>	<p>QUAD 'C' QUAD 'B'</p>	<p>KEY PLAN</p>	<p>BID DOCUMENTS</p>	<p>ARCHITECT PROJECT NO. 2007-30</p>	<p>Date 03-13-08</p>	<p>Project No. 637-08-103</p>	<p>DRAWING NO. M109</p>	<p>Dwg. 16 of 29</p>
<p>Revisions</p>		<p>Date</p>	<p>Seal:</p>	<p>Reece, Noland & McElrath, Inc.</p>	<p>batson architects</p>	<p>POWER PLANT</p>	<p>QUAD 'D' QUAD 'A'</p>	<p>QUAD 'C' QUAD 'B'</p>	<p>KEY PLAN</p>	<p>LARGE SCALE BASEMENT MECHANICAL ROOM & MEZZANINE PLANS BUILDING 47 - BASE BID</p>	<p>VA MEDICAL CENTER REPLACE HVAC CONTROLS</p>	<p>03-13-08</p>	<p>637-08-103</p>	<p>M109</p>	<p>Dwg. 16 of 29</p>
<p>Revisions</p>		<p>Date</p>	<p>Seal:</p>	<p>Reece, Noland & McElrath, Inc.</p>	<p>batson architects</p>	<p>POWER PLANT</p>	<p>QUAD 'D' QUAD 'A'</p>	<p>QUAD 'C' QUAD 'B'</p>	<p>KEY PLAN</p>	<p>Approved By:</p>	<p>Building Number 47</p>	<p>Checked MFM</p>	<p>Drawn WTJ</p>	<p>ASHEVILLE, N.C.</p>	<p>Office of Facilities</p>
<p>Revisions</p>		<p>Date</p>	<p>Seal:</p>	<p>Reece, Noland & McElrath, Inc.</p>	<p>batson architects</p>	<p>POWER PLANT</p>	<p>QUAD 'D' QUAD 'A'</p>	<p>QUAD 'C' QUAD 'B'</p>	<p>KEY PLAN</p>	<p>Note: Asbestos Containing Building Materials (ACBM) are present. Thermal Systems Insulation (TSI) and Miscellaneous ACBM are present in various locations.</p>	<p>Location</p>	<p>ASHEVILLE, N.C.</p>	<p>ASHEVILLE, N.C.</p>	<p>ASHEVILLE, N.C.</p>	<p>ASHEVILLE, N.C.</p>

A
B
C
D
E
F

KEYED NOTES

A



EXISTING "H/V--1"

B

EXISTING "AC--3"



C

EXISTING "H/V--2"

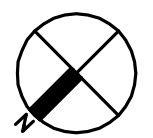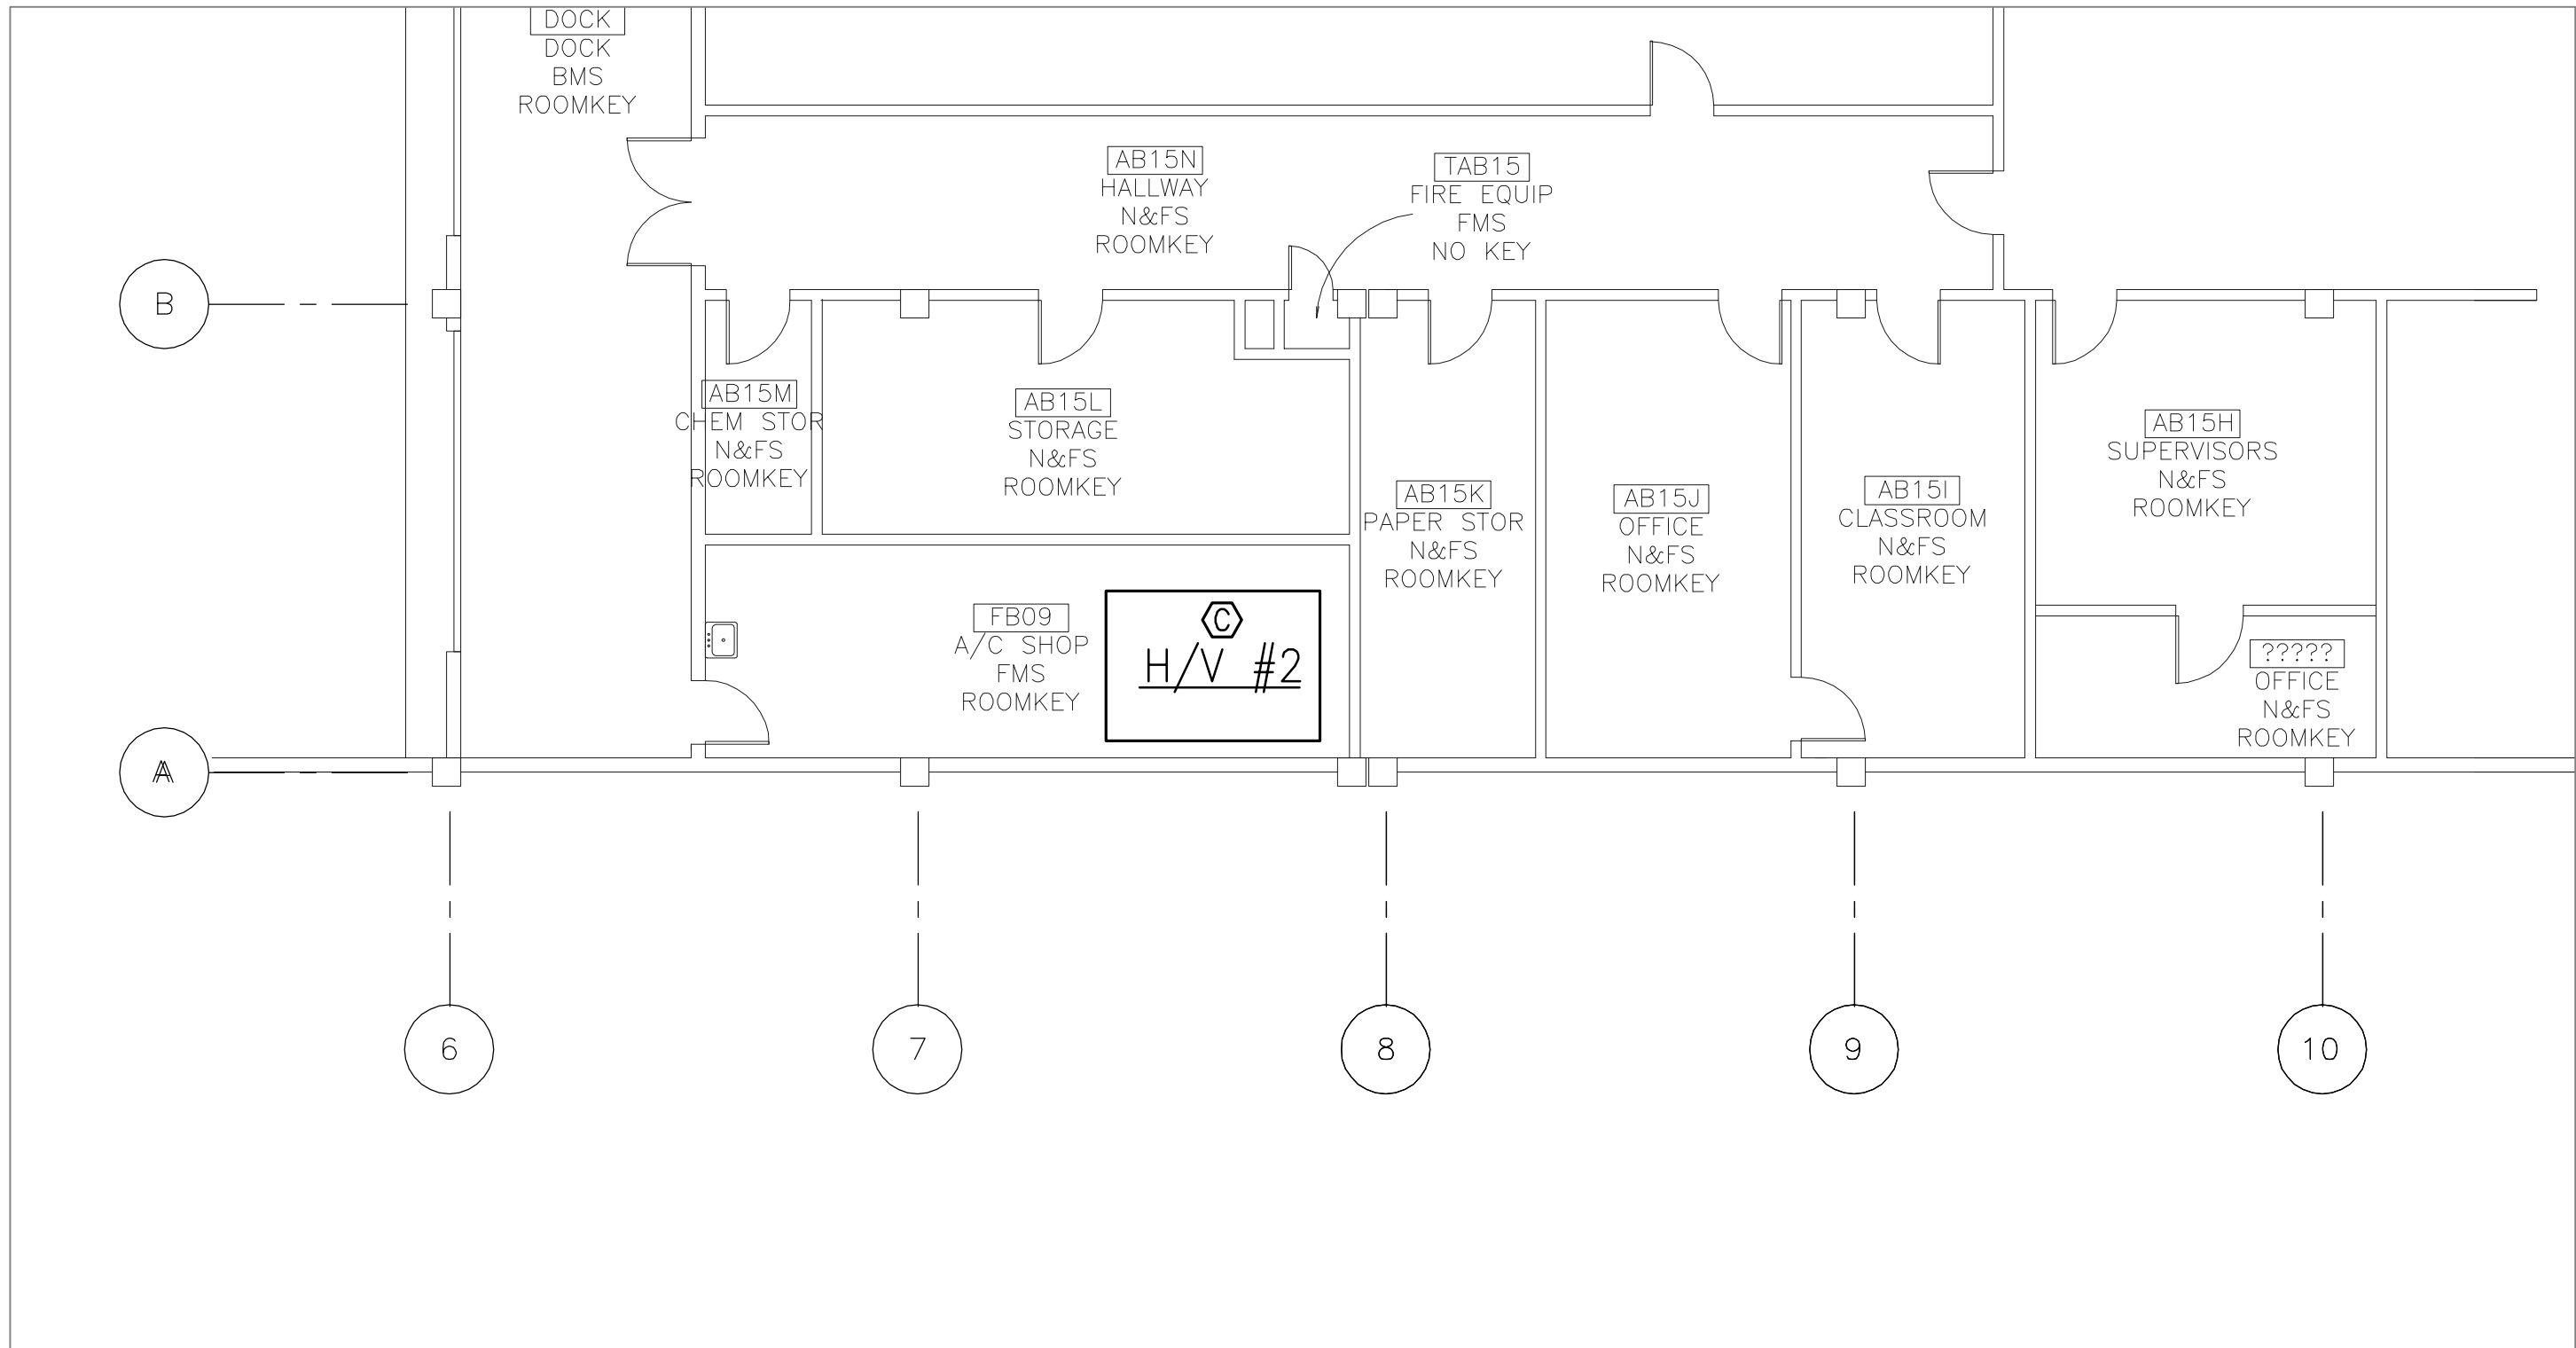

BASEMENT MECHANICAL PLAN

1/8" = 1'

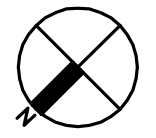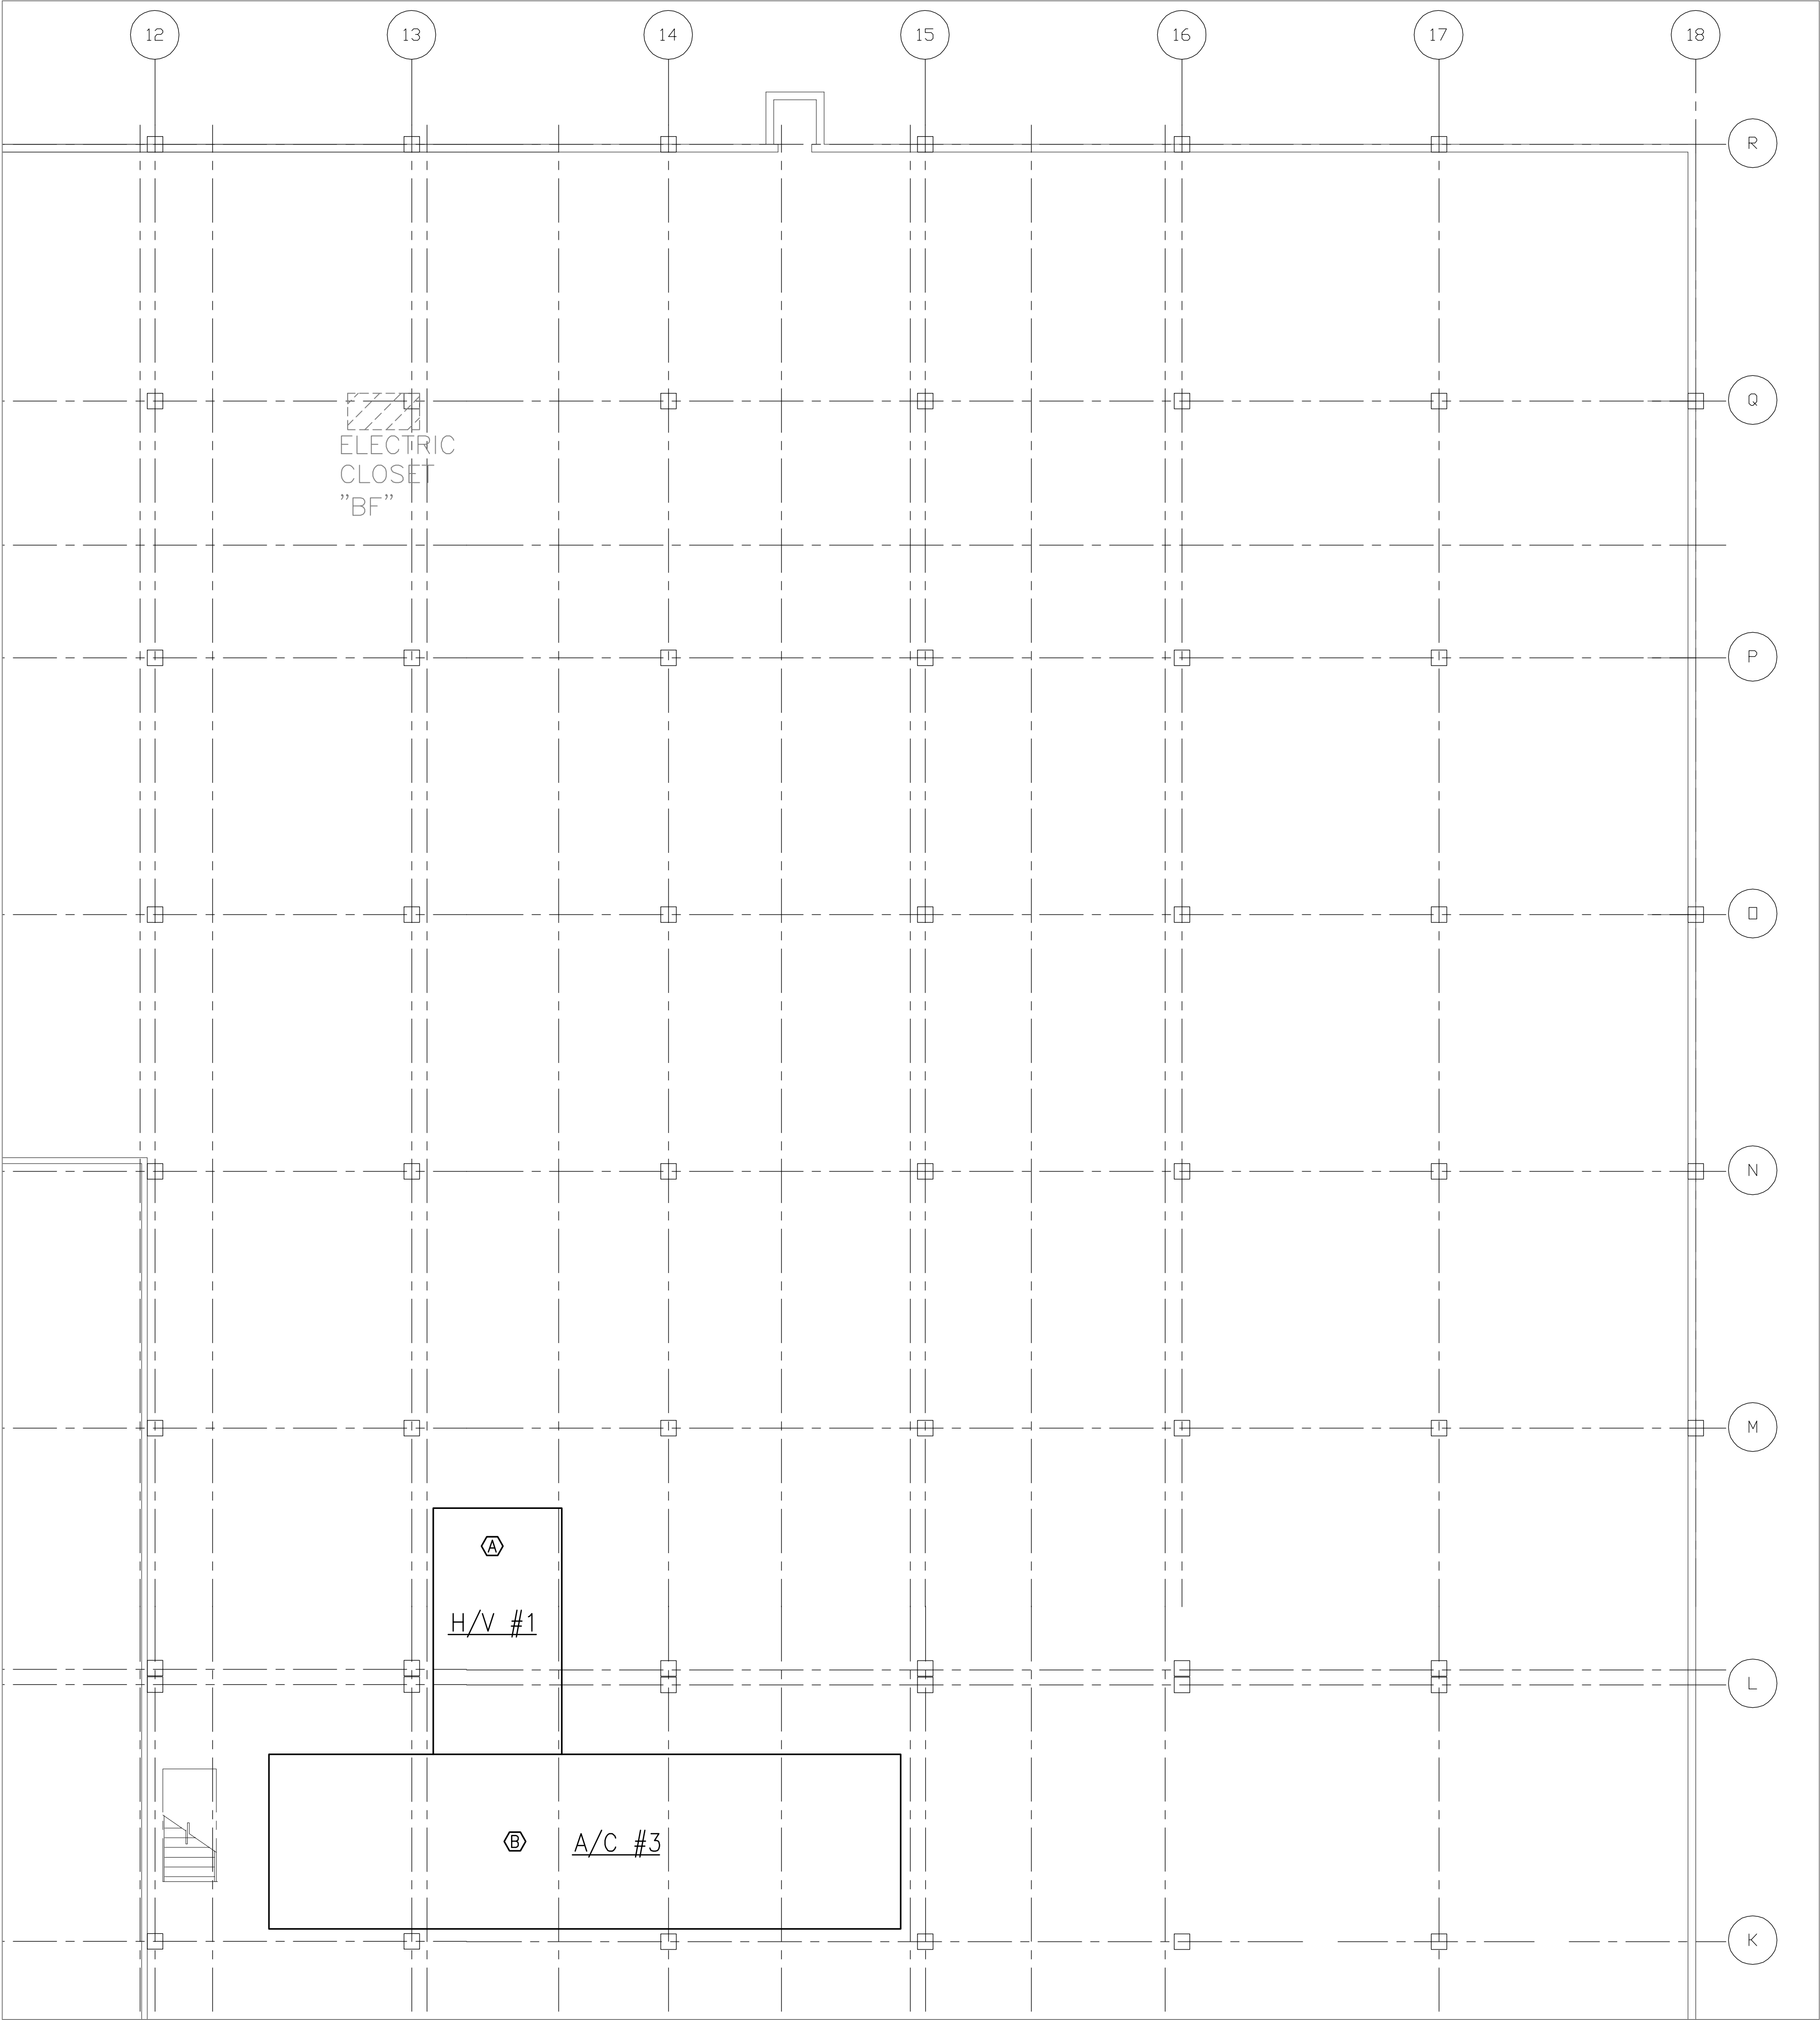

CRAWL SPACE MECHANICAL PLAN

1/8" = 1'

GENERAL NOTE:

- Contractor shall field verify all dimensions.
- Schedule on site inspections with the project COTR.
- Contractor shall comply with OSHA, EPA, NFPA and all other applicable safety codes and regulations at all times.
- All work shall be performed by craftsmen who are journeymen of the trade in which they are performing work.

- Contractor superintendent shall report to the COTR each morning before work begins, at which the daily schedule shall be discussed.
- Contractor shall maintain dust control at all times. Contractor shall use "sticky mats" outside each work area and shall erect barriers to minimize dust/dirt, spreading/tracking to the greatest extent possible.
- Contractor shall maintain the job site in a neat and orderly fashion at all times. Corridors shall be kept clean of all debris and obstructions to allow safe passage for employees, patients, visitors and workers. Dispose of all trash and discarded materials and maintain storage within the confines of the job site or other approved areas.
- All damages incurred to adjacent areas shall be repaired and restored to original condition by the contractor at no additional cost to the government.

- All materials removed shall become property of the contractor, to be disposed off site unless scheduled to be reinstalled or turned over to the VA.
- Contractor superintendent shall carry a pager and/or install a job site telephone. Furnish numbers to the project COTR upon contract award.
- Contractor shall schedule all utility interruptions with the project COTR at least forty-eight (48) hours in advance. Utility interruptions may require overtime work for all trades involved, and shall be provided by the contractor at no additional cost to the government.
- "Hot Work" permits are required. Notify the COTR twenty-four (24) hours prior to commencement of work.

- Manufacturers' trade names and numbers used herein identify a minimum standard. Subject to approval of the Contracting Officer, other products shall be considered, provided they are equivalent to these standards and meet the requirements of the technical specifications and drawings.

BUILDING IS FULLY SPRINKLERED

BID DOCUMENTS

Drawing Title
**BASEMENT AND CRAWL SPACE
MECHANICAL PLANS
BUILDING 47 - BASE BID**

Approved By:

Note: Asbestos Containing Building Materials (ACBM) are present. Thermal Systems Insulation (TSI) and Miscellaneous ACBM are present in various locations.

ARCHITECT PROJECT NO.

**VA MEDICAL CENTER
REPLACE HVAC CONTROLS**

Building Number
47

Checked
MRM

Drawn
WTJ

Location
ASHEVILLE, N.C.

2007-30

Date
03-13-08

Project No.
637-08-103

DRAWING NO.


M110

Dwg. 17 of 29


CONFIDENTIAL: THESE DRAWINGS MUST BE RETURNED TO FACILITY MANAGEMENT SERVICE, PROJECT SECTION, UPON COMPLETION, OR UPON FINAL USE BY THE CONTRACTOR FOR BIDDING PURPOSES.




Department of
Veterans Affairs

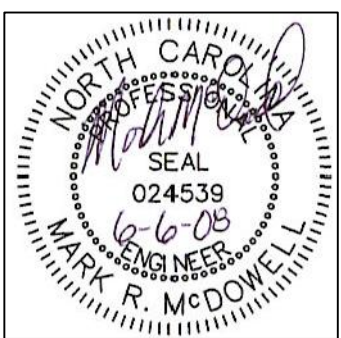

Seal:

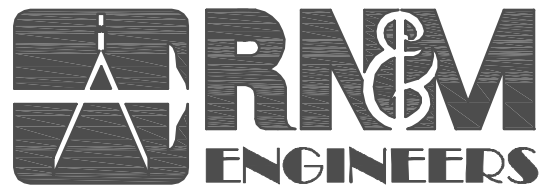


Reece, Noland & McElrath, Inc.
409 North Haywood Street / PO Box 540
Waynesville, North Carolina 28786
WAYNESVILLE 828-454-8801 FAX 828-424-4200
MADEIRA 828-233-2322

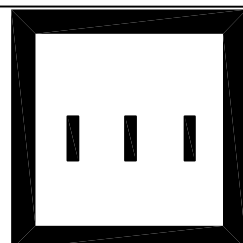


batson
architects
Greenville Commons 220 N. Main Street, Suite 403 Greenville, South Carolina 29601 864.233.2232



KEY PLAN

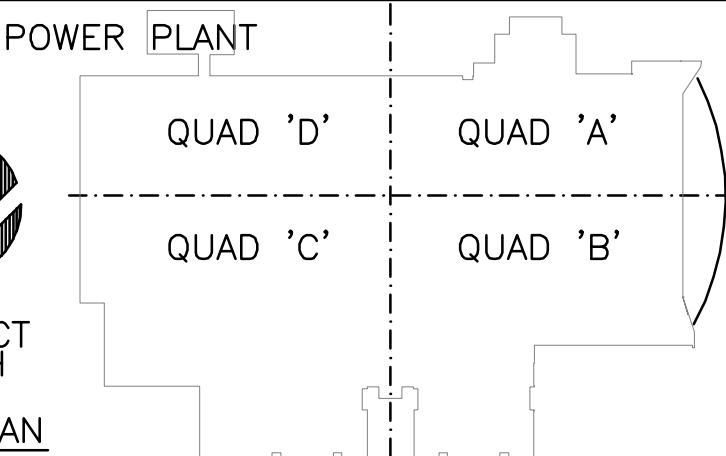

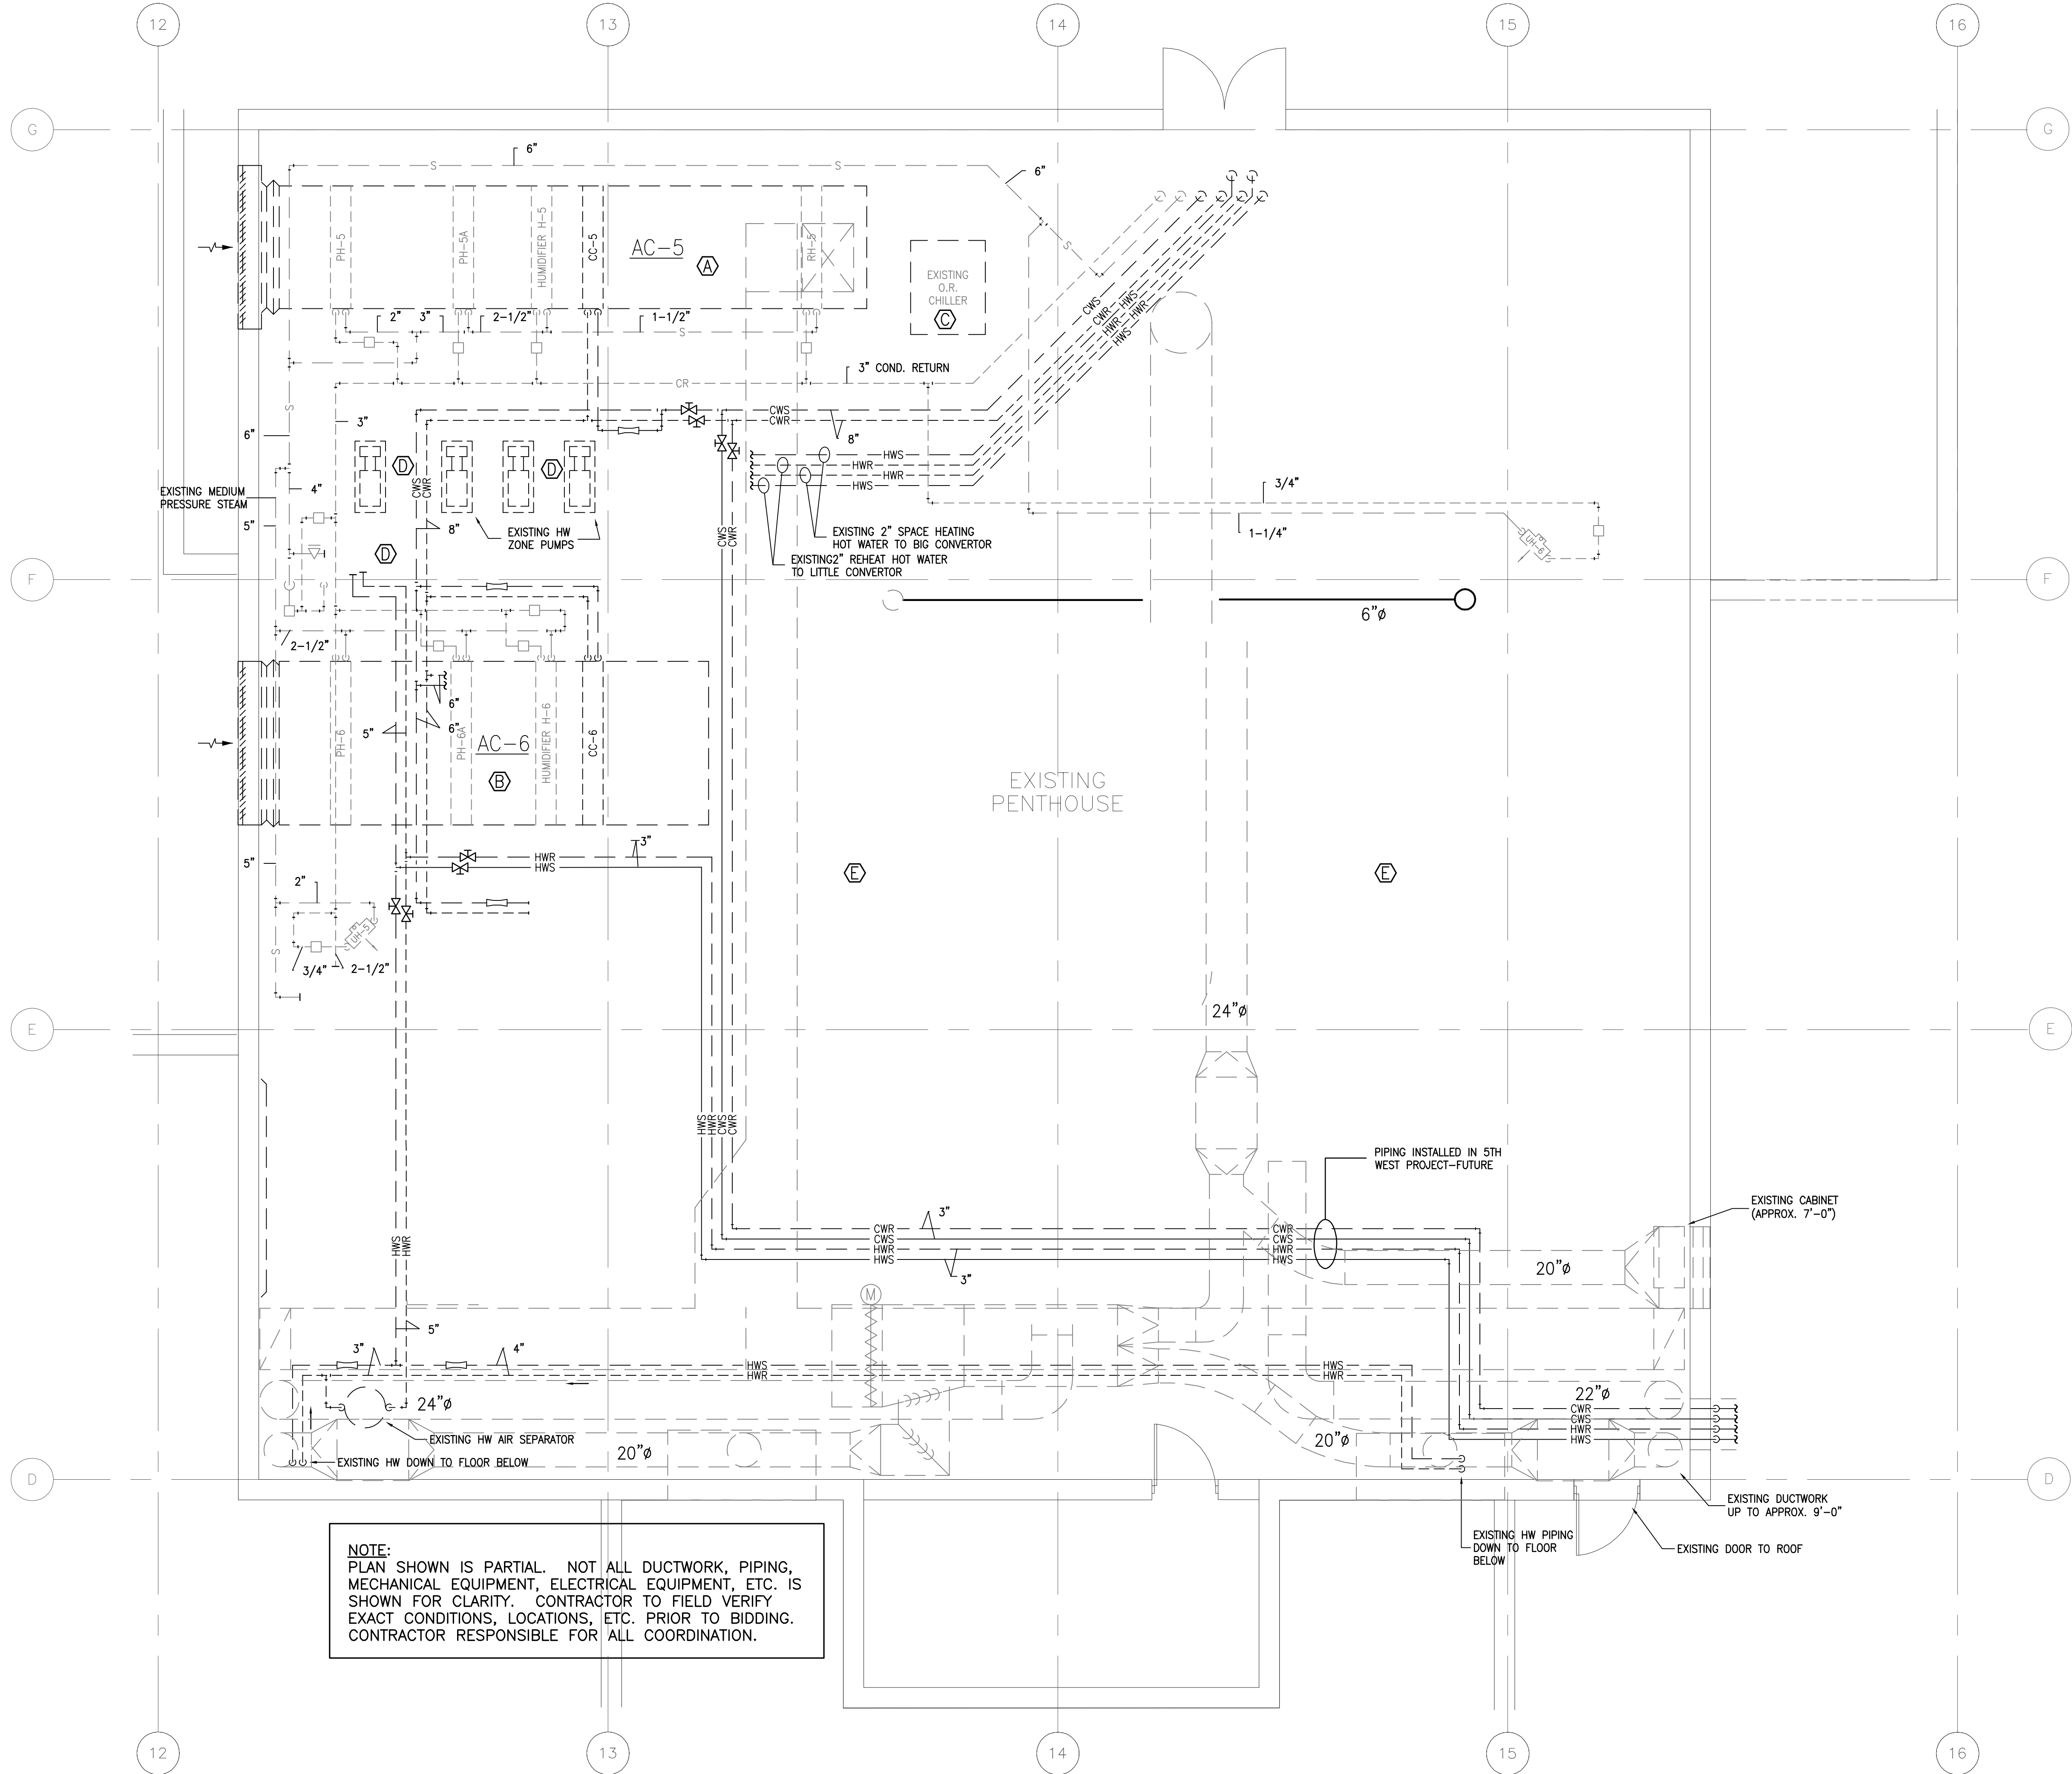

- KEYED NOTES
- (A) EXISTING "AC-5"
 - (B) EXISTING "AC-6"
 - (C) EXISTING O.R. SUPPLEMENTAL CHILLER
 - (D) EXISTING CONNECTORS #1, #2, AND H.W. MAIN / STANDBY PUMPS (NOT IN CONTRACT)
 - (E) NEW "AC-4" ON ROOF ABOVE (PART OF HVAC PHASE II PROJECT - NOT IN CONTRACT).

NOTE:
PLAN SHOWN IS PARTIAL. NOT ALL DUCTWORK, PIPING,
MECHANICAL EQUIPMENT, ELECTRICAL EQUIPMENT, ETC. IS
SHOWN FOR CLARITY. CONTRACTOR TO FIELD VERIFY
EXACT CONDITIONS, LOCATIONS, ETC. PRIOR TO BIDDING.
CONTRACTOR RESPONSIBLE FOR ALL COORDINATION.

LARGE SCALE PENTHOUSE MECHANICAL PLAN

1/4" = 1'-0"

GENERAL NOTE:

- Contractor shall field verify all dimensions.
- Schedule on site inspections with the project COTR.
- Contractor shall comply with OSHA, EPA, NFPA and all other applicable safety codes and regulations at all times.
- All work shall be performed by journeymen or apprentices of the trade in which they are performing work.

- Contractor superintendent shall report to the COTR each morning before work begins, at which the daily schedule shall be discussed.
- Contractor shall maintain dust control at all times. Contractor shall use "sticky mats" outside each work area and shall erect barriers to minimize dust/dirt spreading/tracking to the greatest extent possible.
- Contractor to maintain the job site in a neat and orderly fashion at all times. Corridors shall be kept clear of all debris and obstructions to allow safe passage for employees, patients, visitors and workers. Dispose of all trash and discarded materials and maintain storage within the confines of the job site or other approved areas.

- All materials removed shall become property of the contractor, to be disposed off site unless scheduled to be reinstated or turned over to the VA.
- Contractor superintendent shall carry a pager and/or install a job site telephone. Furnish numbers to the project COTR upon contract award.
- Contractor shall schedule all utility interruptions with the project COTR at least forty-eight (48) hours in advance. Utility interruptions may require overtime work for all trades involved, and shall be provided by the contractor at no additional cost to the government.

- Contractor shall schedule all utility interruptions with the project COTR at least forty-eight (48) hours in advance. Utility interruptions may require overtime work for all trades involved, and shall be provided by the contractor at no additional cost to the government.
BUILDING IS FULLY SPRINKLERED

Revisions		Date	
		Seal:	
POWER PLANT		QUAD 'A'	
QUAD 'D'		QUAD 'B'	
QUAD 'C'		QUAD 'A'	
KEY PLAN		QUAD 'B'	
Drawing Title		ARCHITECT PROJECT NO.	
LARGE SCALE PENTHOUSE MECHANICAL PLAN		2007-30	
REPLACE HVAC CONTROLS		DATE	
Approved By:		03-13-08	
Note: Asbestos Containing Building Materials (ACBM) are present. Thermal Systems Insulation (TSI) and Miscellaneous ACBM are present in various locations.		Project No.	
Building Number		637-08-103	
47		Checked	
WTJ		WTJ	
Location		DRAWING NO.	
ASHEVILLE, N.C.		M111	
		Dwg. 18 of 29	

A
B
C
D
E
F

A
B
C
D
E
F

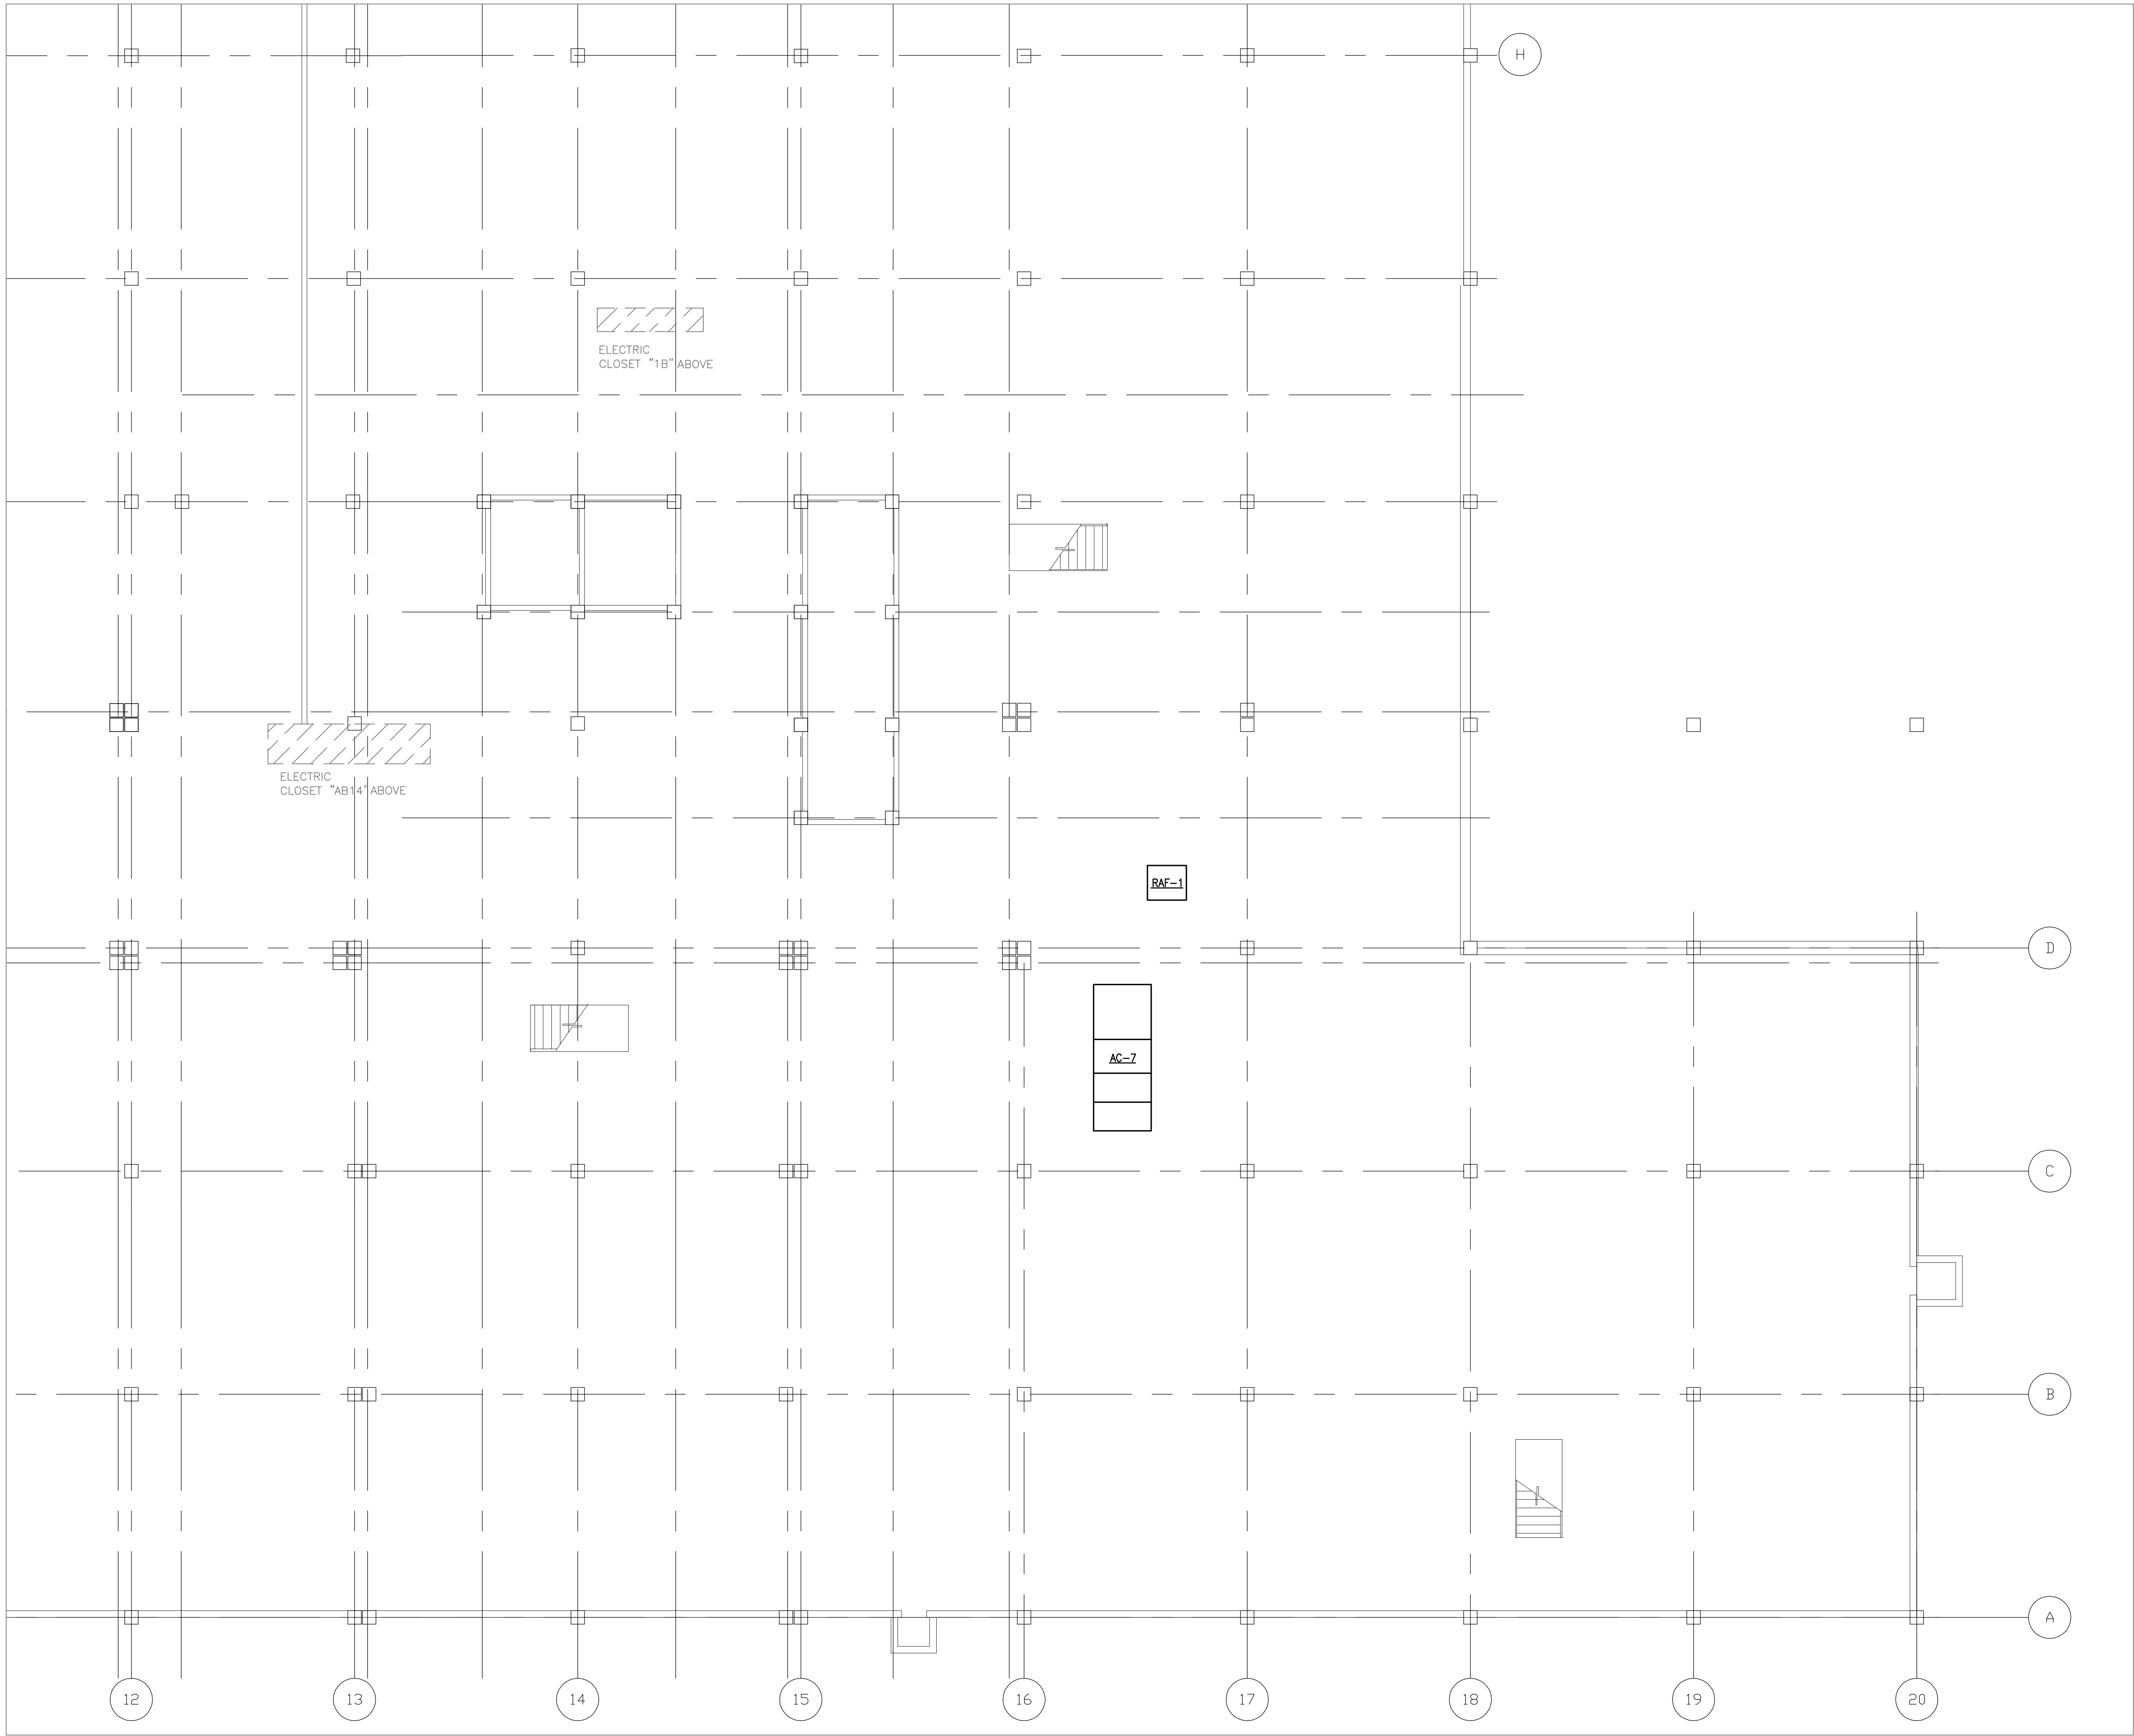

CRAWL SPACE MECHANICAL PLAN


1/8" = 1'-0"

GENERAL NOTE:

1. Contractor shall field verify all dimensions.
2. Schedule on site inspections with the project COTR.
3. Contractor shall comply with OSHA, EPA, NFPA and all other applicable safety codes and regulations at all times.
4. All work shall be performed by craftsmen who are journeymen of the trade in which they are performing work.
5. Contractor superintendent shall report to the COTR each morning before work begins, at which the daily schedule shall be discussed.
6. Contractor shall maintain dust control at all times. Contractor shall use "sticky mats" outside each work area and shall erect barriers to minimize dust/dirt, spreading/tracking to the greatest extent possible.
7. Contractor to maintain the job site in a neat and orderly fashion at all times. Corridors shall be kept clean of all debris and obstructions to allow safe passage for employees, patients, visitors and workers. Dispose of all trash and discarded materials and maintain storage within the confines of the job site or other approved areas.
8. All damages incurred to adjacent areas shall be repaired and returned to original condition by the contractor at no additional cost to the government.
9. All materials removed shall become property of the contractor, to be disposed off site unless scheduled to be reinstalled or turned over to the VA.
10. Contractor superintendent shall carry a pager and/or install a job site telephone. Furnish numbers to the project COTR upon contract award.
11. Contractor shall schedule all utility interruptions with the project COTR at least forty-eight (48) hours in advance. Utility interruptions may require overtime work for all trades involved, and shall be provided by the contractor at no additional cost to the government.
12. "Hot Work" permits are required. Notify the COTR twenty-four (24) hours prior to commencement of work.
13. Manufacturers' trade names and numbers used herein identify a minimum standard. Subject to approval of the Contracting Officer, other products shall be considered, provided they are equivalent to these standards and meet the requirements of the technical specifications and drawings.

BUILDING IS FULLY SPRINKLERED

<div>Revisions</div> <div>Date</div>		<div><div>Seal:</div></div>	<div><div>Reece, Noland & McElrath, Inc. 409 North Haywood Street / PO Box 540 Waynesville, North Carolina 28786 WAYNESVILLE 828-454-8801 FAX 828-454-4200 MA@RN&MENGINEERS.COM © 2006 WWW.RN&MENGINEERS.COM</div></div>	<div><div>batson architects Greenville Commons 220 N. Main Street, Suite 403 Greenville, South Carolina 29601 864.233.2232</div></div>	<div><div>POWER PLANT QUAD 'D' QUAD 'A' QUAD 'C' QUAD 'B' PROJECT NORTH KEY PLAN</div></div>	<div><div>BID DOCUMENTS</div><div>Drawing Title BASEMENT AND CRAWL SPACE MECHANICAL PLANS BUILDING 47 - BASE BID</div><div>Approved By:</div><div>Note: Asbestos Containing Building Materials (ACBM) are present. Thermal Systems Insulation (TSI) and Miscellaneous ACBM are present in various locations.</div></div>	<div><div>ARCHITECT PROJECT NO. 2007-30</div><div>Project Title VA MEDICAL CENTER REPLACE HVAC CONTROLS</div><div>Building Number 47</div><div>Location ASHEVILLE, N.C.</div></div>	<div><div>Date 03-13-08</div><div>Project No. 637-08-103</div><div>DRAWING NO. M112 Dwg. 19 of 29</div></div>	<div><div>Office of Facilities Department of Veterans Affairs</div></div>
--------------------------------------	--	-----------------------------	--	--	--	---	--	--	---

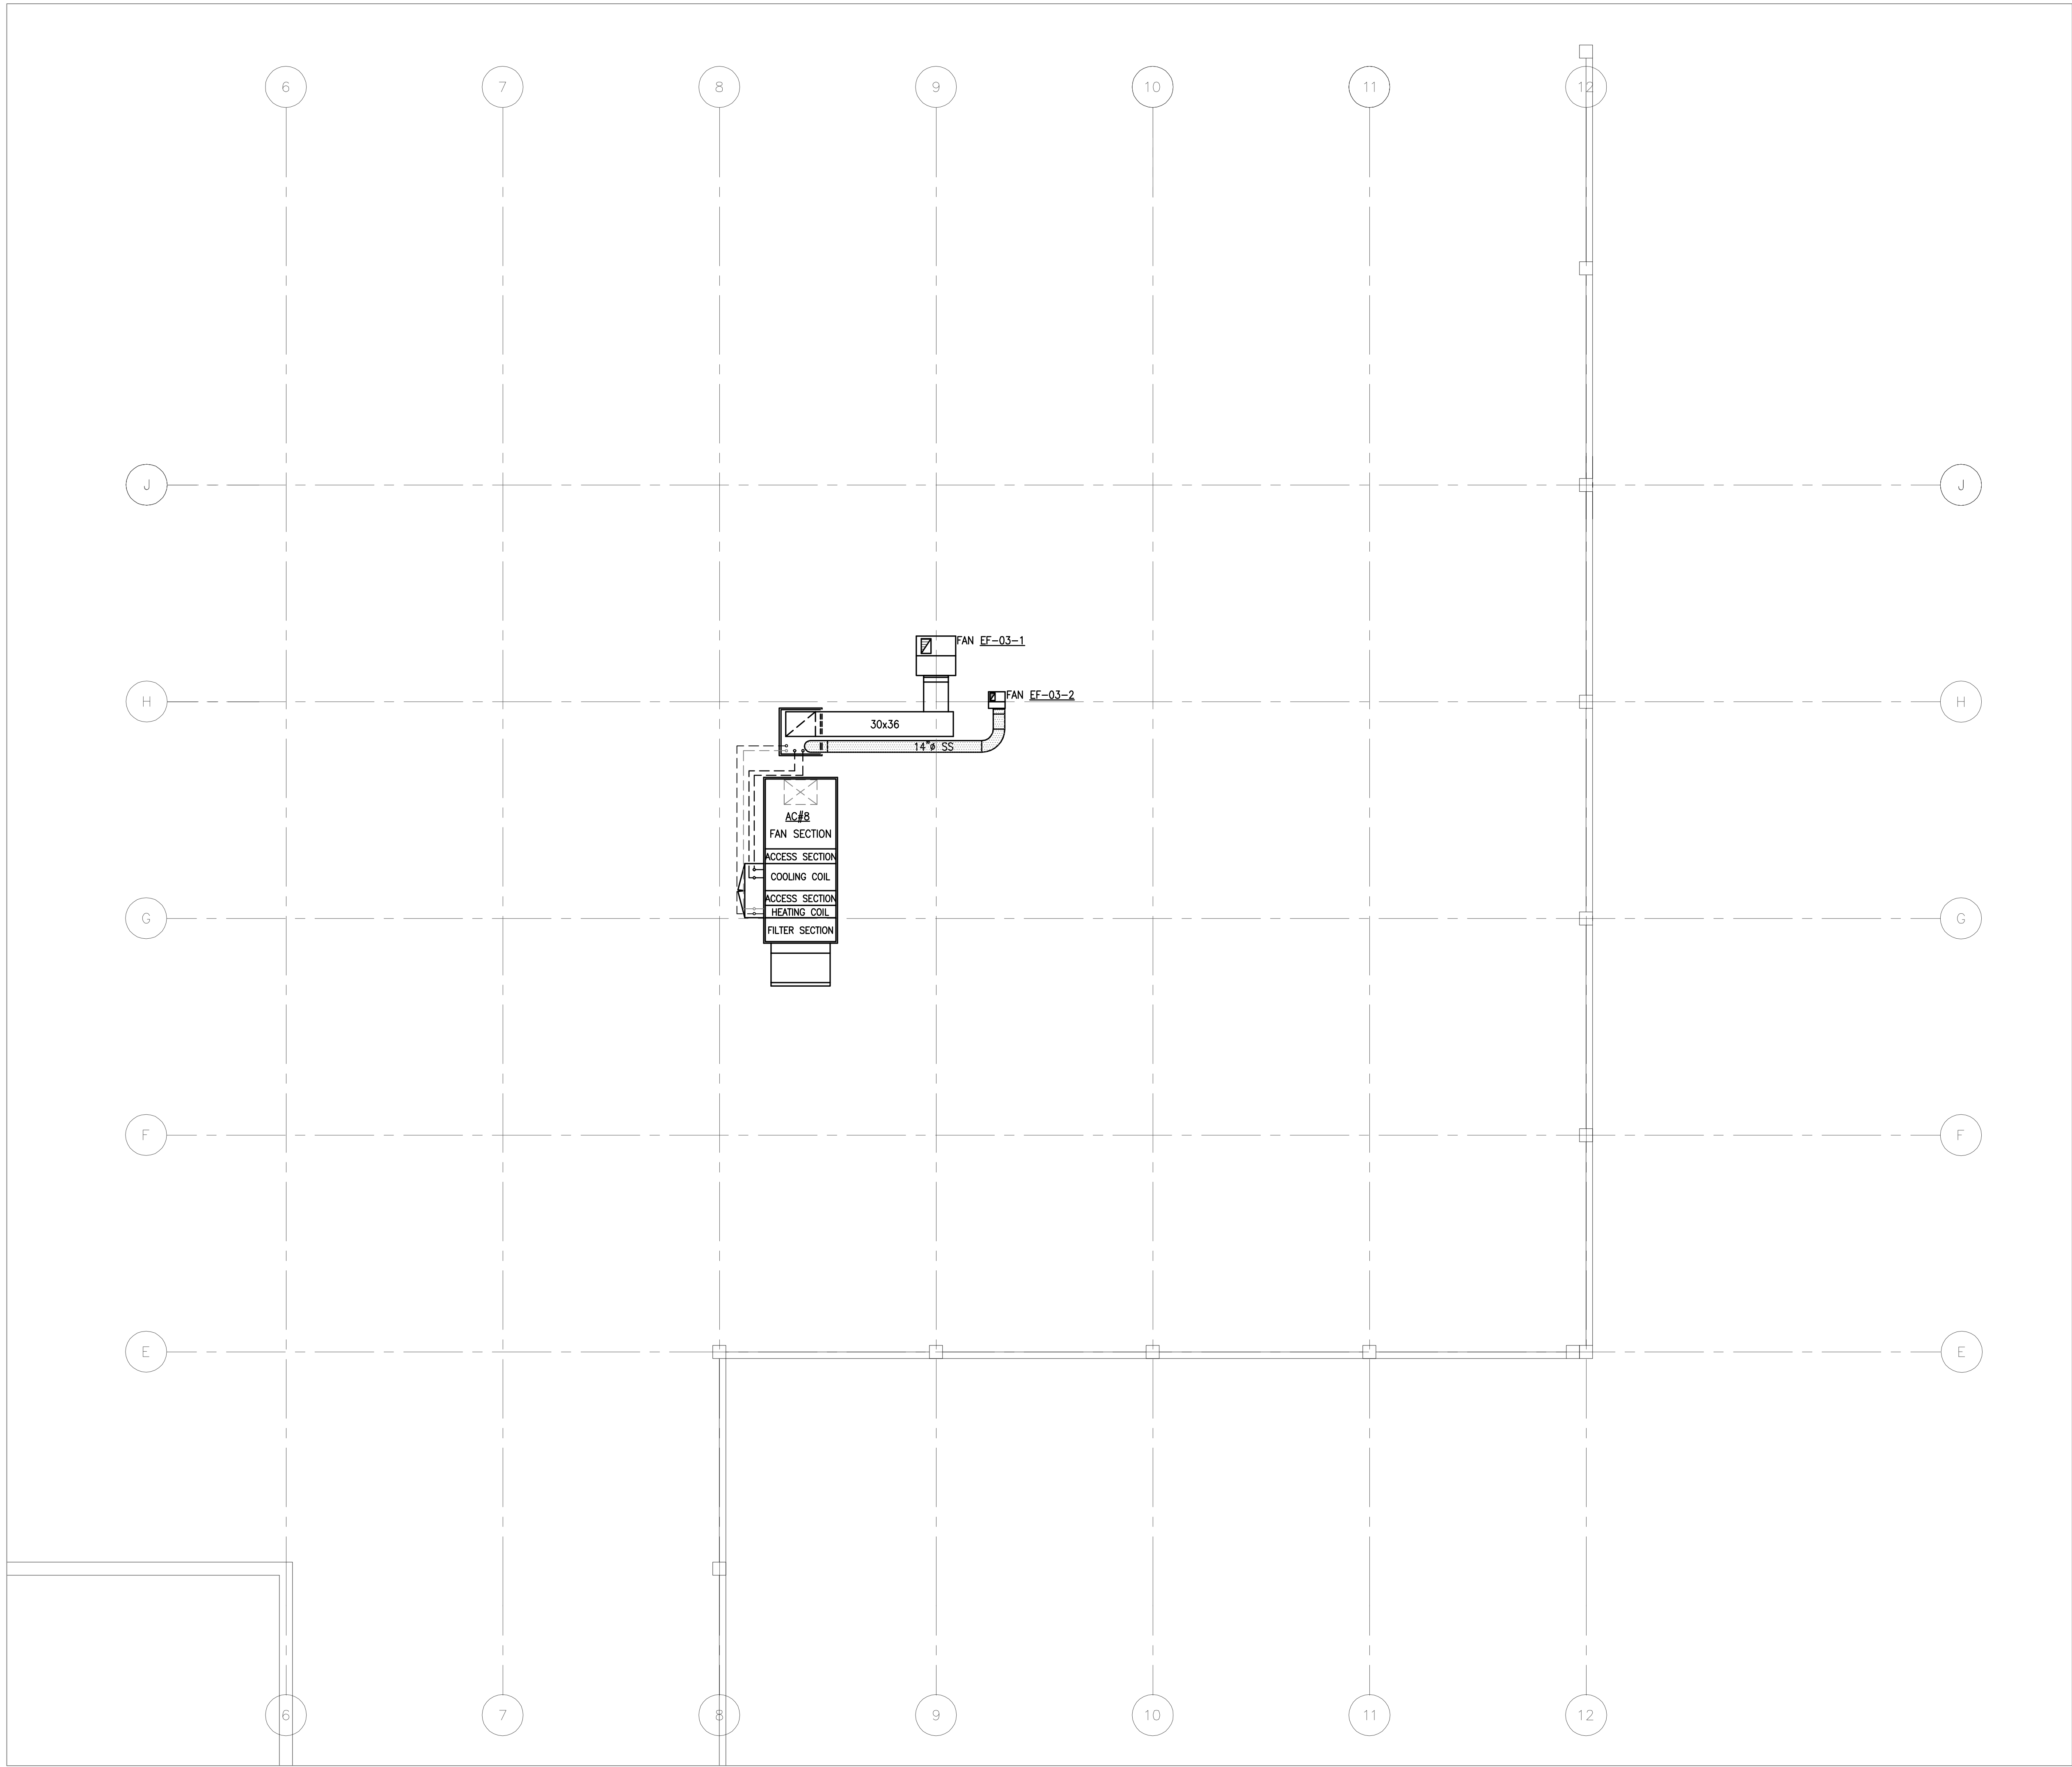
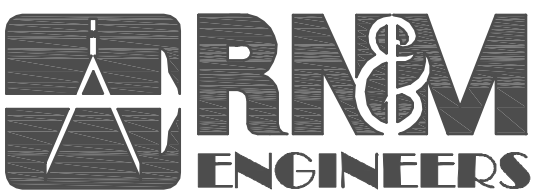
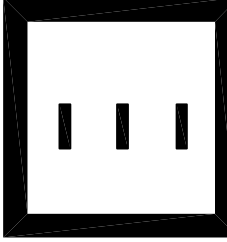
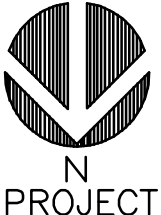
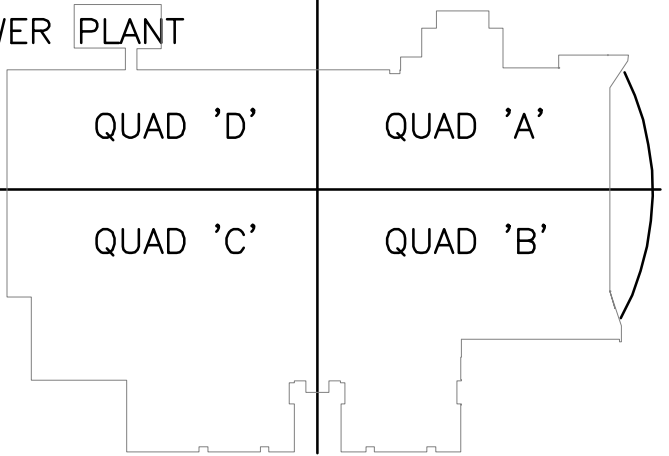





 **ROOF MECHANICAL PLAN**
1/8" = 1'-0"

GENERAL NOTE:

1. Contractor shall field verify all dimensions.
2. Schedule on site inspections with the project COTR.
3. Contractor shall comply with OSHA, EPA, NFPA and all other applicable safety codes and regulations at all times.
4. All work shall be performed by craftsmen who are journeymen of the trade in which they are performing work.
5. Contractor superintendent shall report to the COTR each morning before work begins, at which the daily schedule shall be discussed.
6. Contractor shall maintain dust control at all times. Contractor shall use "sticky mats" outside each work area and shall erect barriers to minimize dust/dirt, spreading/tracking to the greatest extent possible.
7. Contractor to maintain the job site in a neat and orderly fashion at all times. Corridors shall be kept clean of all debris and obstructions to allow safe passage for employees, visitors and workers. Dispose of all trash and discarded materials and maintain storage within the confines of the job site or other approved areas.
8. All damages incurred to adjacent areas shall be repaired and restored to original condition by the contractor at no additional cost to the government.
9. All materials removed shall become property of the contractor, to be disposed off site unless scheduled to be reinstalled or turned over to the VA.
10. Contractor superintendent shall carry a pager and/or install a job site telephone. Furnish numbers to the project COTR upon contract award.
11. Contractor shall schedule all utility interruptions with the project COTR at least forty-eight (48) hours in advance. Utility interruptions may require overtime work for all trades involved, and shall be provided by the contractor at no additional cost to the government.
12. "Hot Work" permits are required. Notify the COTR twenty-four (24) hours prior to commencement of work.
13. Manufacturers' trade names and numbers used herein identify a minimum standard. Subject to approval of the Contracting Officer, other products shall be considered, provided they are equivalent to these standards and meet the requirements of the technical specifications and drawings.

BUILDING IS FULLY SPRINKLERED


<div>Revisions</div> <div>Date</div>		<div></div> <div>Seal:</div>	<div> Reece, Noland & McElrath, Inc. 409 North Haywood Street / PO Box 540 Waynesville, North Carolina 28786 <small>WAYNESVILLE 828-424-8801 FAX 828-424-4200 MAIL@RN&MENGINERS.COM © 2008 WWW.RN&MENGINERS.COM</small></div>	<div> batson architects <small>Greenville Commons 220 N. Main Street, Suite 403 Greenville, South Carolina 29601 864.233.2232</small></div>	<div> PROJECT NORTH KEY PLAN</div>	<div></div>	<div>BID DOCUMENTS</div> <div>Drawing Title ROOF MECHANICAL PLAN BUILDING 47 (BASE BID)</div> <div>Approved By:</div> <div>Note: Asbestos Containing Building Materials (ACBM) are present. Thermal Systems Insulation (TSI) and Miscellaneous ACBM are present in various locations.</div>	<div>ARCHITECT PROJECT NO. 2007-30</div> <div>Project Title VA MEDICAL CENTER REPLACE HVAC CONTROLS</div> <div>Building Number 47</div> <div>Location ASHEVILLE, N.C.</div>	<div>Date 03-13-08</div> <div>Project No. 637-08-103</div> <div>DRAWING NO. M113</div> <div>Dwg. 20 of 29</div>	<div> Office of Facilities</div> <div> Department of Veterans Affairs</div>
--------------------------------------	--	---	---	--	---	--	---	---	---	---

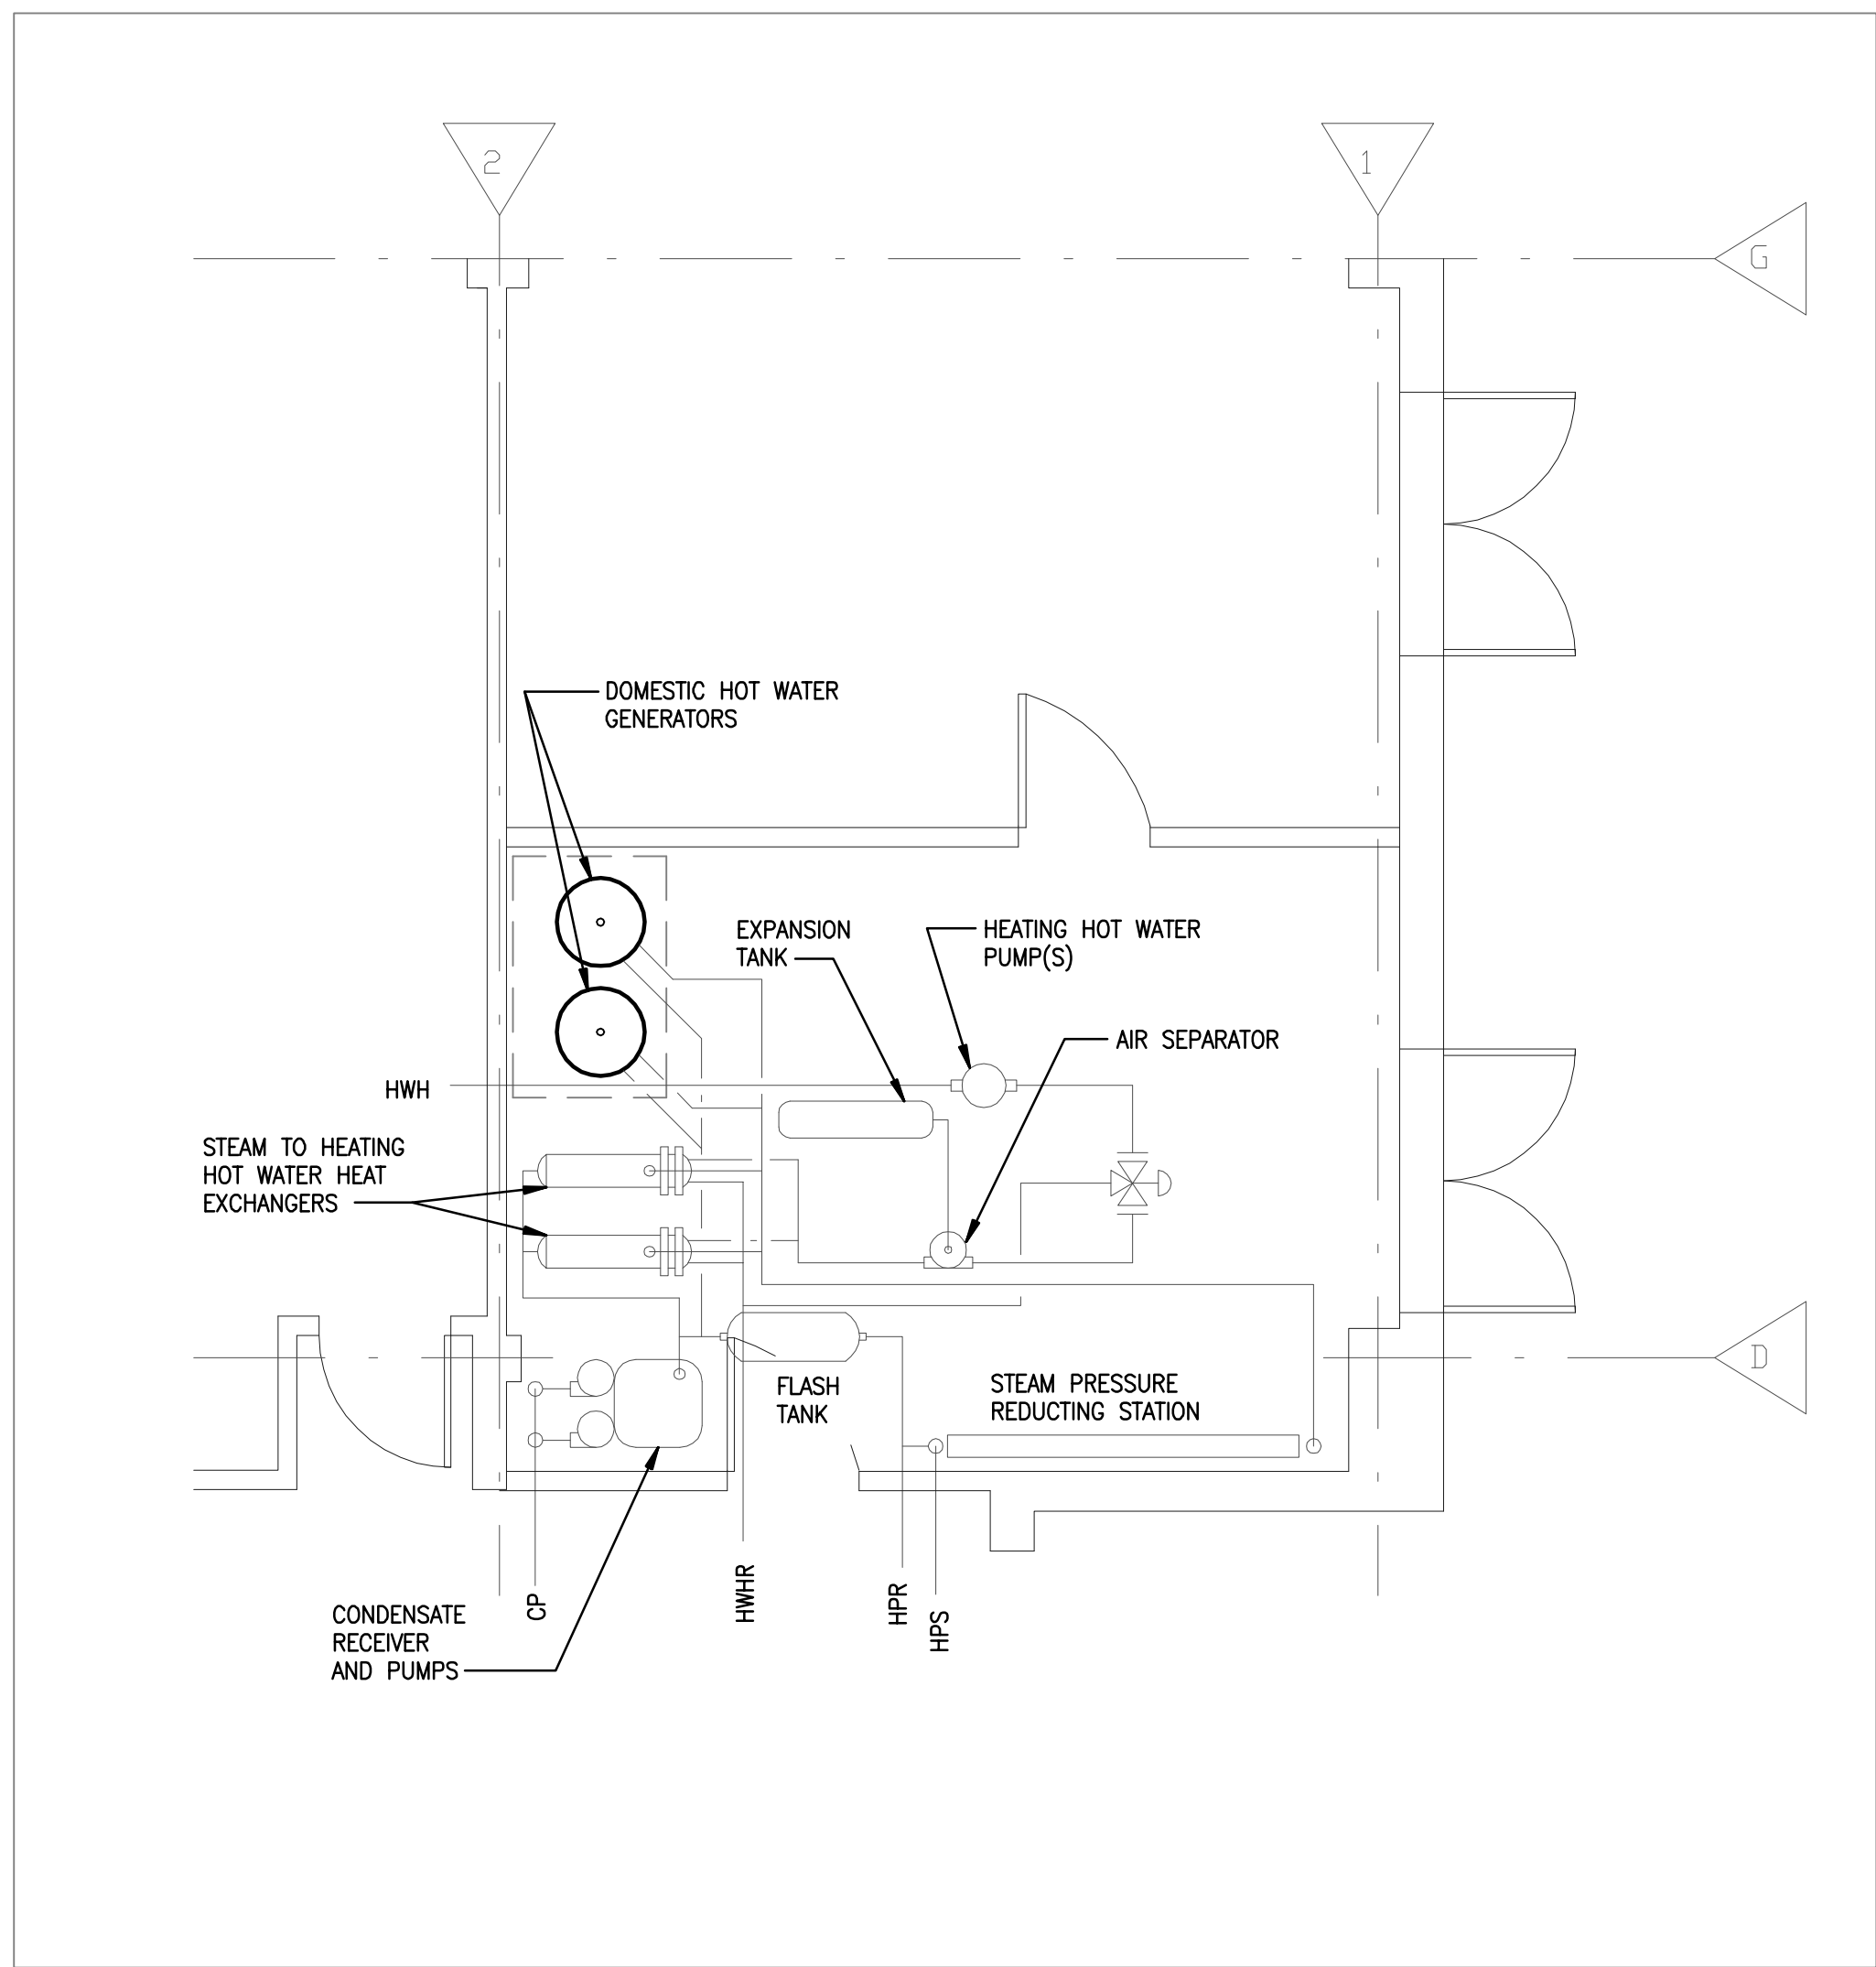

**FIRST FLOOR AREA A
MECHANICAL ROOM PLAN**


1/4" = 1'-0"

NOTE: EXISTING CONTROL DEVICES TO REMAIN.
REPLACE EXISTING CONTROLLERS & PROVIDE
REPROGRAMMING AS REQUIRED.

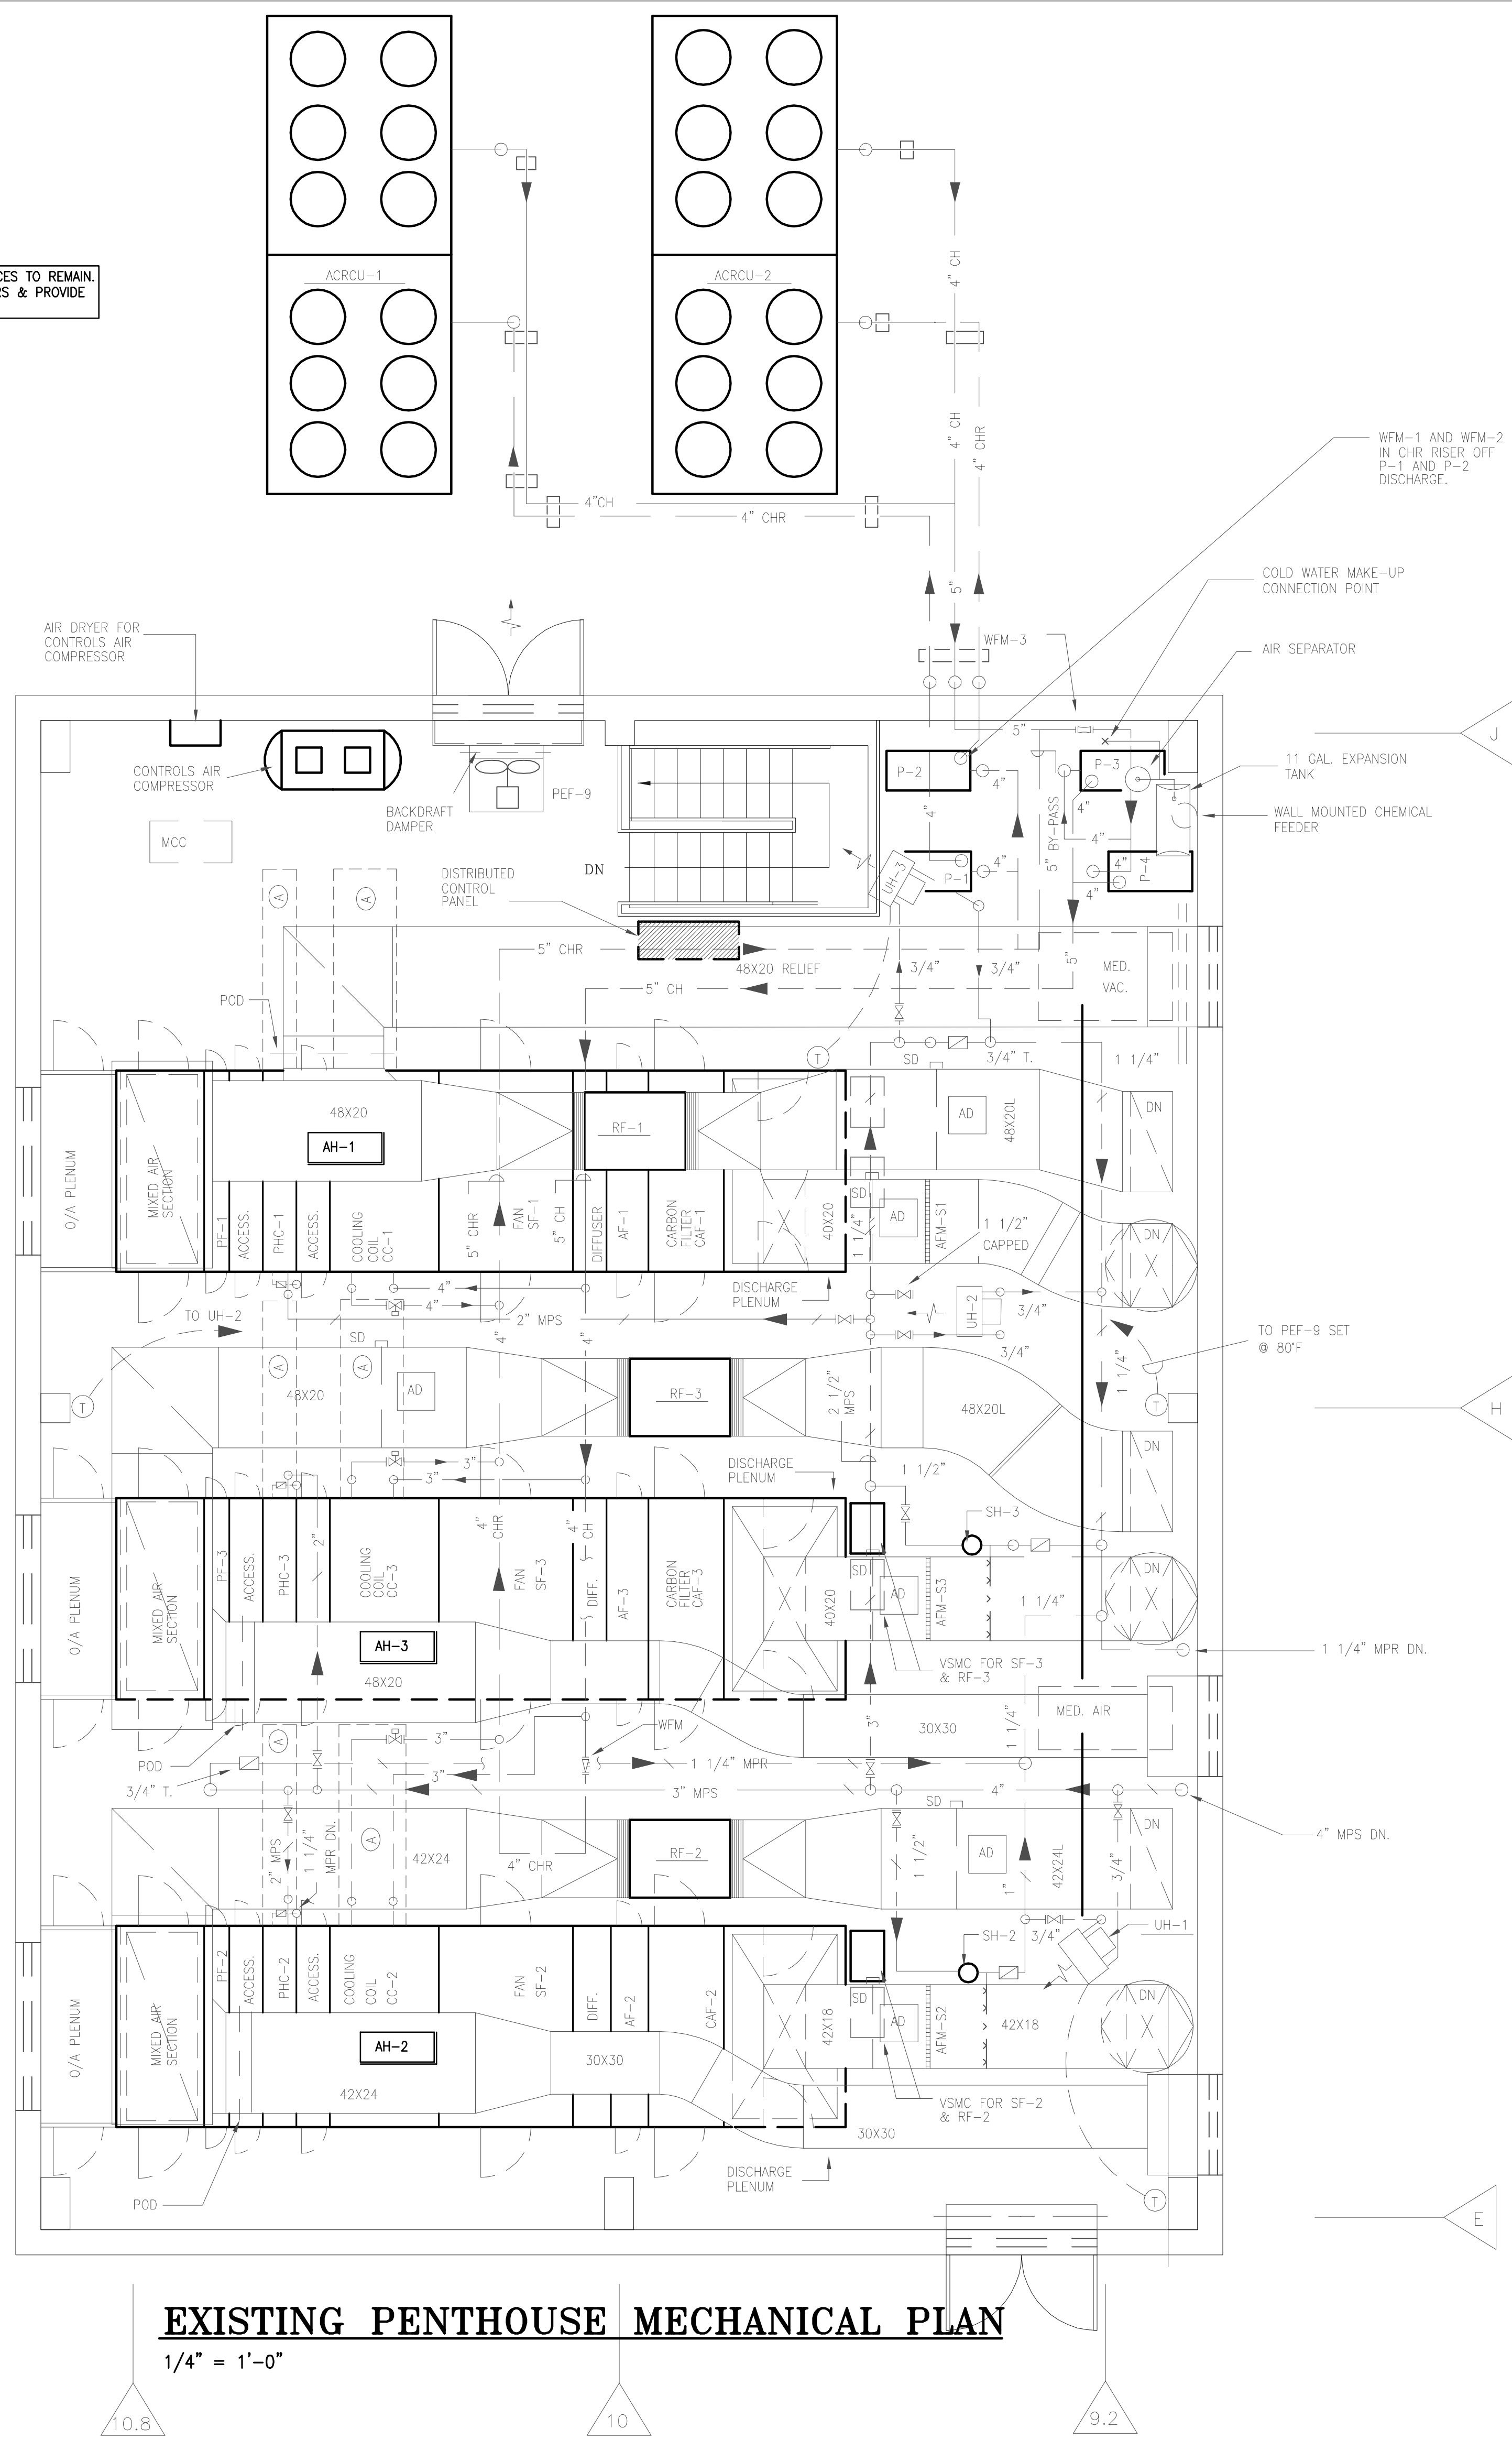

EXISTING PENTHOUSE MECHANICAL PLAN

1/4" = 1'-0"

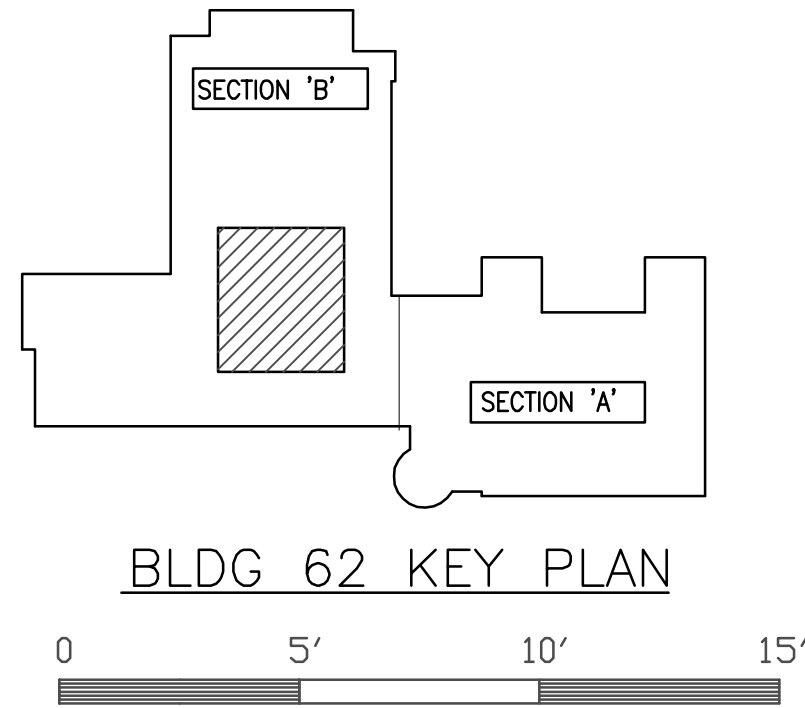

GENERAL NOTE:





1. Contractor shall field verify all dimensions.
2. Schedule on site inspections with the project COTR.
3. Contractor shall comply with OSHA, EPA, NFPA and all other applicable safety codes and regulations at all times.
4. All work shall be performed by craftsmen who are journeymen of the trade in which they are performing work.

5. Contractor superintendent shall report to the COTR each morning before work begins, at which the daily schedule shall be discussed.
6. Contractor shall maintain dust control at all times. Contractor shall use "sticky mats" outside each work area and shall erect barriers to minimize dust/dirt, spreading/tracking to the greatest extent possible.
7. Contractor to maintain the job site in a neat and orderly fashion at all times. Corridors shall be kept clean of all debris and obstructions to allow safe passage for employees, patients, visitors and workers. Dispose of all trash and discarded materials and maintain storage within the confines of the job site or other approved areas.
8. All damages incurred to adjacent areas shall be repaired and restored to original condition by the contractor at no additional cost to the government.

9. All materials removed shall become property of the contractor, to be disposed off site unless scheduled to be reinstalled or turned over to the VA.
10. Contractor superintendent shall carry a pager and/or install a job site telephone. Furnish numbers to the project COTR upon contract award.
11. Contractor shall schedule all utility interruptions with the project COTR at least forty-eight (48) hours in advance. Utility interruptions may require overtime work for all trades involved, and shall be provided by the contractor at no additional cost to the government.
12. "Hot Work" permits are required. Notify the COTR twenty-four (24) hours prior to commencement of work.


13. Manufacturers' trade names and numbers used herein identify a minimum standard. Subject to approval of the Contracting Officer, other products may be considered, provided they are equivalent to those standards and meet the requirements of the technical specifications and drawings.

Revisions	Date

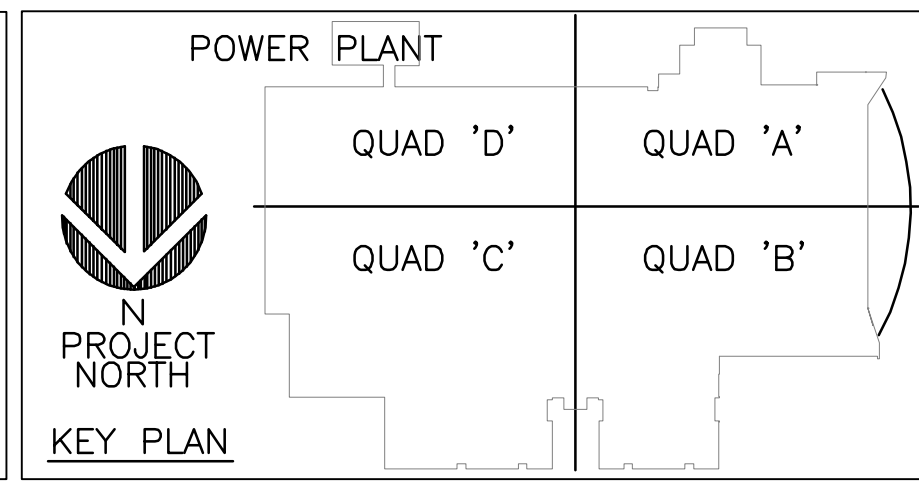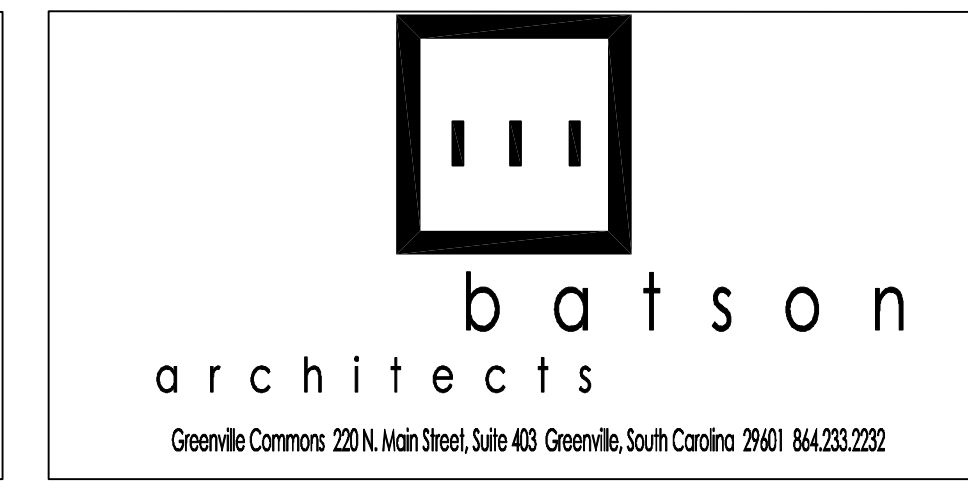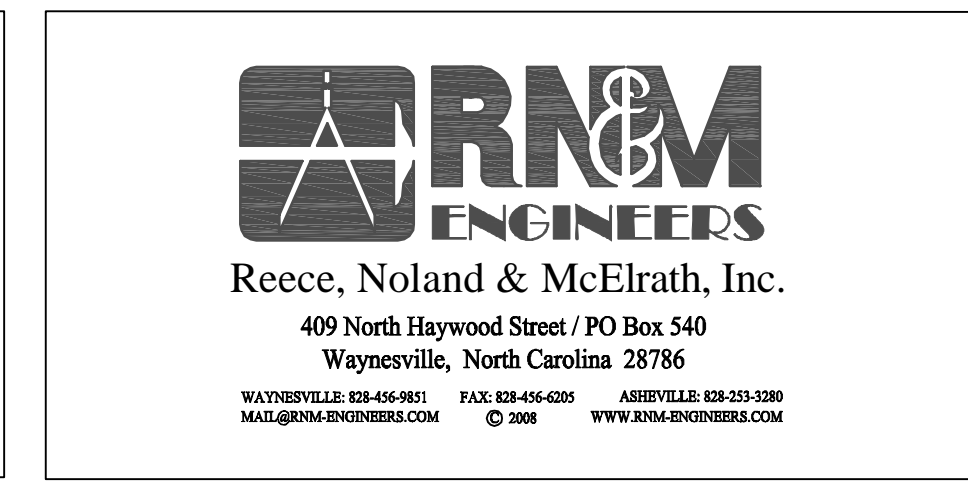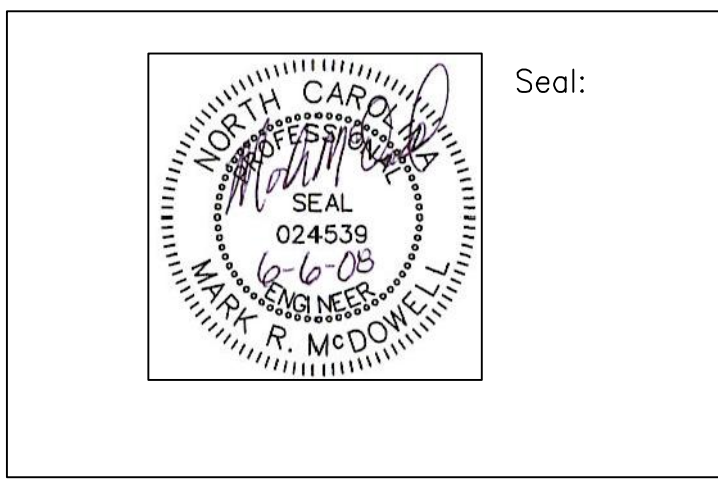

BUILDING IS FULLY SPRINKLERED

BID DOCUMENTS		ARCHITECT PROJECT NO.		2007-30	
Drawing Title		Project Title		Date	
EXISTING MECHANICAL PLANS BUILDING 62 - BASE BID		VA MEDICAL CENTER REPLACE HVAC CONTROLS		03-13-08	
Approved By:		Building Number		Project No.	
Note: Asbestos Containing Building Materials (ACBM) are present. Thermal Systems Insulation (TSI) and Miscellaneous ACBM are present in various locations.		47		637-08-103	
Location		Checked		Drawing No.	
ASHEVILLE, N.C.		MFM		M114	
		Drawn		Dwg. 21 of 29	
		WTJ			

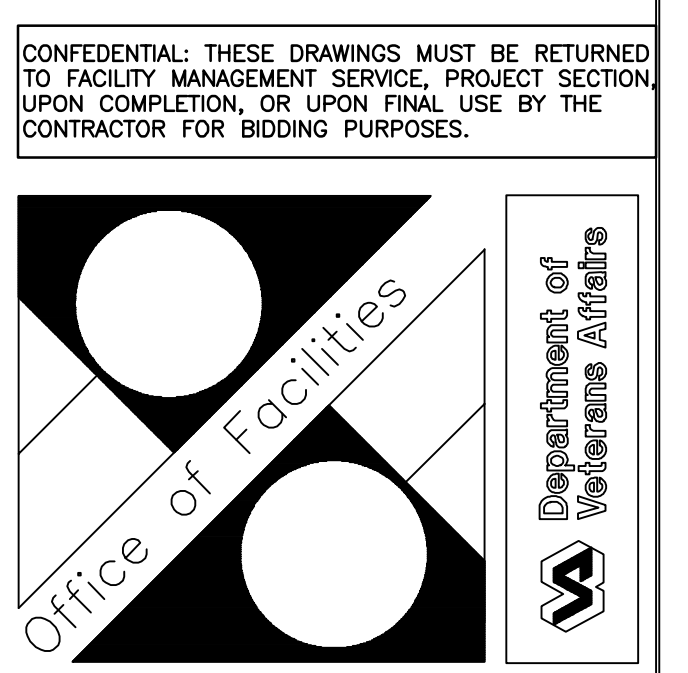

A
B
C
D
E
F

ENGINEERING CONTROL CENTER (ECC) DOT MATRIX CONTROL POINT SCHEDULE														
SYSTEM POINT DESCRIPTION	INPUTS							OUTPUTS						
	ANALOG							ANALOG						
	OUTSIDE AIR TEMPERATURE °F.	DUCT TEMPERATURE °F.	WATER TEMPERATURE °F.	STATIC PRESSURE IN. WG.	DIFFERENTIAL PRESSURE	% RELATIVE HUMIDITY	FLOW (CFM, GPM)	POSITION INDICATION	KV	MOTOR AMPS	BTU	STEAM PRESSURE (PSIG)	LBS./HR.	PRESSURE (PSIG)
1 AIR HANDLING UNITS														
2														
3 AH-1 SYSTEM (VAV)														
4 SF-1 SUPPLY FAN														
5 SF-1 SUPPLY FAN SPEED														
6 RF-1 RETURN FAN														
7 RF-1 RETURN FAN SPEED														
8														
9 MINIMUM OUTSIDE AIR DAMPER														
10 MAXIMUM OUTSIDE AIR DAMPER														
11 RETURN AIR DAMPER														
12 RELIEF AIR DAMPER														
13														
14 PF-1 PREFILTER														
15 AF-1 AFTER FILTER														
16 CAF-1 CARBON FILTER														
17 HC-1 HEATING COIL VALVE														
18 CC-1 COOLING COIL VALVE														
19														
20														
21														
22 SMOKE DETECTOR SUPPLY														
23 SMOKE DETECTOR RETURN														
24 SMOKE DAMPERS (RETURN AIR)														
25 SMOKE DAMPERS (SUPPLY AIR)														
26 OUTSIDE AIR														
27 MIXED AIR														
28 SUPPLY AIR														
29 RETURN AIR														
30														
31														
32														
33 AH-2 SYSTEM (VAV)														
34 SF-2 SUPPLY FAN														
35 SF-2 SUPPLY FAN SPEED														
36 RF-2 RETURN FAN														
37 RF-2 RETURN FAN SPEED														
38														
39 MINIMUM OUTSIDE AIR DAMPER														
40 MAXIMUM OUTSIDE AIR DAMPER														
41 RETURN AIR DAMPER														
42 RELIEF AIR DAMPER														
43														
44 PF-2 PREFILTER														
45 AF-2 AFTER FILTER														
46 CAR-2 CARBON FILTER														
47 HC-2 HEATING COIL VALVE														
48 CC-2 COOLING COIL VALVE														
49 HUMIDIFIER ON-OFF VALVE														
50 SH-2 HUMIDIFIER MODULATING VALVE														
51														
52 SMOKE DETECTOR SUPPLY														
53 SMOKE DETECTOR RETURN														
54 SMOKE DAMPERS (RETURN AIR)														
55 SMOKE DAMPERS (SUPPLY AIR)														
56 OUTSIDE AIR														
57 MIXED AIR														
58 SUPPLY AIR														
59 RETURN AIR														
60														
61														
62														
63 AH-3 SYSTEM (VAV)														
64 SF-3 SUPPLY FAN														
65 SF-3 SUPPLY FAN SPEED														
66 RF-3 RETURN FAN														
67 RF-3 RETURN FAN SPEED														
68														
69 MINIMUM OUTSIDE AIR DAMPER														
70 MAXIMUM OUTSIDE AIR DAMPER														
71 RETURN AIR DAMPER														
72 RELIEF AIR DAMPER														
73														
74 PF-3 PREFILTER														
75 AF-3 AFTER FILTER														
76 CAR-3 CARBON FILTER														

EXISTING CONTROL DEVICES TO REMAIN.
REPLACE EXISTING CONTROLLERS & PROVIDE
REPROGRAMMING AS REQUIRED.

GENERAL NOTE:


1. Contractor shall verify all dimensions.
2. Schedule on site inspections with the project COTR.
3. Contractor shall comply with OSHA, EPA, NFPA and all other applicable safety codes and regulations at all times.
4. All work shall be performed by craftsmen who are journeymen of the trade in which they are performing work.

5. Contractor superintendent shall report to the COTR each morning before work begins, at which the daily schedule shall be discussed.
6. Contractor shall maintain dust control at all times. Contractor shall use "sticky mat" outside each work area and shall erect barriers to minimize dust/dirt, spreading/tracking to the greatest extent possible.
7. Contractor to maintain the job site in a neat and orderly fashion at all times. Corridors shall be kept clean of all debris and obstructions to allow safe passage for employees, patients, visitors and workers. Dispose of all trash and discarded materials and maintain storage within the confines of the job site or other approved areas.
8. All damages incurred to adjacent areas shall be repaired and restored to original condition by the contractor at no additional cost to the government.

9. All materials removed shall become property of the contractor, to be disposed off site unless scheduled to be reinstalled or turned over to the VA.
10. Contractor superintendent shall carry a pager and/or install a job site telephone. Furnish numbers to the project COTR upon contract award.
11. Contractor shall schedule all utility interruptions with the project COTR at least forty-eight (48) hours in advance. Utility interruptions may require overtime work for all trades involved, and shall be provided by the contractor at no additional cost to the government.
12. "Hot Work" permits are required. Notify the COTR twenty-four (24) hours prior to commencement of work.

13. Manufacturers' trade names and numbers used herein identify a minimum standard. Subject to approval of the Contracting Officer, other products shall be considered, provided they are equivalent to these standards and meet the requirements of the technical specifications and drawings.

Revisions	Date

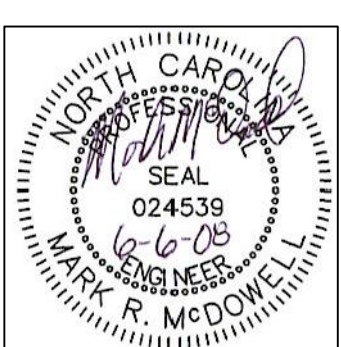

Seal:



RNM
ENGINEERS


Reece, Noland & McElrath, Inc.
409 North Haywood Street / PO Box 540
Waynesville, North Carolina 28786

WAYNESVILLE 828-454-8651 FAX 828-424-4200
MIDLAND 828-454-8651
ASHEVILLE 828-233-2232
© 2004 WWW.RNMENGINEERS.COM



batson
architects



Greenlife Commons 220 N. Main Street, Suite 403 Greenville, South Carolina 29601 864.233.2232





























POWER PLANT


QUAD 'D'	QUAD 'A'
QUAD 'C'	QUAD 'B'

KEY PLAN

BUILDING IS FULLY SPRINKLERED	
BID DOCUMENTS	
Drawing Title EXISTING DDC POINTS LIST BUILDING 62 - BASE BID	
Approved By:	
Note: Asbestos Containing Building Materials (ACBM) are present. Thermal Systems Insulation (TSI) and Miscellaneous ACBM are present in various locations.	
ARCHITECT PROJECT NO. 2007-30	
Project Title VA MEDICAL CENTER REPLACE HVAC CONTROLS	
Date 03-13-08	
Project No. 637-08-103	
Building Number 47	
Checked MRM	
Drawn WTJ	
DRAWING NO. M117	
Dwg. 24 Of 29	
Location ASHEVILLE, N.C.	
 <p>Office of Facilities</p>	
 <p>Department of Veterans Affairs</p>	

CONFIDENTIAL: THESE DRAWINGS MUST BE RETURNED TO FACILITY MANAGEMENT SERVICE, PROJECT SECTION, UPON COMPLETION, OR UPON FINAL USE BY THE CONTRACTOR FOR BIDDING PURPOSES.

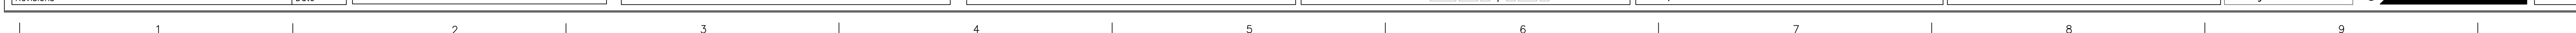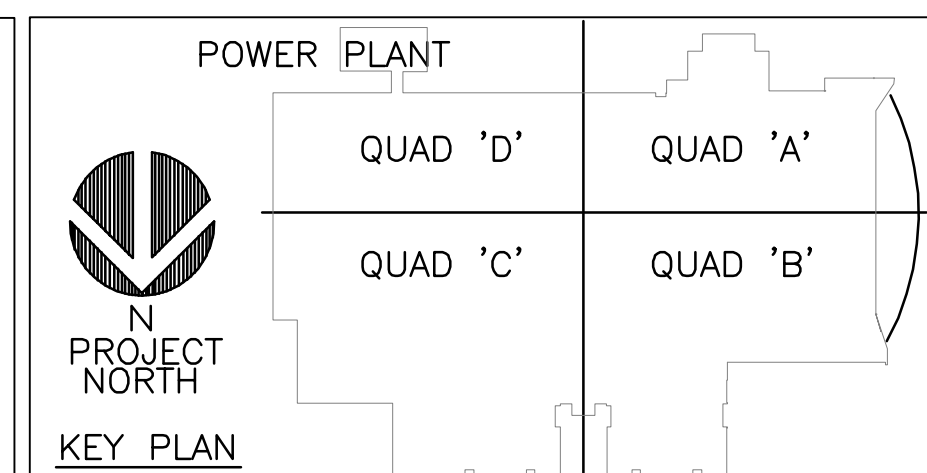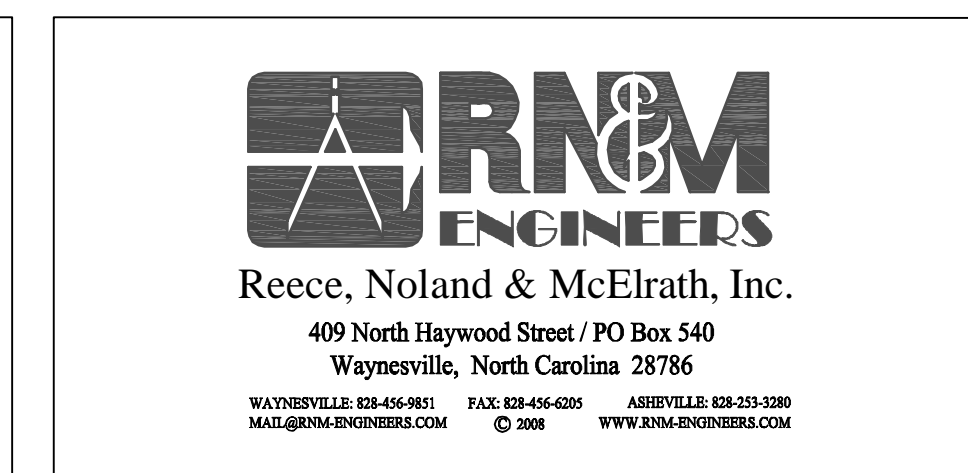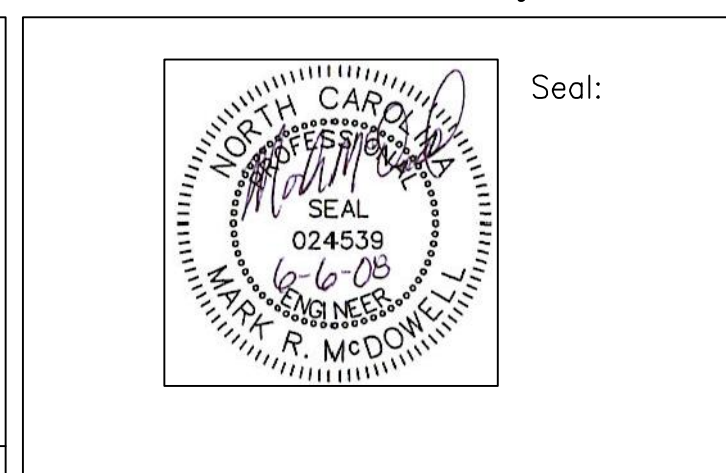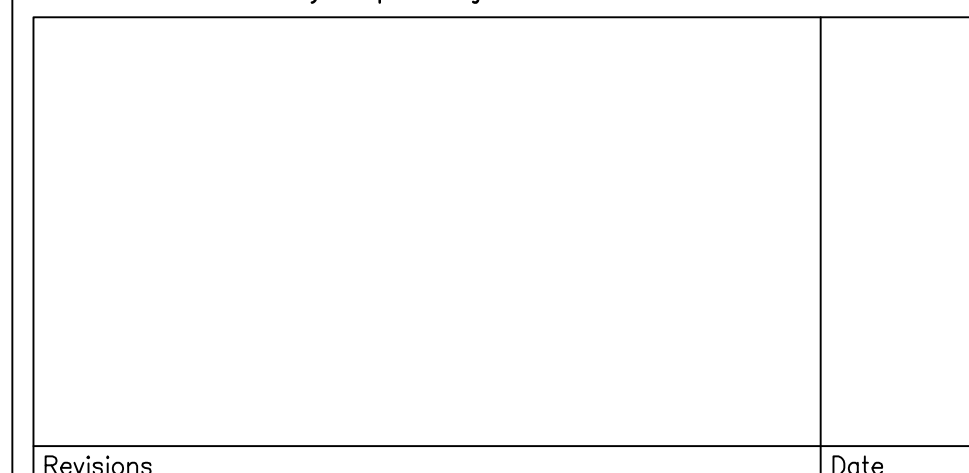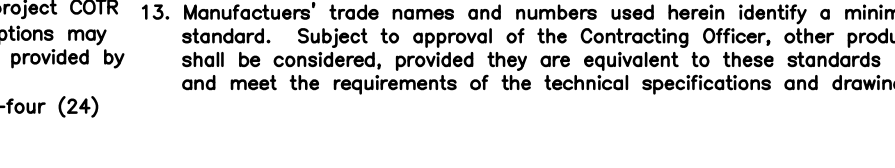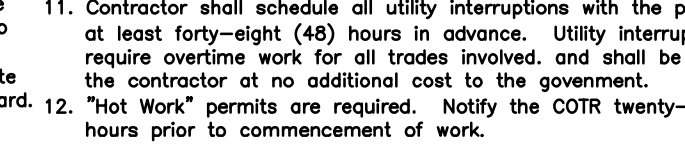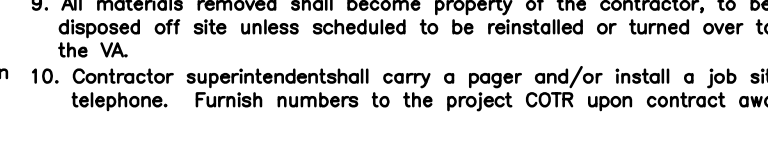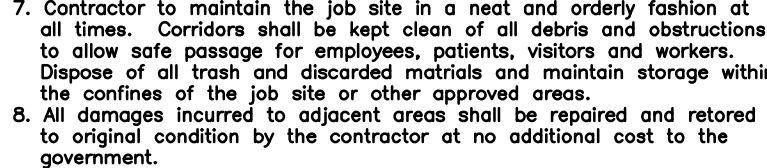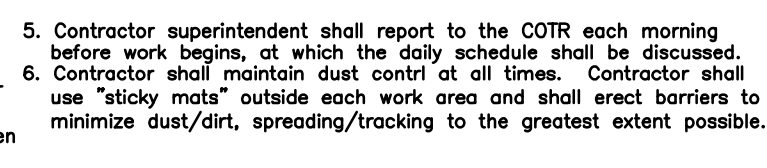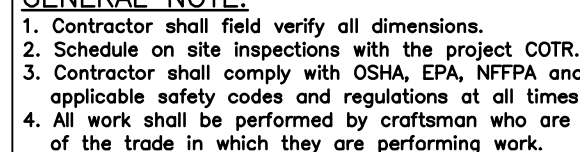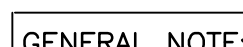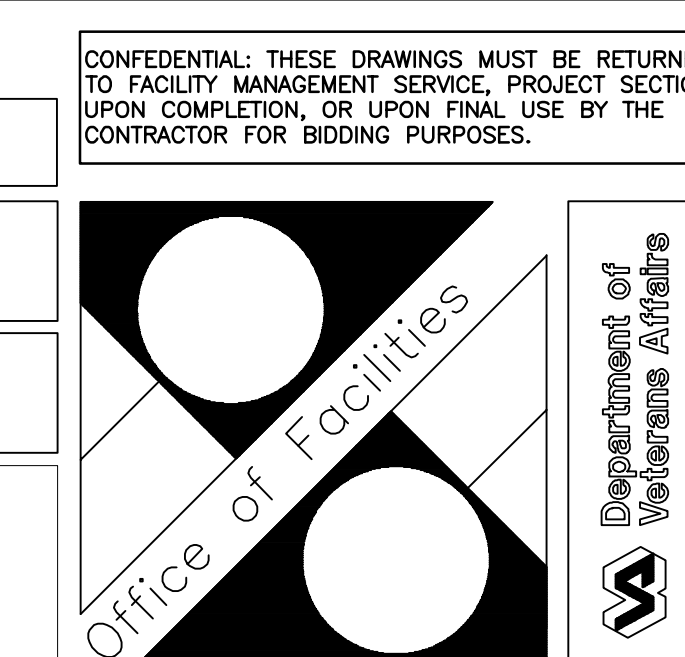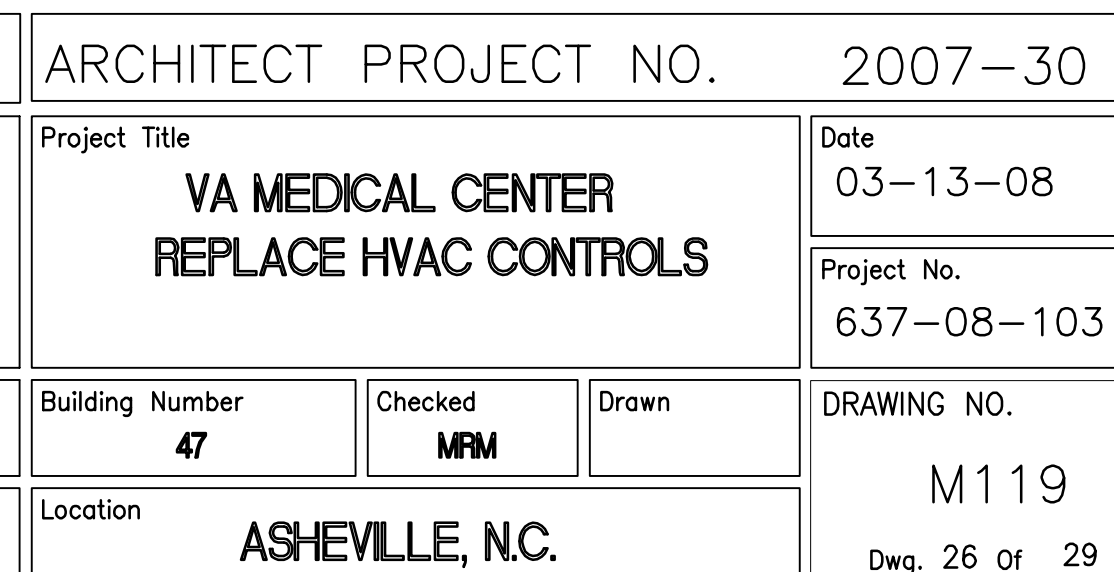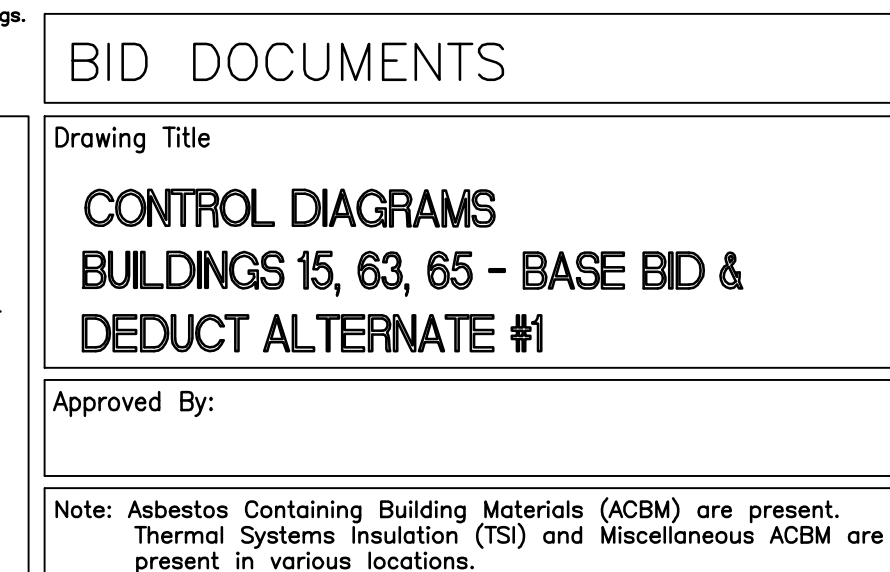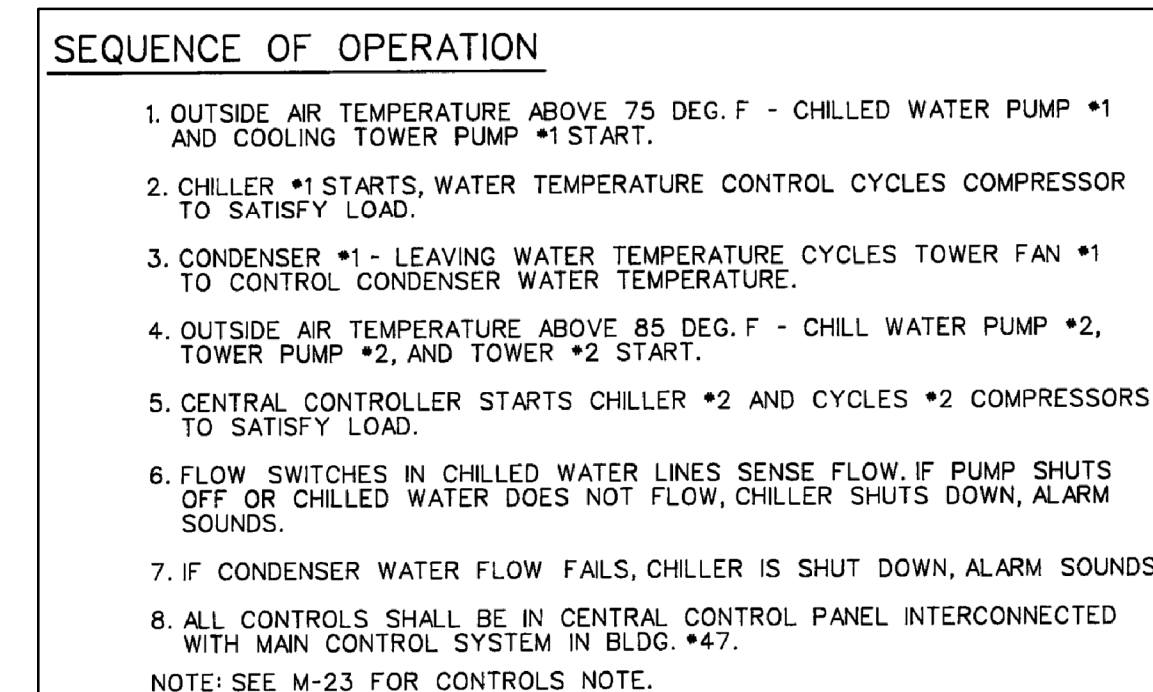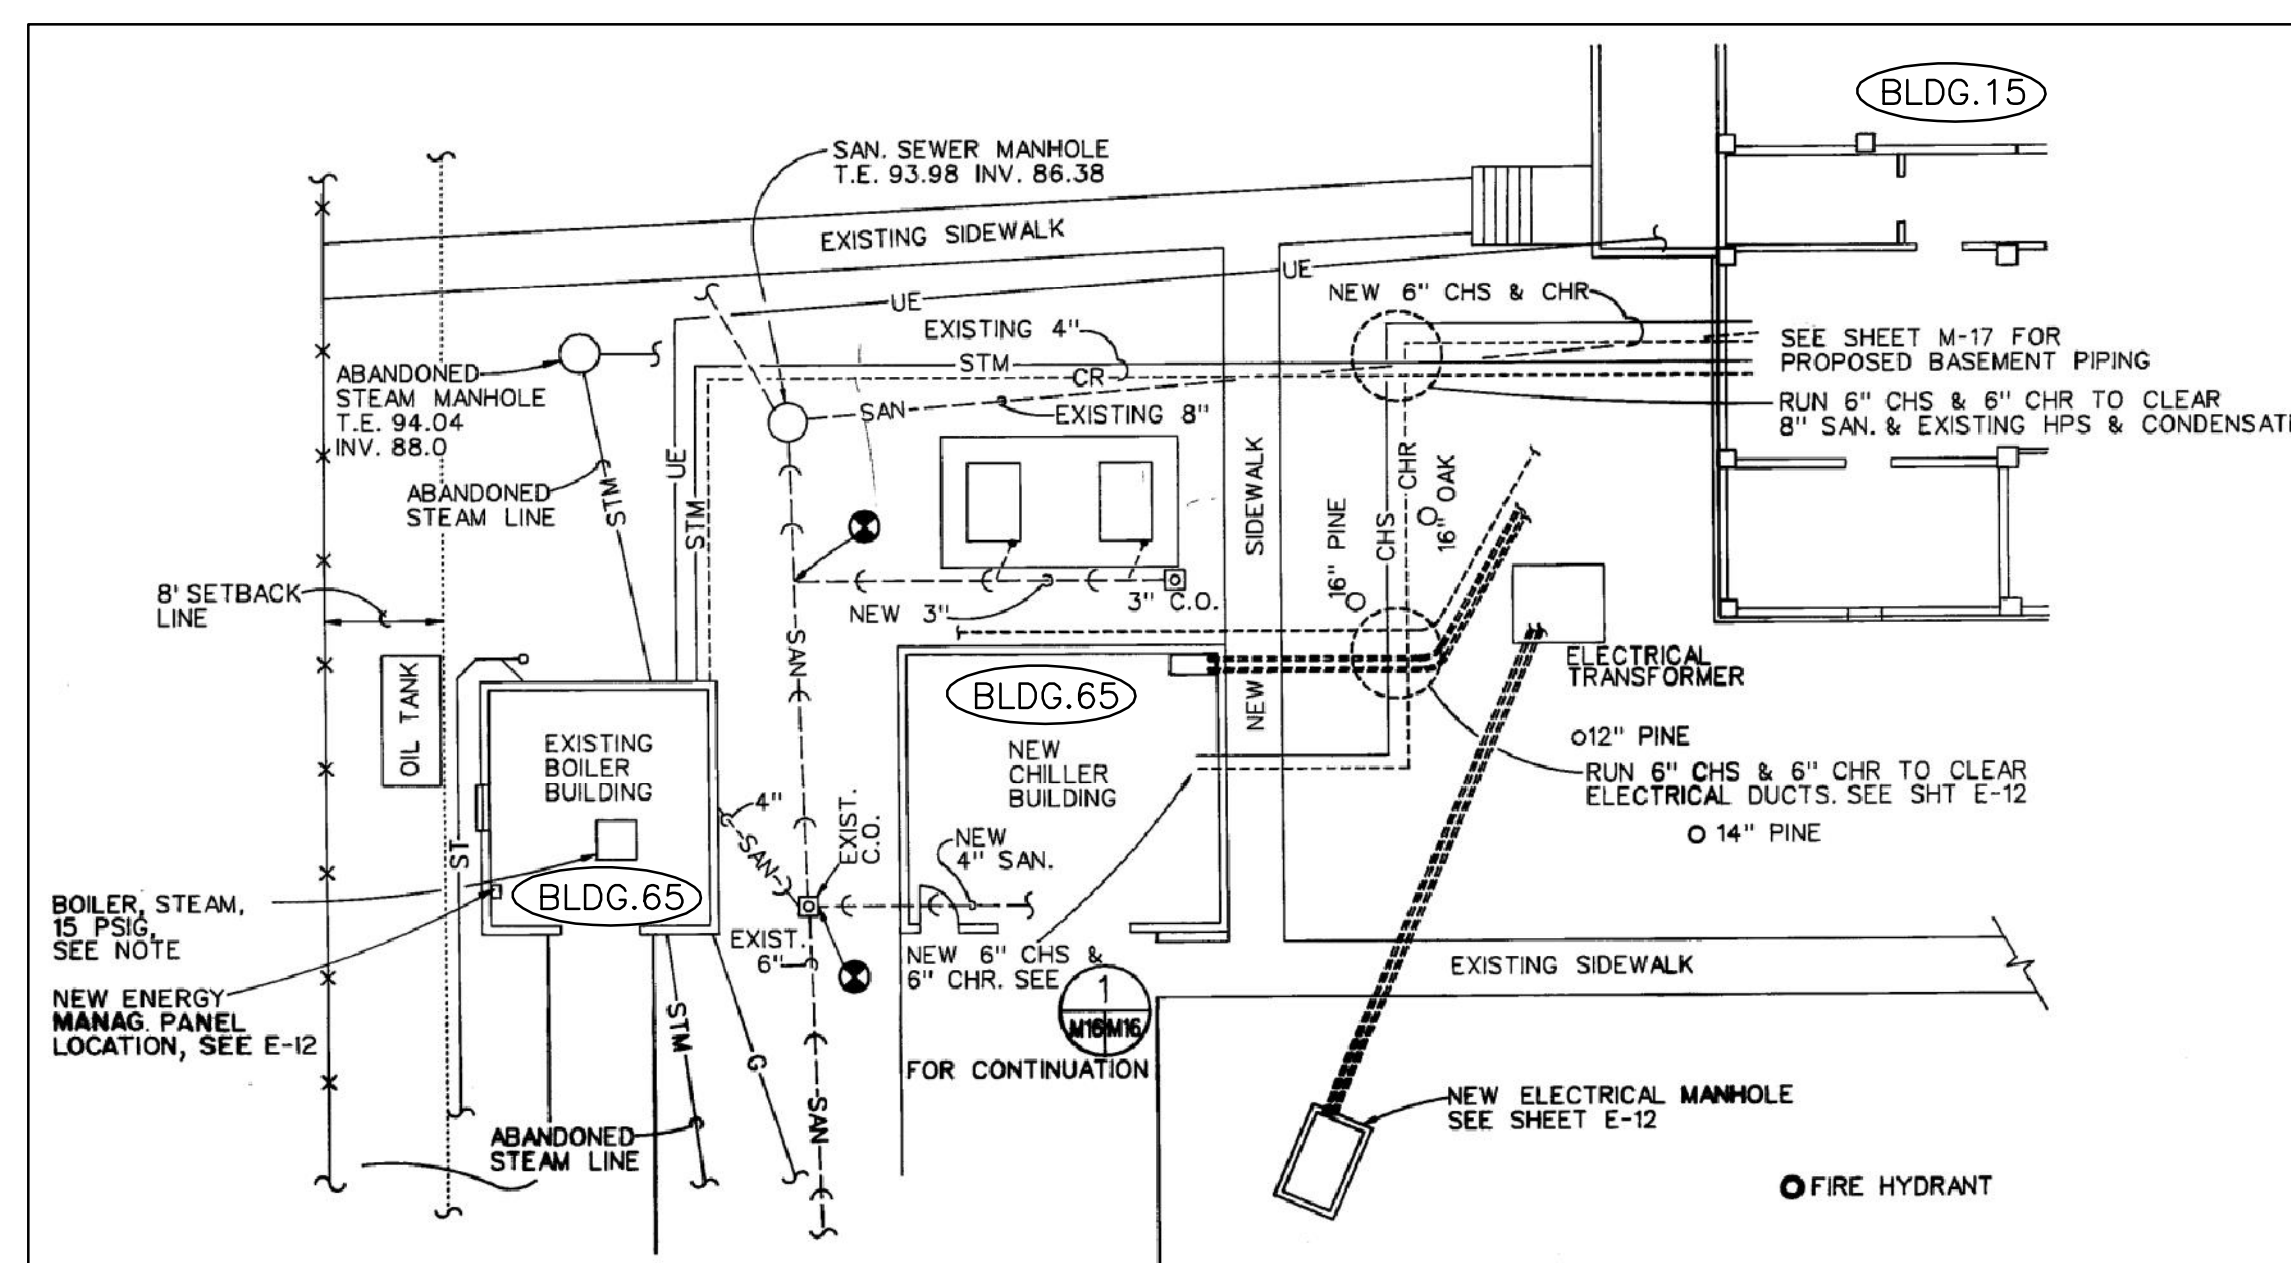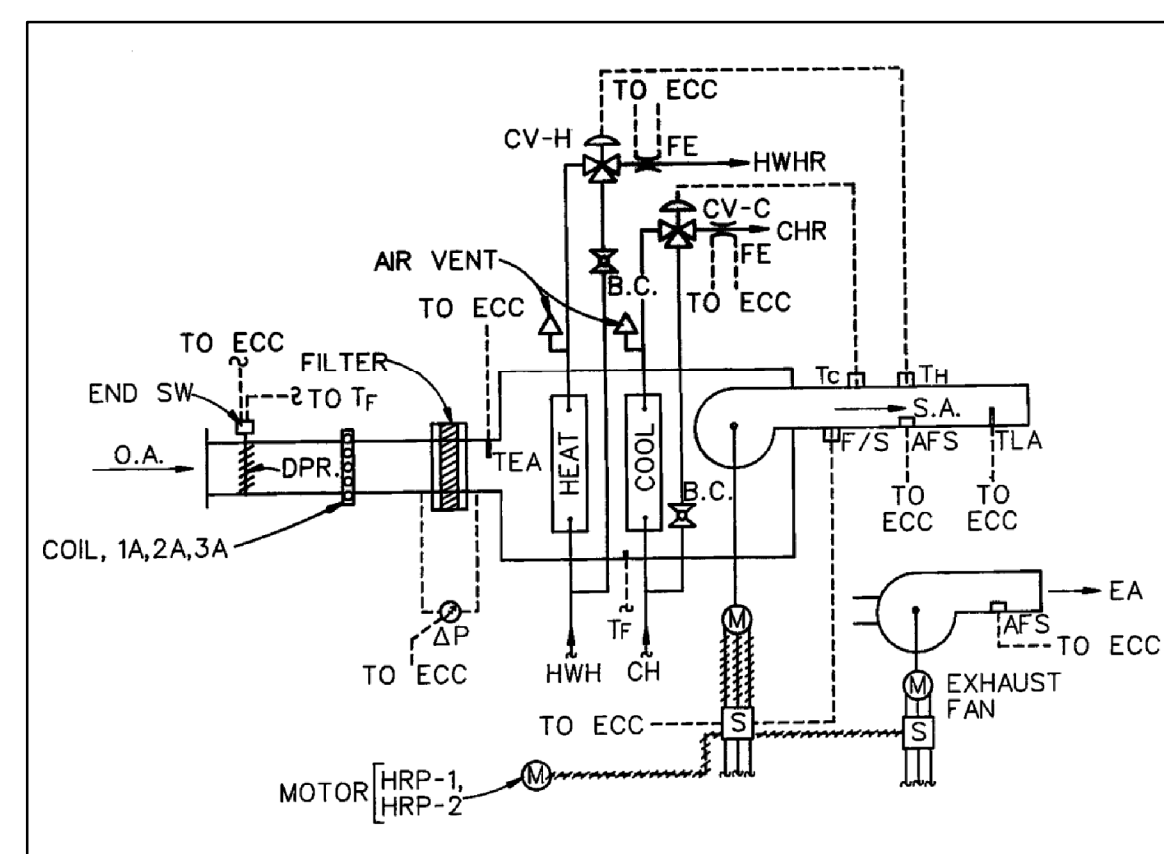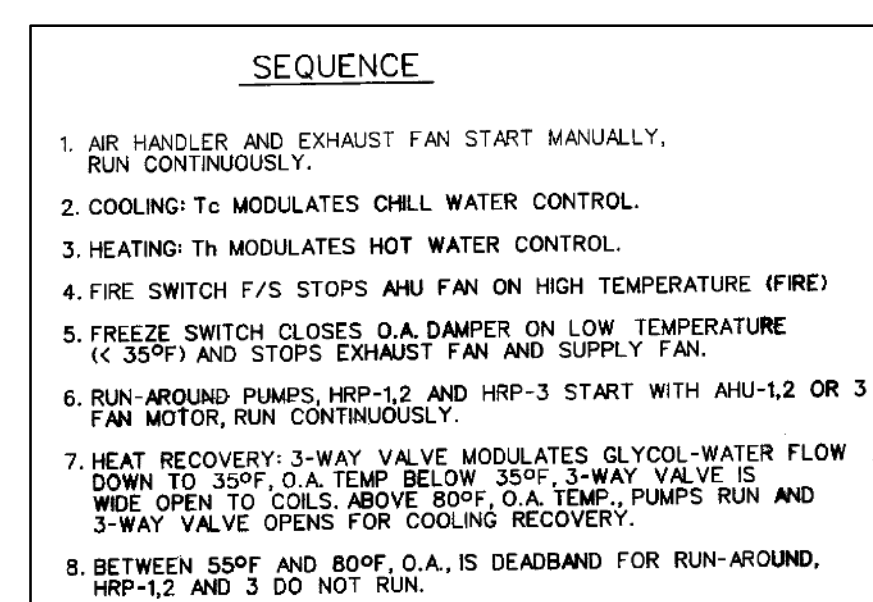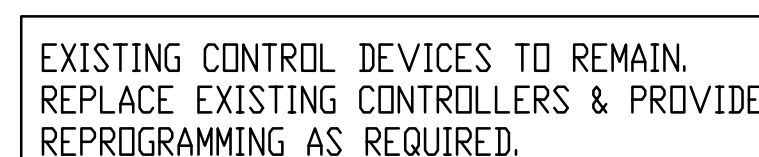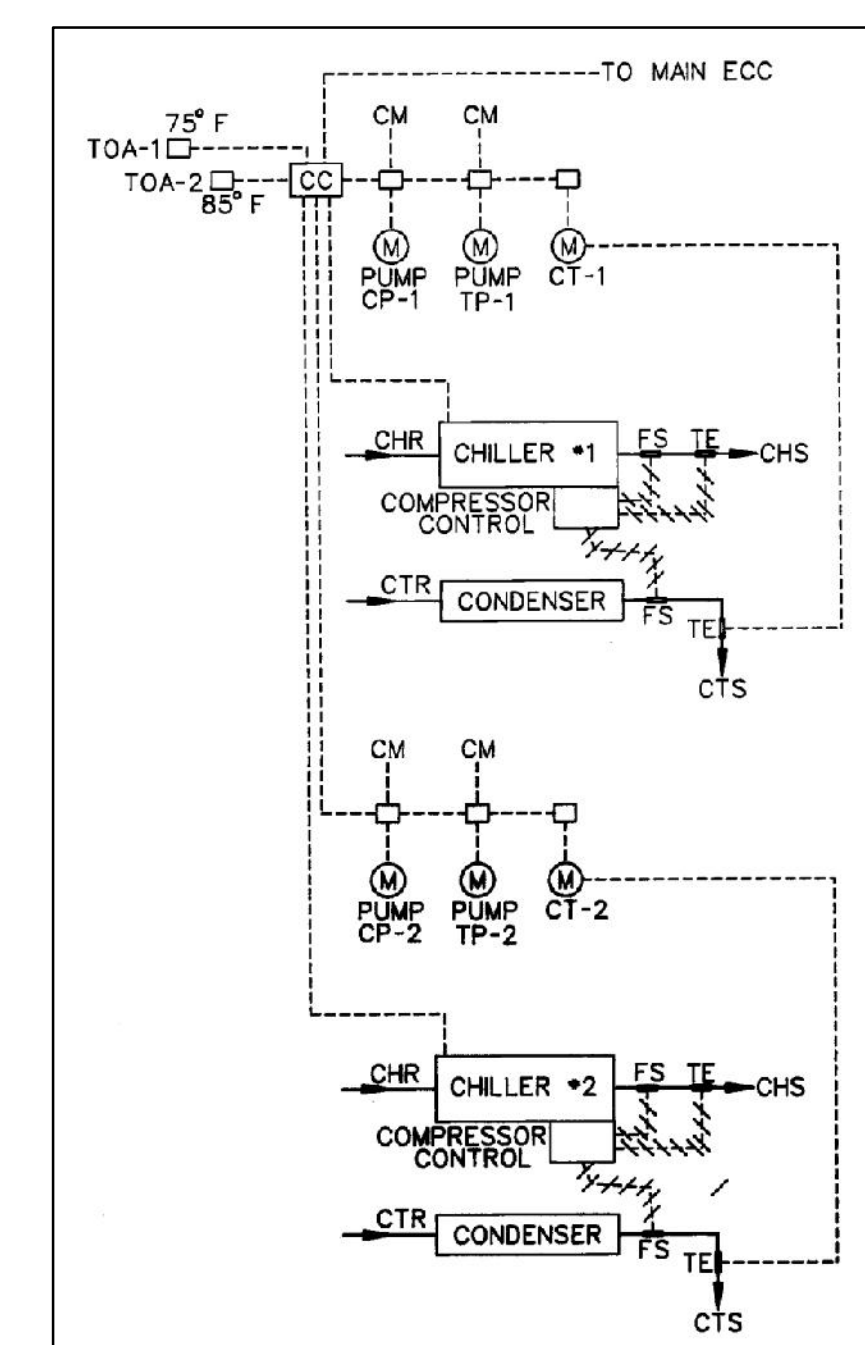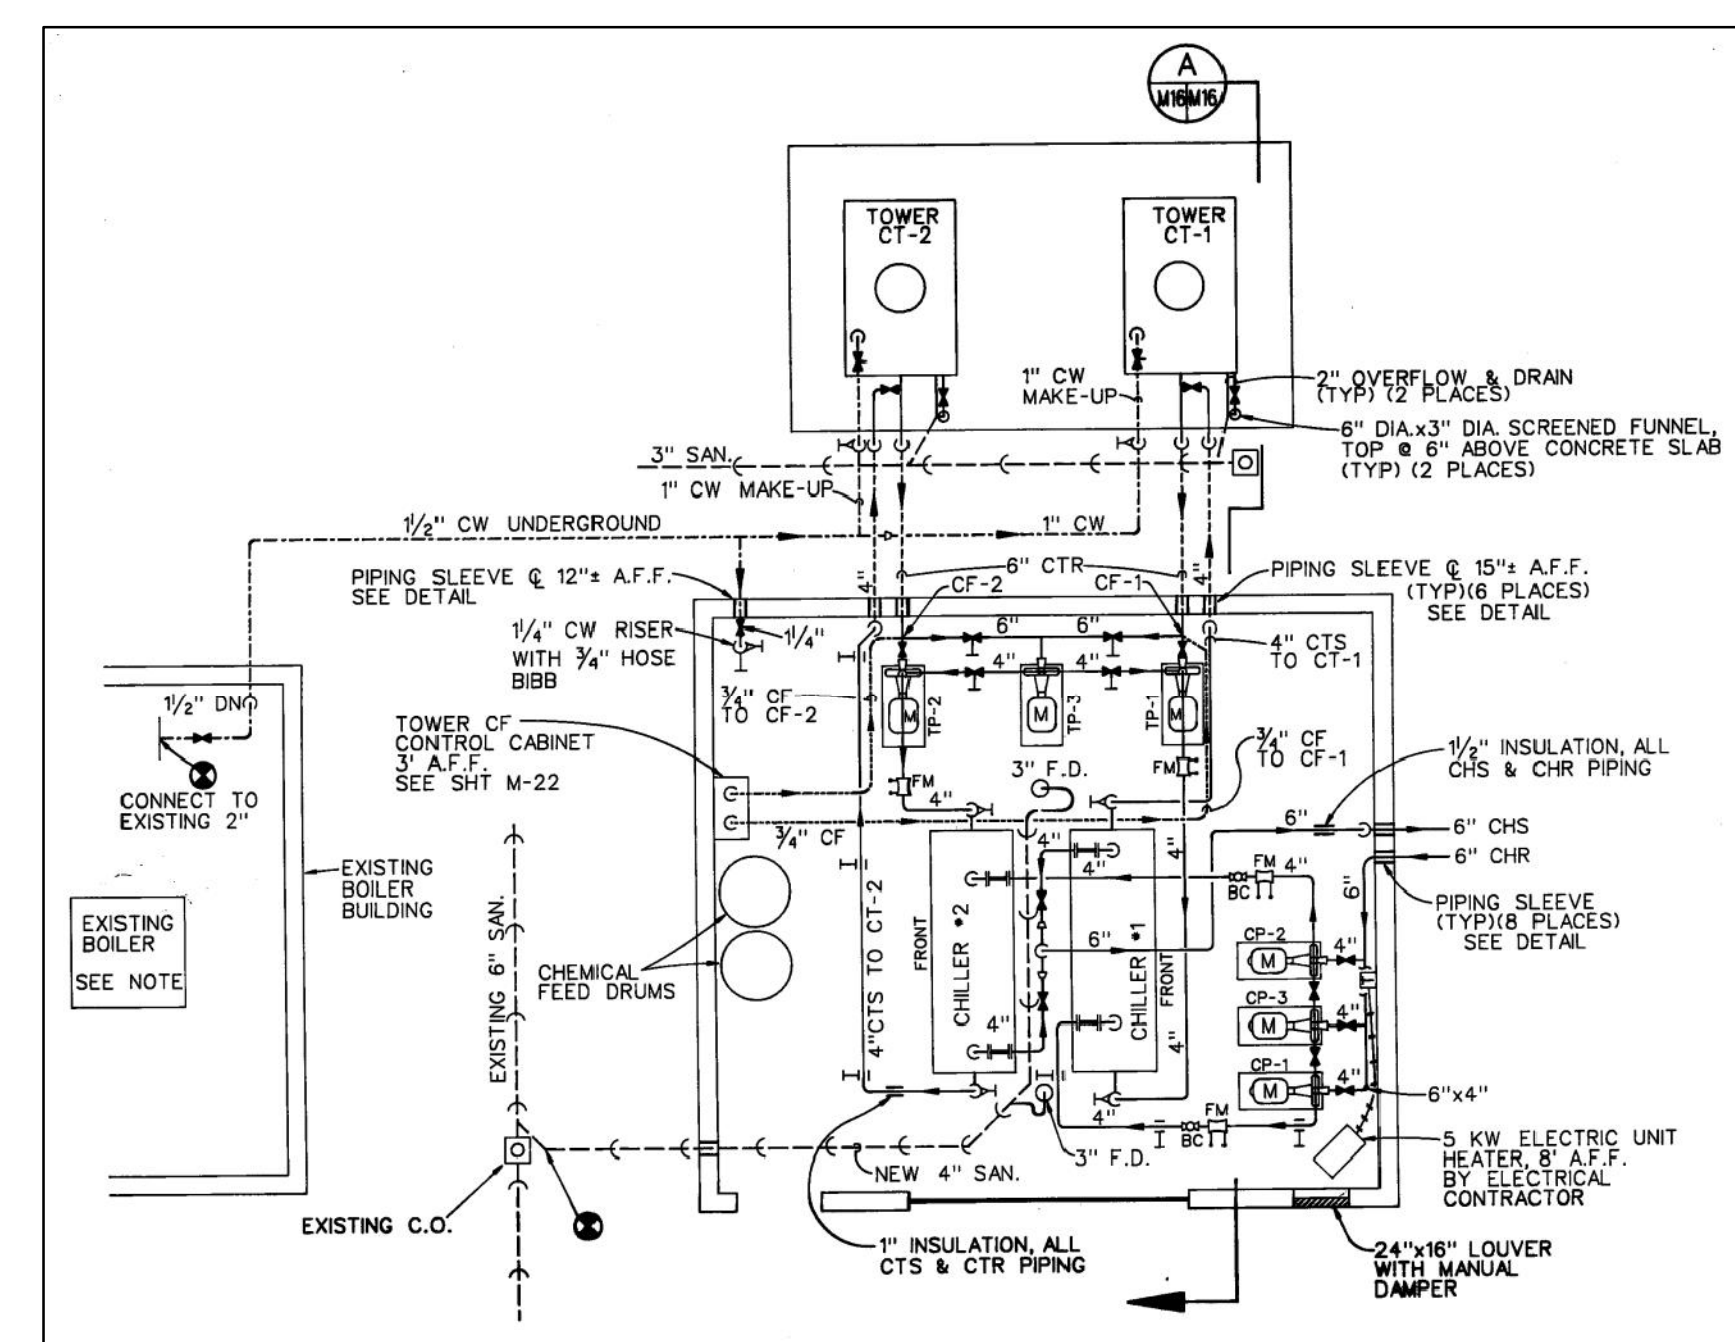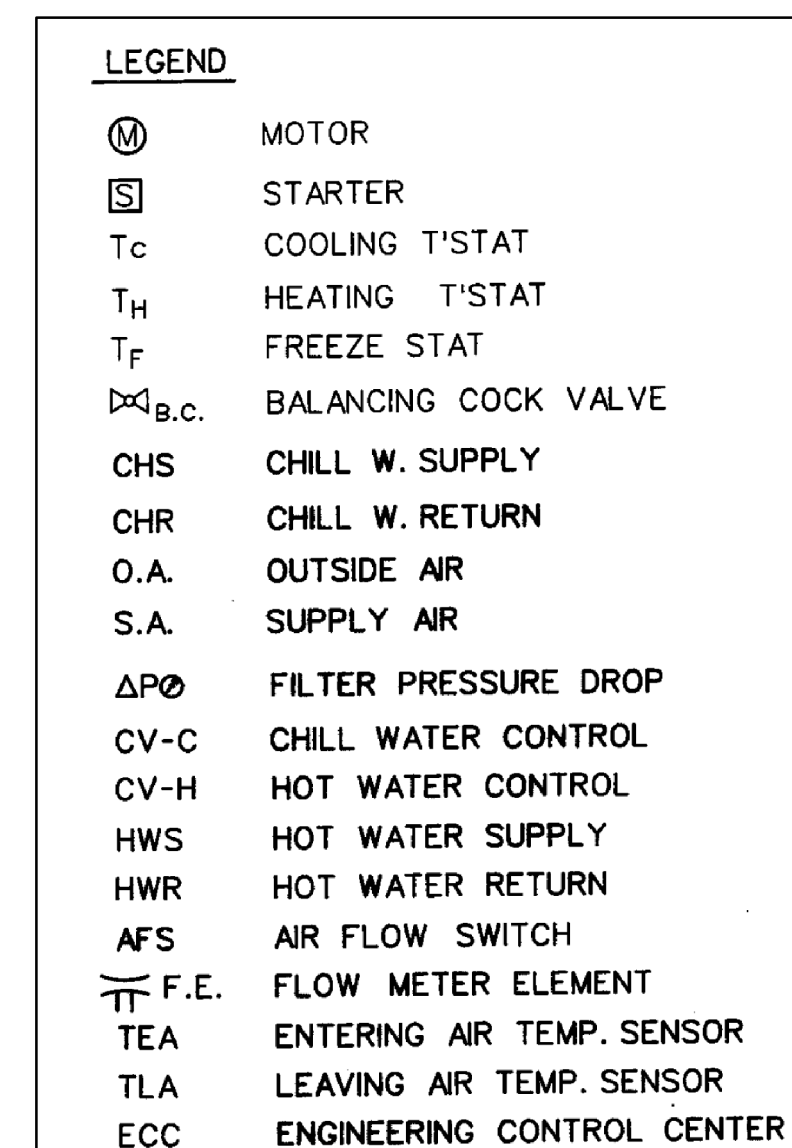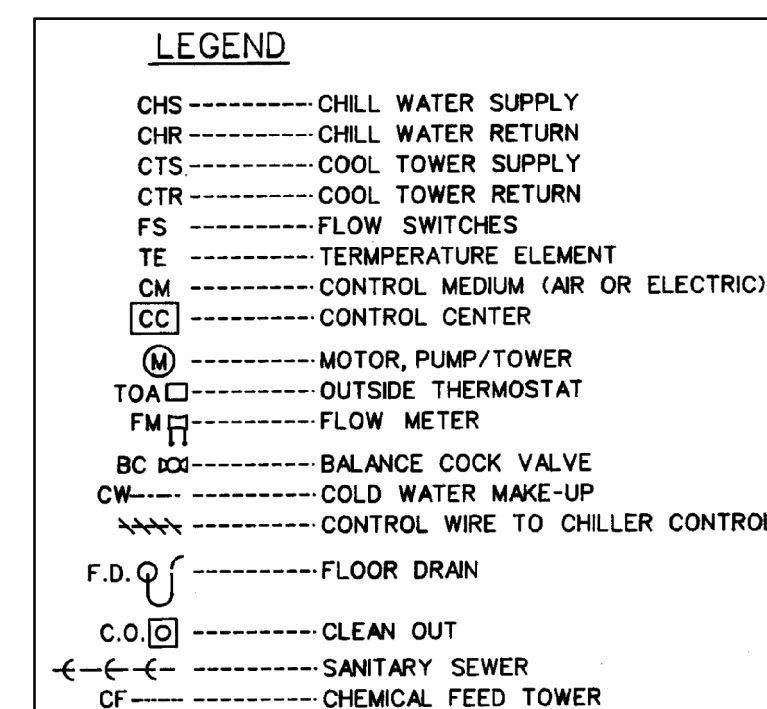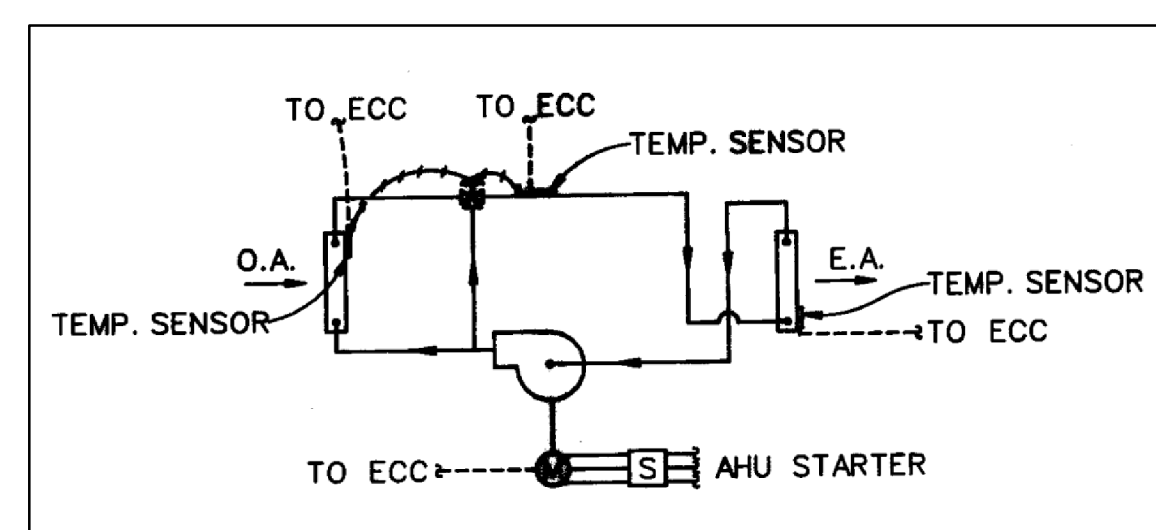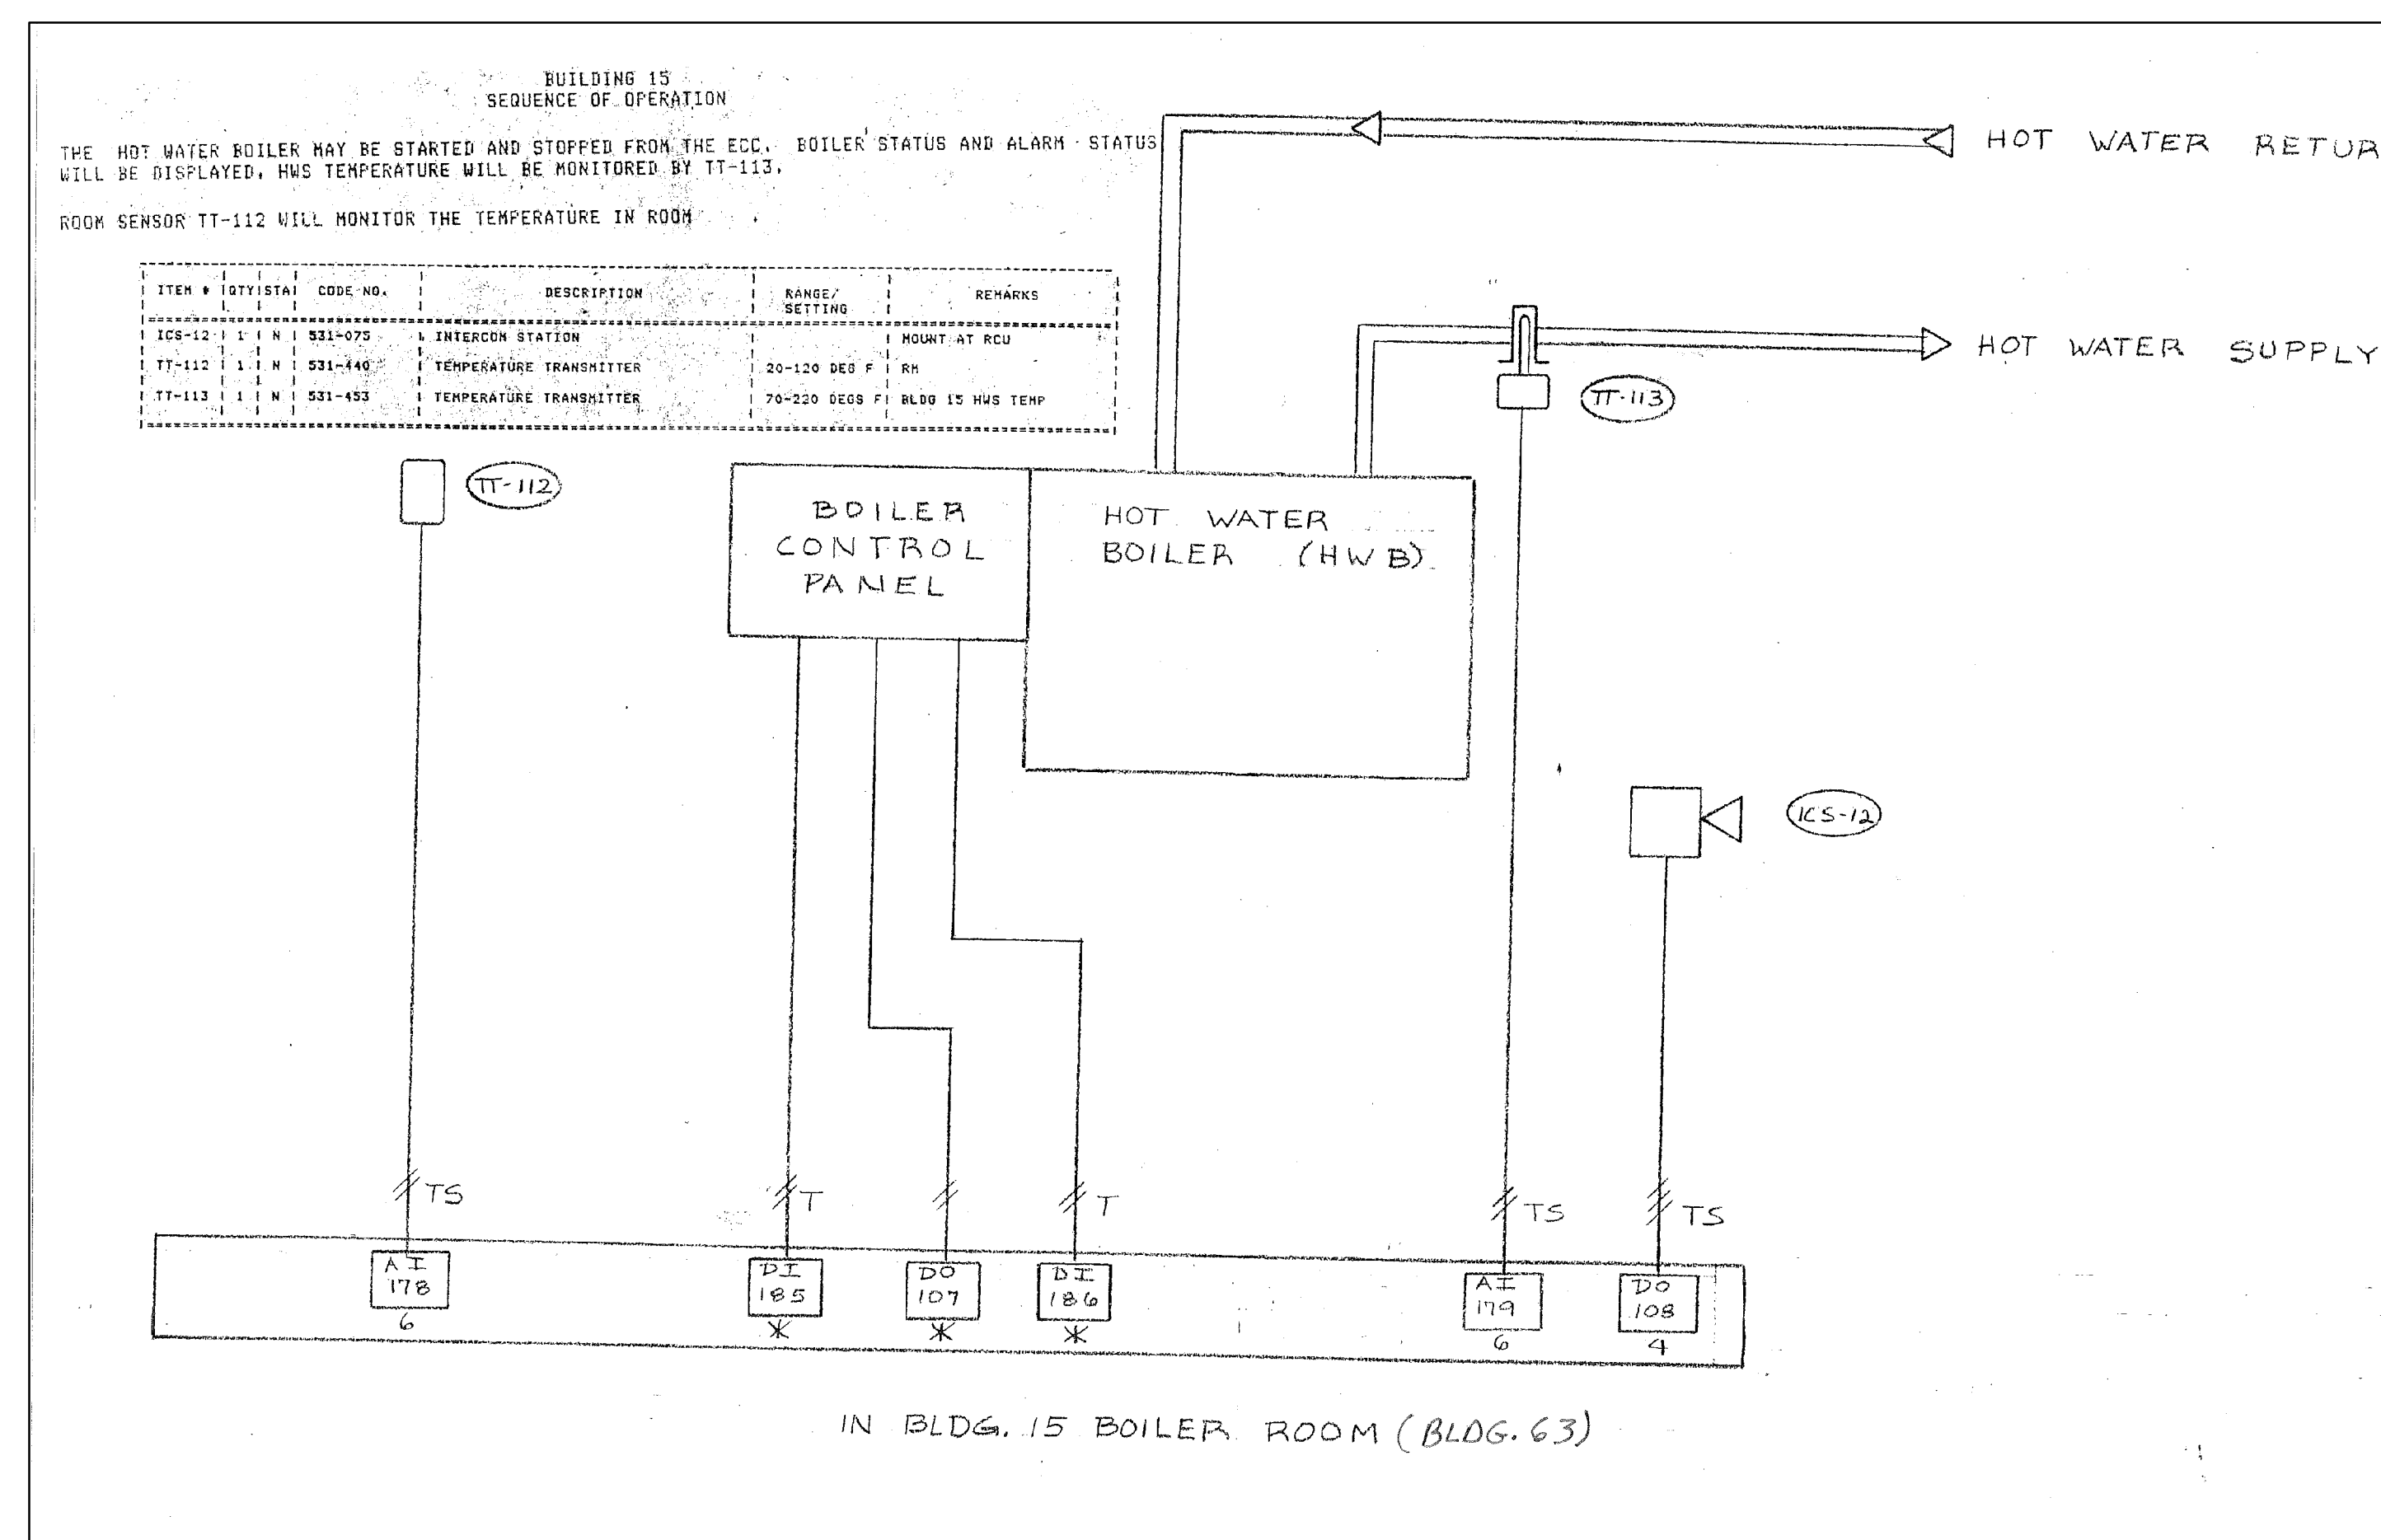

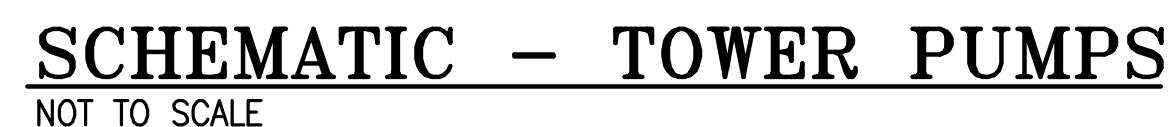

① NEW CONTROLS FOR 3 AHU's AND EXHAUST FANS (4TH FLOOR), 1 AHU AND EXHAUST FAN (BASEMENT), HW CONVERTOR SYSTEM (BASEMENT) AND CHILLER BUILDING EQUIPMENT SHALL BE DIRECT DIGITAL CONTROLS WITH PNEUMATIC OPERATORS. THESE SHALL BE COMPATIBLE WITH AND COMMUNICATE WITH THE EXISTING POWERS 600 EMS LOCATED IN BUILDING 47. THIS CONTROL AND COMMUNICATION SHALL BE VIA THE EXISTING LINES BETWEEN BUILDING 47 AND THE EXISTING BOILER BUILDING. (SHEET E-12 SHOWS THE LOCATION OF THE EXISTING ENERGY MANAGEMENT PANEL IN THE BOILER BUILDING) NEW PNEUMATIC PIPING AND INSTRUMENT AIR COMPRESSOR(S) WILL BE REQUIRED.

② THE CONTROLS CONTRACTOR SHALL BE RESPONSIBLE FOR WRITING, INSTALLING AND TRAINING VA PERSONNEL IN THE USE OF NEW CONTROL SYSTEMS GRAPHICS FOR THE EXISTING POWERS 600 EMS. GRAPHICS AND OPERATIONS FORMAT SHALL BE SIMILAR TO THE EXISTING GRAPHICS. PROGRAM SHALL HAVE "COMMENTS LINES", AND SHALL HAVE "PROCEDURES" (SUCH AS "SYSTEM SHUTDOWN", "MONDAY START-UP", ETC.) THAT CAN BE DONE VIA LIMITED KEYSTROKES. PEAK DEMAND CONTROL OF AHU's AND CHILLERS SHALL BE PROVIDED IF REQUESTED.

③ NEW ITEMS/FUNCTIONS THAT SHALL BE MONITORED/CONTROLLED BY THE EXISTING EMS ARE:

- I. AHU's AND EXHAUST FANS
 - A) OUTDOOR AIR TEMPERATURE
 - B) 4TH FLOOR PENTHOUSE AMBIENT TEMPERATURE
 - C) FILTER PRESSURE DIFFERENTIAL @ 4 AHU's
 - D) CHILLED WATER SEND TEMPERATURE @ 4 AHU's
 - E) CHILLED WATER RETURN TEMPERATURE @ 4 AHU's
 - F) CHILLED WATER COIL FLOW (IN GPM) @ 4 AHU's
 - G) HOT WATER SEND TEMPERATURE @ 4 AHU's
 - H) HOT WATER RETURN TEMPERATURE @ 4 AHU's
 - I) HOT WATER COIL FLOW (IN GPM) @ 4 AHU's
 - J) LEAVING AIR TEMPERATURE @ 4 AHU's
 - K) O/A DAMPER STATUS (FROM END SWITCH) @ 4 AHU's
 - L) SUPPLY AIR FAN STATUS (ON/OFF) AND PROOF (S.P. DOWNSTREAM) @ 4 AHU's
 - M) EXHAUST AIR FAN STATUS (ON/OFF) AND PROOF (S.P. UPSTREAM) @ 4 AHU's
 - N) DUCT SMOKE DETECTOR STATUS @ 4 AHU's
(SEE SHEETS M-11 AND M-15 FOR AHU SCHEMATIC)
- II. CHILLER AND ASSOCIATED EQUIPMENT
 - A) CHILLED WATER TEMPERATURE
 - B) FLOW SWITCH
 - C) FLOW METER
 - D) CHILLED WATER PUMP STATUS
 - E) TOWER PUMP STATUS
 - F) TOWER FAN STATUS
 - G) TOWER WATER TEMPERATURE
 - H) TOWER FLOW
 - I) CHEMICAL FEED STATUS
 - J) CHILLER BUILDING AMBIENT TEMPERATURE
(SEE SHEET M-22 FOR SCHEMATICS AND M-16 FOR SEQUENCE OF OPERATION)
- III. HOT WATER CONVERTER SYSTEM
 - A) HOT WATER SEND TEMPERATURE
 - B) HOT WATER FLOW IN GPM
 - C) STEAM PRESSURE
 - D) HOT WATER PUMP STATUS
 - E) CONDENSATE PUMP STATUS
(SEE M-17 FOR CONVERTOR SCHEMATIC AND OPERATING SEQUENCE)
- IV. MISCELLANEOUS
 - A) SENSE (ONLY) CORRIDOR TEMPERATURES AT/NEAR EACH FLOOR'S NURSE'S STATION, EAST END OF CORRIDOR AND WEST END OF CORRIDOR.

④ INDIVIDUAL ROOM FAN COIL UNITS SHALL HAVE LINE VOLTAGE ELECTRONIC THERMOSTATS AND ELECTRIC VALVES. NO INTERCONNECTION TO THE EXISTING POWERS 600 EMS IS REQUIRED. (SEE M-11, 12, 13, 14 FOR LOCATIONS)

num
ucts

BUILDING IS FULLY SPRINKLERED

BID DOCUMENTS		ARCHITECT PROJECT NO. 2007-30		UPON COMPLETION, OR UPON FINAL USE BY THE CONTRACTOR FOR BIDDING PURPOSES.	
Drawing Title CONTROL DIAGRAMS BUILDINGS 15, 63, 65 - BASE BID & DEDUCT ALTERNATE #1		Project Title VA MEDICAL CENTER REPLACE HVAC CONTROLS		Date 03-13-08	
Approved By:		Building Number 47		Checked MM	Drawn WTJ
Note: Asbestos Containing Building Materials (ACBM) are present. Thermal Systems insulation (TSI) and Miscellaneous ACBM are present in various locations.		Location ASHEVILLE, N.C.		Project No. 637-08-103	
				DRAWING NO. M120	
				Dwa. 27 Of 29	

Office of Facilities

Department of
Veterans Affairs

- LEGEND**
- Existing night low limit thermostat to be replaced with temperature sensor.
 - Existing overcall switch to remain.
 - Existing stand-by pump starter to remain.
 - Existing pump starter to remain.
 - Existing flow switch to remain.
 - Existing steam valve with pneumatic actuator to remain.
 - New water temperature sensor.
 - Existing integral relay to remain (typical of 21).
 - Existing 120/240 volt transformers to remain.
 - Existing relays to remain.
 - Existing cooling tower damper actuator to remain.
 - Existing cooling tower fan starter(s) to remain.
 - Existing cooling tower pump starter to remain.
 - New steam valve with pneumatic actuator.
 - New differential pressure switch.
 - New differential pressure switch.
 - New water temperature sensor.
 - New differential pressure switch.
 - Cooling tower basin freeze protection failure alarm.
 - New CT's, PT's, and KW transducer to measure electrical usage.

LEGEND
NO SCALE

Input/Output Summary

System, Apparatus, or Area Point Description	Analog		Binary		Commandable		System Features		General	Supplementary Notes
	Measured	Calc.	Pos.	Grad.	Pos.	Grad.	Alarms	Programs		
BUILDING #14										SEE 475M52.4.1
ROOM #										
CIRCULATING PUMP										
STAND-BY CIRC. PUMP										
HEAT EXCHANGER										
HEAT PUMPS										
COOLING TOWER FAN										
COOLING TOWER PUMP										
BASEBOARD HEAT										
SUPPLY WATER										
RETURN WATER										
EXHAUST FANS										Typical of 4
OUTSIDE AIR										
COOLING TOWER BASIN										
WATER TEMPERATURE										

INPUT / OUTPUT SUMMARY
NOT TO SCALE

EXISTING CONTROL DEVICES TO REMAIN.
REPLACE EXISTING CONTROLLERS & PROVIDE
REPROGRAMMING AS REQUIRED.

BUILDING 14 HVA/C
SEQUENCE OF OPERATION

Water source heat pump air handling units 1 through 23 will be individually controlled from ECC.

Exhaust fans 1, 2, 3 and 4 will be stopped and started for occupied periods. Air handling units will operate continuously, when thermostat selector switch placed in continuous position for occupied periods.

When heat pumps are operational water circulating pumps 1 or 2 will operate as selected. During unoccupied periods low limit temperature will be maintained either by activating steam baseboard convectors control system when outside temperatures below 20°F, or by activating water source heat pump system when outside ambient above 30°F to maintain 60°F minimum temperature inside building spaces.

An overall time switch will activate heat pump system when building used during unscheduled periods.

When heat pump system activated compressors will be interlocked by time delay to insure water flow through loop before activating.

Zone thermostats will operate heat pumps in heating or cooling mode as needed to maintain temperature. Fans will cycle in auto position and operate continuously from programmed schedule in continuous position.

When activated by outside air temperature below 50° room thermostat will control steam valves to perimeter baseboard heat convectors.

If water loop temperature drops below 60°F, heat will be added by modulating convector steam valve. Between 60°F and 90°F steam valve is closed and cooling tower is off. If water loop temperature rises above 90°F, the ECC will sequence the cooling tower controls as follows:

- 1st Stage - Open Damper - 92°F
- 2nd Stage - Start Spray Pump - 95°F
- 3rd Stage - Start Fan - 98°F

The above sequence will reverse as loop temperature begins to drop. Temperature alarms at 50°F and 101°F and system shut down below/above 48° and 102°.

When temperature in solar collectors is higher than loop/storage collector pump will start and operate until temperature approaches equal, during season when heat can be utilized from storage. During cooling season, collectors will be de-focused and circulating pump will operate only as may be required to prevent overtemperature of glycol loop.

ALTERNATE 2 - SOLAR:

ECC will compare temperature in solar collectors and storage tank. When collector temperature exceeds storage temperature, Pump No. 1 will start and circulate glycol until temperatures equalized. Time delay will be employed to prevent short cycling.


If storage exceeds optimum temperature for season, then cooling tower will operate to reject excess heat as required. Preferably at night, it sufficient to prevent overheating.

Winter cycle maintains storage as high as possible (90°F range) without exceeding 100°F. Summer cycle cool storage, at night, cool as possible (60°F range) by utilizing cooling tower and/or collector circulation to reject heat.

Spring and fall cycles maintain storage between 60° and 90° to provide optimum water temperature for heating and/or cooling as applicable, without rejecting or adding (steam) heat, if sufficient in storage to provide for next day's normal use, considering season, days (normal work, weekend, holiday, etc.), and unit efficiencies at water temperature present.

Provide high temperature alarms and operator instruction, especially when focusing and de-focusing needed.

SEQUENCE OF OPERATIONS
NO SCALE

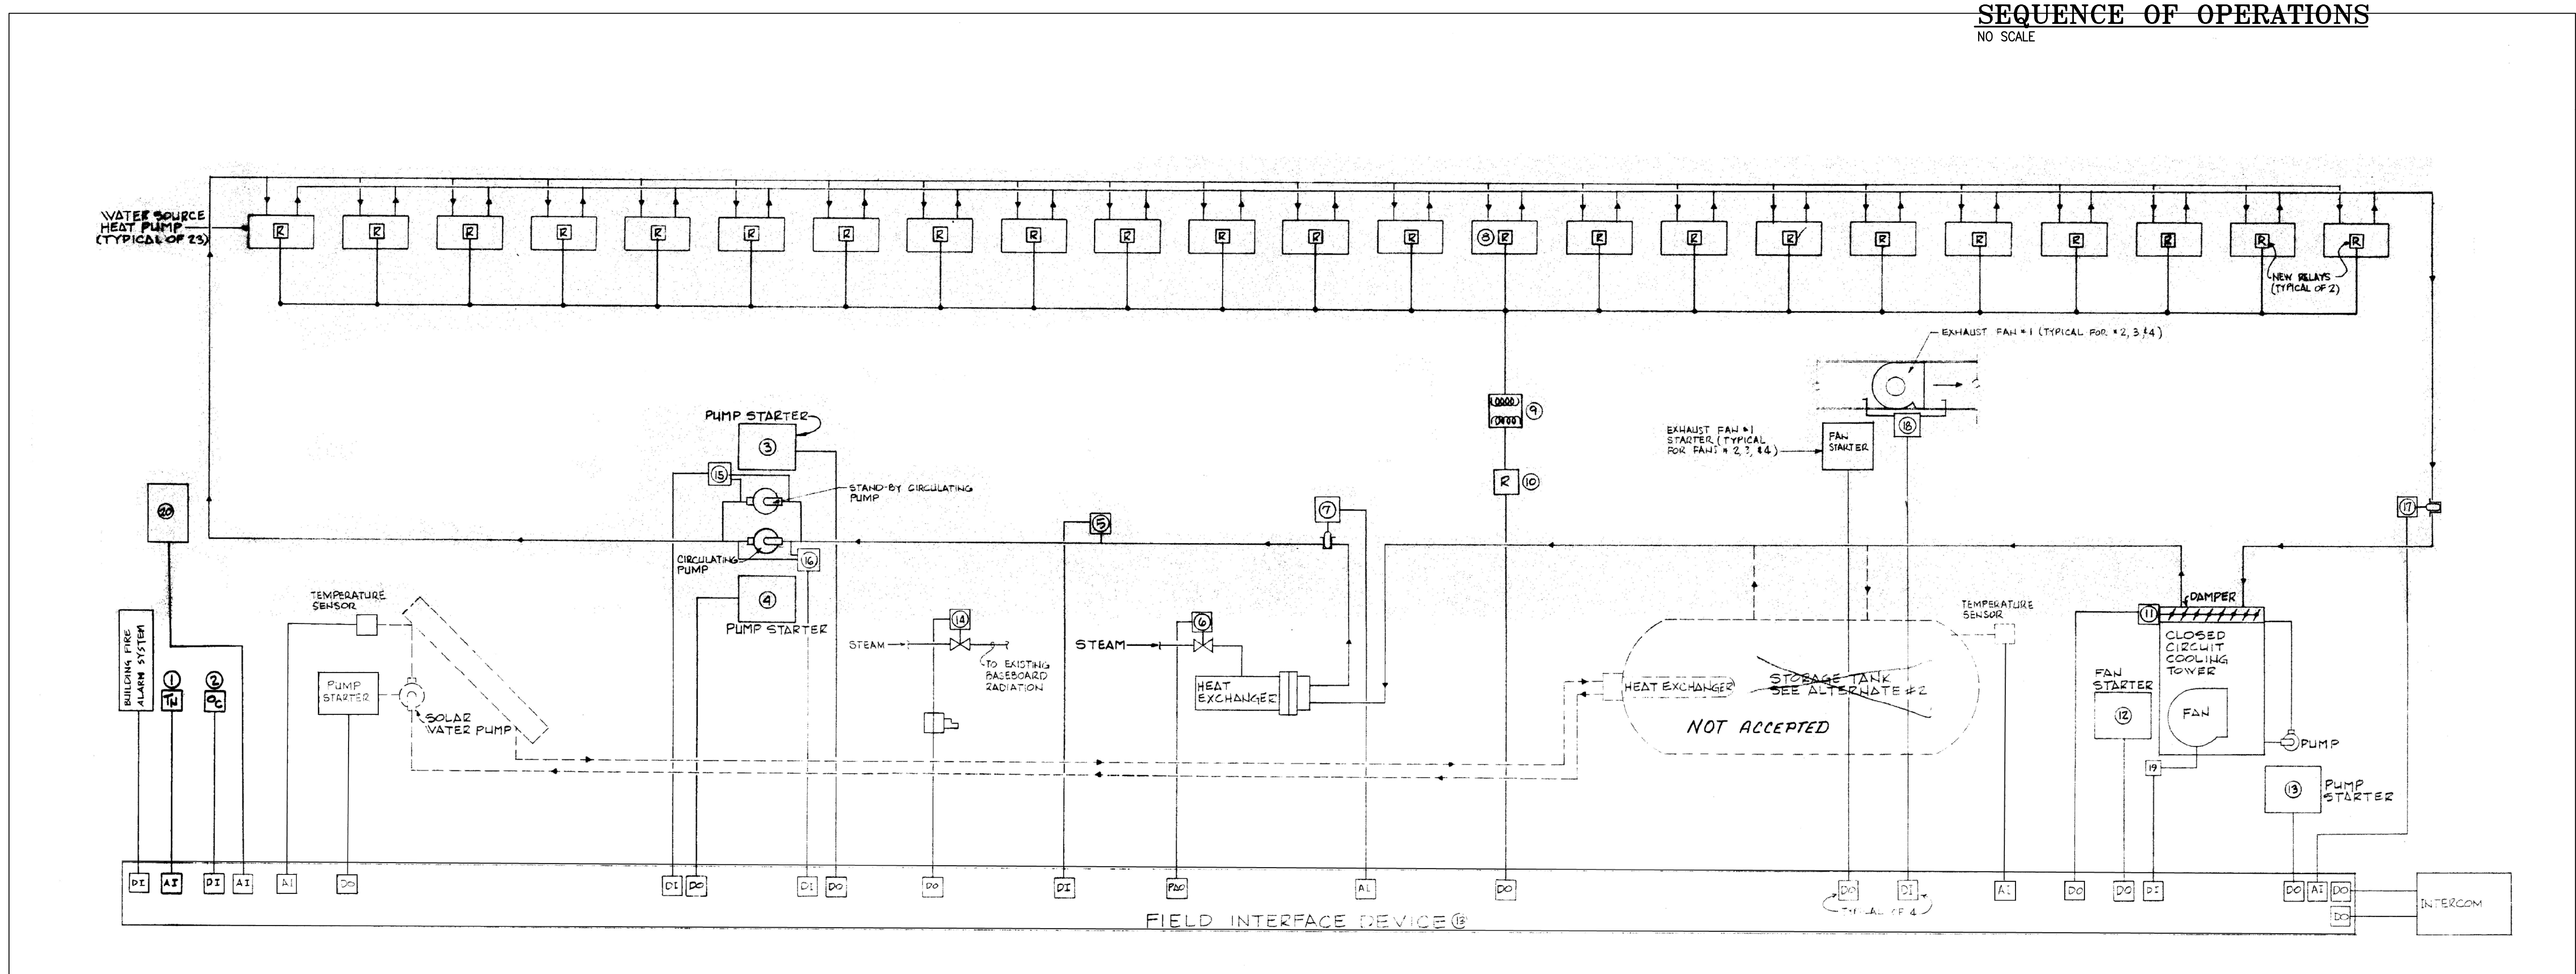

SCHEMATIC
NOT TO SCALE

GENERAL NOTE:

- Contractor shall field verify all dimensions.
- Schedule on site inspections with the project COTR.
- Contractor shall comply with OSHA, EPA, NFPA and all other applicable safety codes and regulations at all times.
- All work shall be performed by craftsmen who are journeymen of the trade in which they are performing work.
- Contractor superintendent shall report to the COTR each morning before work begins, at which the daily schedule shall be discussed.
- Contractor shall maintain dust control at all times. Contractor shall use "tidy mats" outside each work area and shall erect barriers to minimize dust/dirt, spreading/tracking to the greatest extent possible.
- Contractor to maintain the job site in a neat and orderly fashion at all times. Corridors shall be kept clean of all debris and obstructions to allow safe passage for employees, visitors and workers. Dispose of all trash and discarded materials and maintain storage within the confines of the job site or other approved areas.
- All damage incurred to adjacent areas shall be repaired and restored to original condition by the contractor at no additional cost to the government.
- All materials removed shall become property of the contractor, to be disposed off site unless scheduled to be reinstated or turned over to the VA.
- Contractor superintendent shall carry a pager and/or install a job site telephone. Furnish numbers to the project COTR upon contract award.
- Contractor shall schedule all utility interruptions with the project COTR at least forty-eight (48) hours in advance. Utility interruptions may require overtime work for all trades involved, and shall be provided by the contractor at no additional cost to the government.
- "Hot Work" permits are required. Notify the COTR twenty-four (24) hours prior to commencement of work.
- Manufacturers' trade names and numbers used herein identify a minimum standard. Subject to approval of the Contracting Officer, other products shall be considered, provided they are equivalent to these standards and meet the requirements of the technical specifications and drawings.

BUILDING IS FULLY SPRINKLERED

BID DOCUMENTS	ARCHITECT PROJECT NO.	2007-30
Drawing Title CONTROL DIAGRAMS BUILDING 14 - BASE BID & DEDUCT ALTERNATE #1	Project Title VA MEDICAL CENTER REPLACE HVAC CONTROLS	Date 03-13-08
Approved By:	Building Number 47	Checked MRM
Note: Asbestos Containing Building Materials (ACBM) are present. Thermal Systems Insulation (TSI) and Miscellaneous ACBM are present in various locations.	Location ASHEVILLE, N.C.	Drawn M121

Revisions

Date	
------	--

Seal:

RM & M ENGINEERS
Reece, Noland & McElrath, Inc.
409 North Haywood Street / PO Box 540
Waynesville, North Carolina 28786
WAYNESVILLE 828-454-8801 FAX 828-424-4200
MAY 2008


batson architects
Greenville Commons 220 N. Main Street, Suite 403 Greenville, South Carolina 29601 864.233.2232

POWER PLANT
QUAD 'D' QUAD 'A'
QUAD 'C' QUAD 'B'
KEY PLAN


ASHEVILLE, N.C.

CONFIDENTIAL: THESE DRAWINGS MUST BE RETURNED TO FACILITY MANAGEMENT SERVICE, PROJECT SECTION, UPON COMPLETION, OR UPON FINAL USE BY THE CONTRACTOR FOR BIDDING PURPOSES.

Office of Facilities
Department of Veterans Affairs

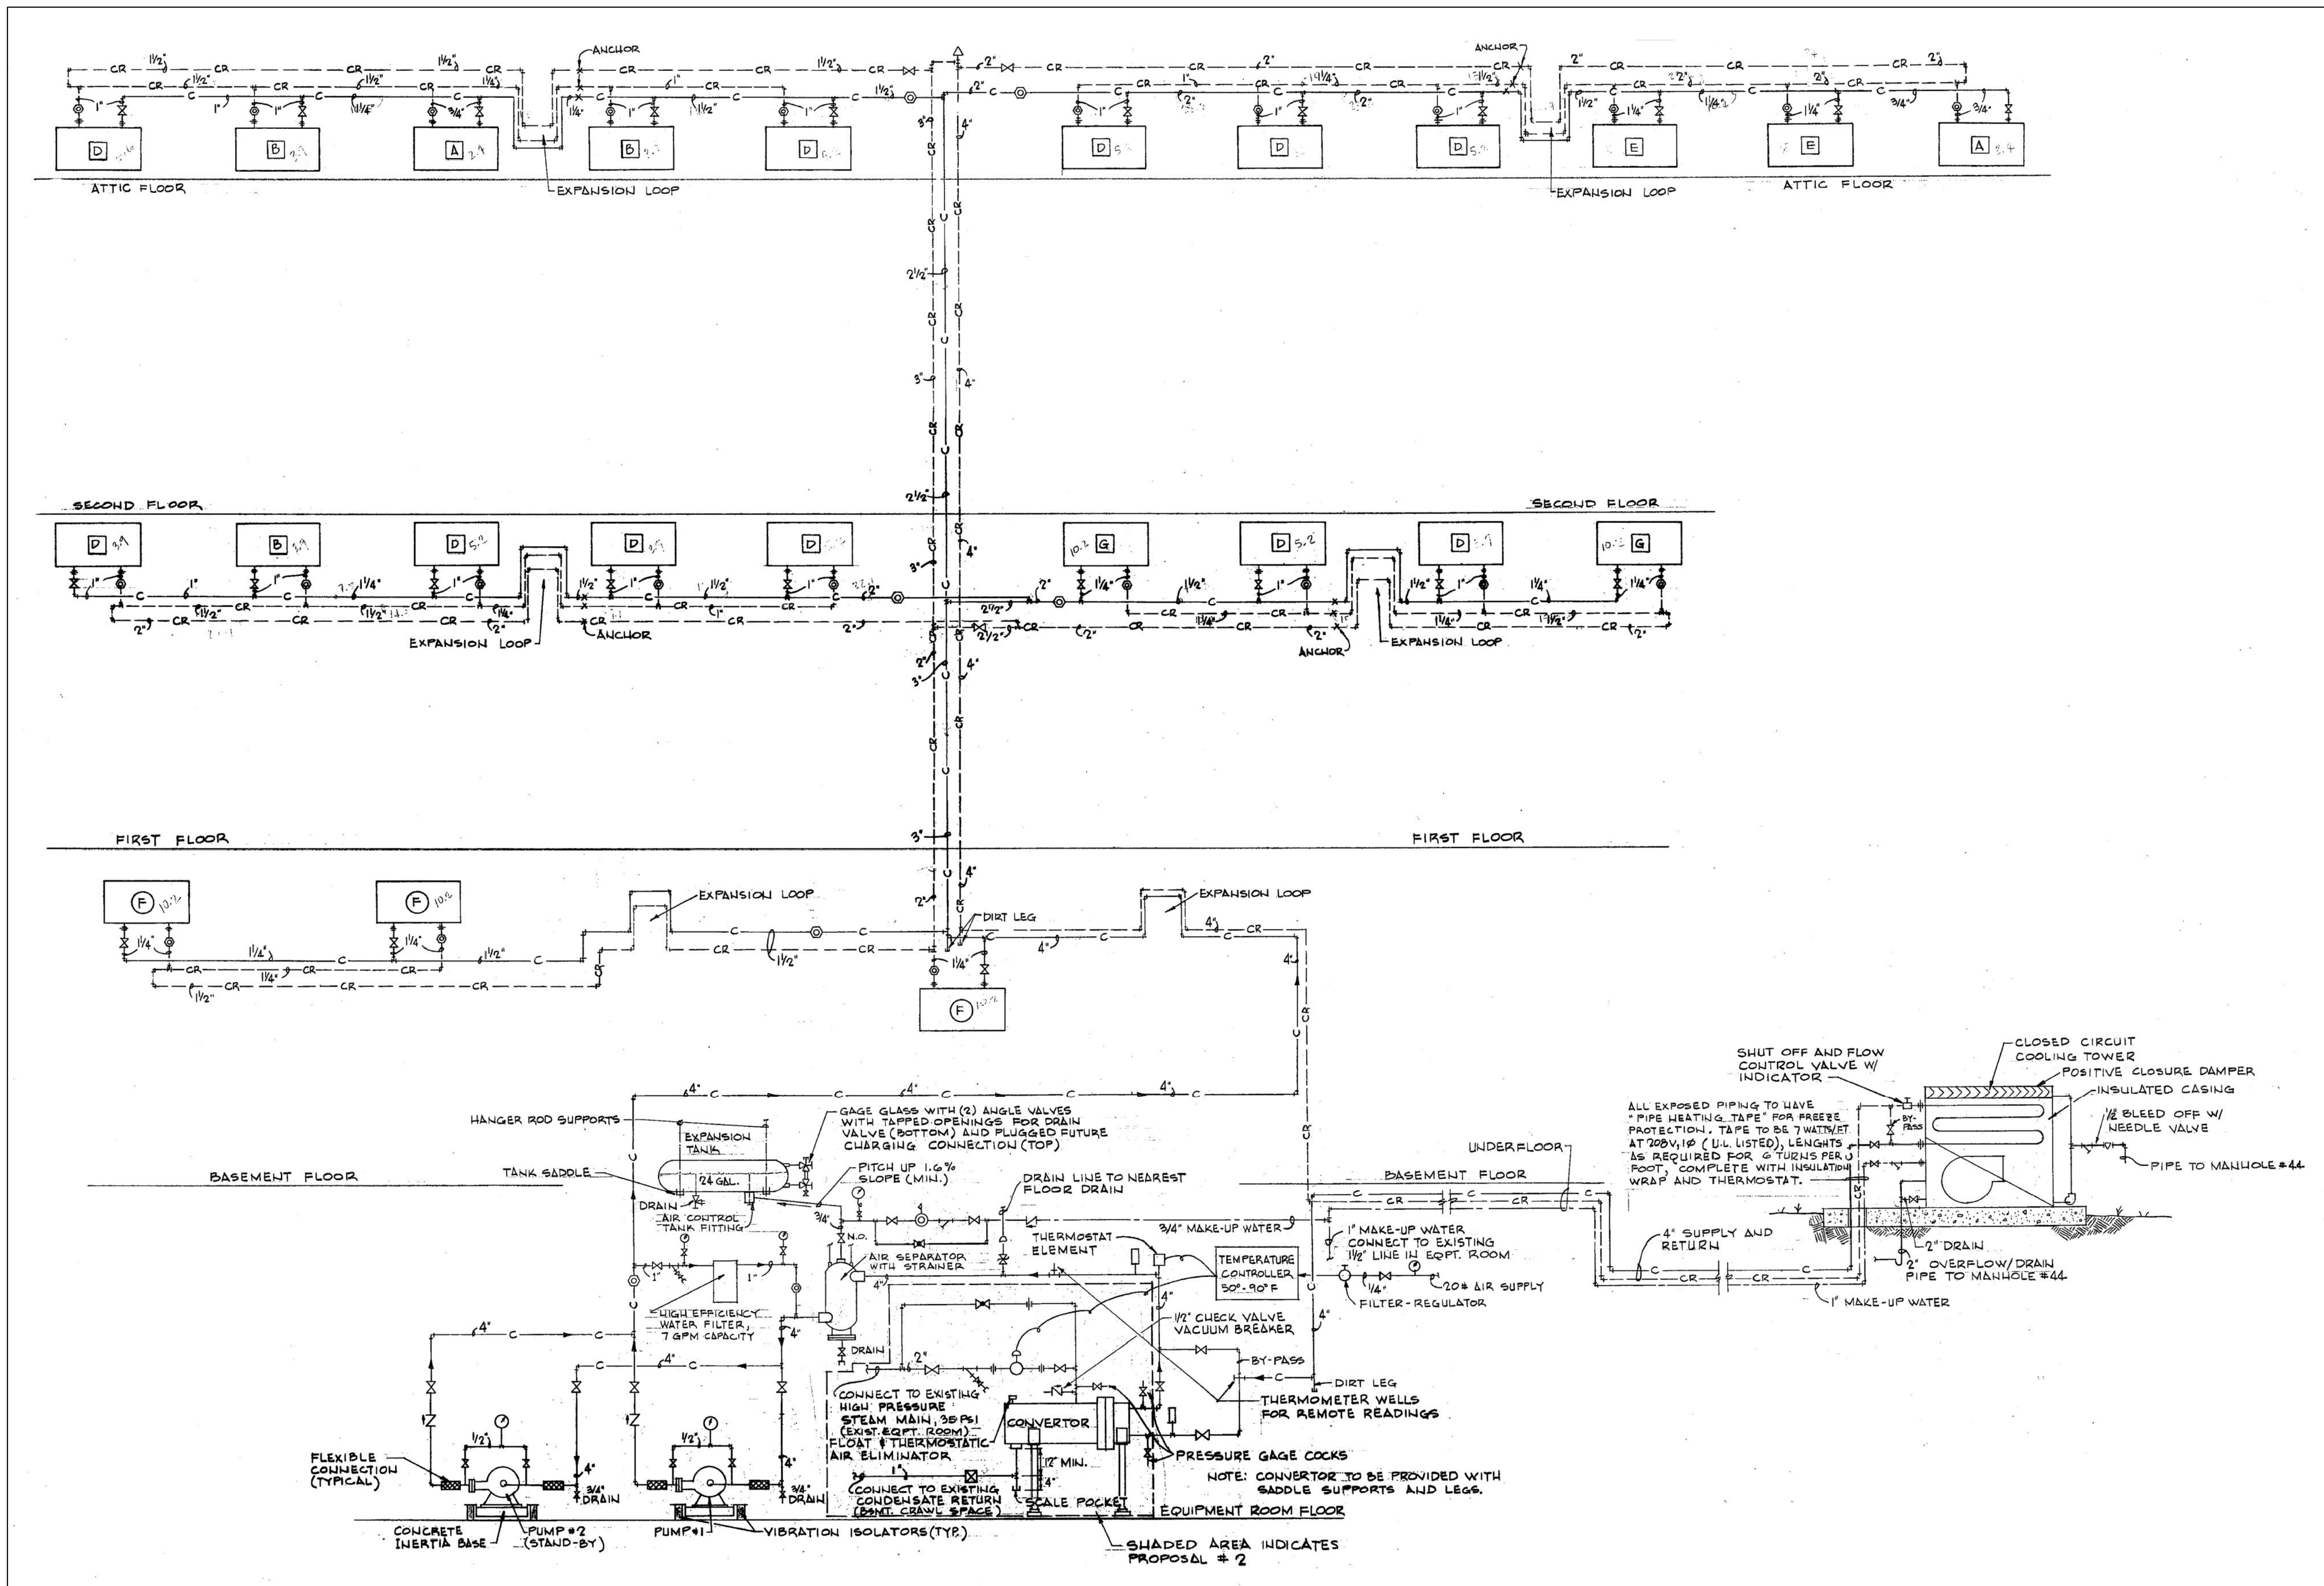

PIPING DIAGRAM
NOT SCALE

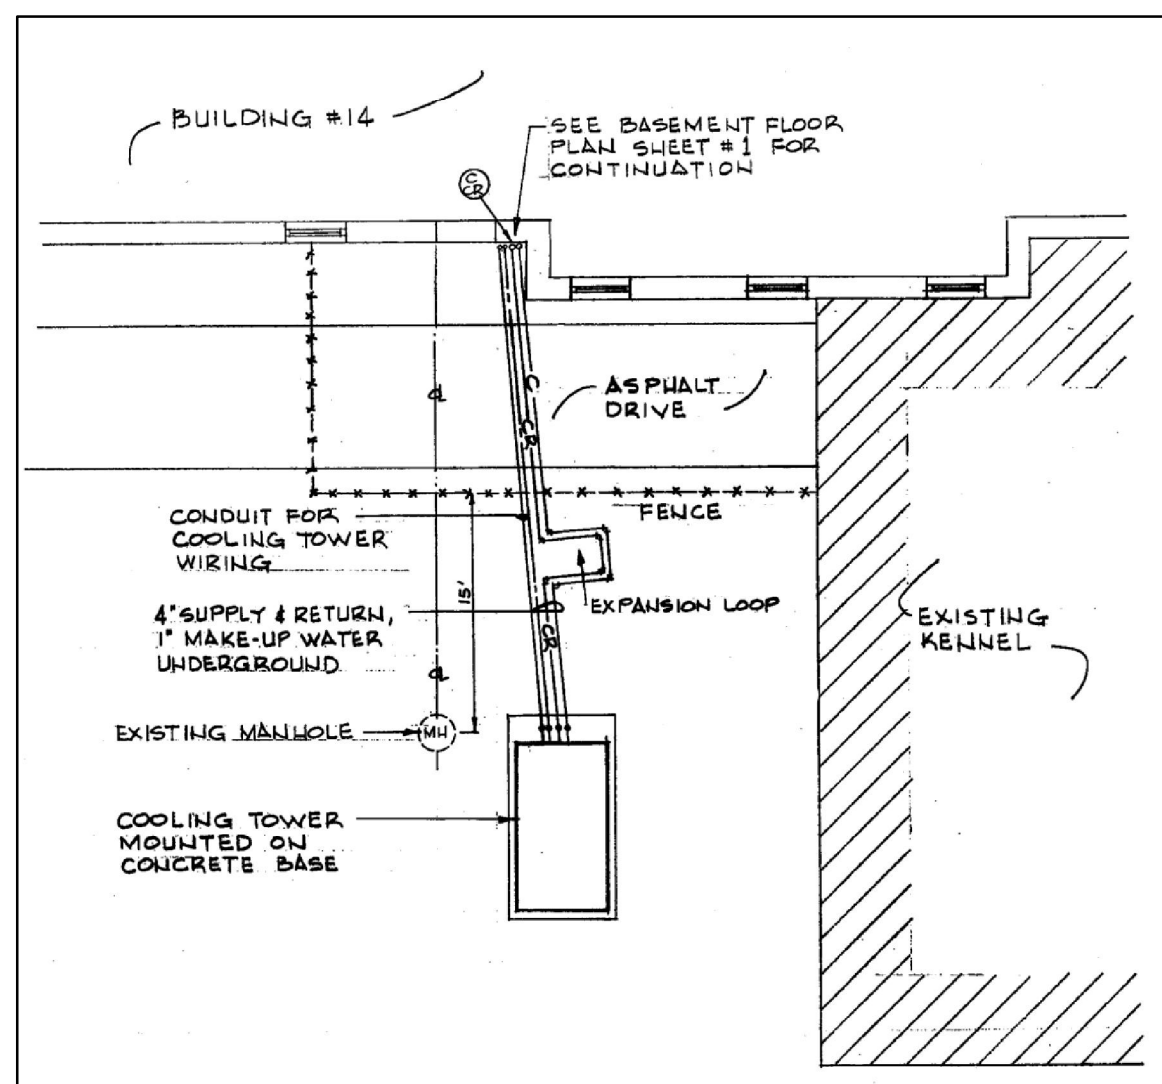

PARTIAL SITE PLAN
NOT TO SCALE

EXISTING CONTROL DEVICES TO REMAIN.
REPLACE EXISTING CONTROLLERS & PROVIDE
REPROGRAMMING AS REQUIRED.

GENERAL NOTE:

- Contractor shall field verify all dimensions.
- Schedule on site inspections with the project COTR.
- Contractor shall comply with OSHA, EPA, NFPA and all other applicable safety codes and regulations at all times.
- All work shall be performed by craftsmen who are journeymen of the trade in which they are performing work.
- Contractor superintendent shall report to the COTR each morning before work begins, at which the daily schedule shall be discussed.
- Contractor shall maintain dust control at all times. Contractor shall use "sticky mat" outside each work area and shall erect barriers to minimize dust/dirt, spreading/tracking to the greatest extent possible.
- All damages incurred to adjacent areas shall be repaired and restored to original condition by the contractor at no additional cost to the government.
- All materials removed shall become property of the contractor, to be disposed off site unless scheduled to be reinstalled or turned over to the VA.
- Contractor superintendent shall carry a pager and/or install a job site telephone. Turn-in numbers to the project COTR upon contract award.
- Contractor shall schedule all utility interruptions with the project COTR at least forty-eight (48) hours in advance. Utility interruptions may require overtime work for all trades involved, and shall be provided by the contractor at no additional cost to the government.
- "Not Work" permits are required. Notify the COTR twenty-four (24) hours prior to commencement of work.
- Manufacturers' trade names and numbers used herein identify a minimum standard. Subject to approval of the Contracting Officer, other products may be considered, provided they are equivalent to these standards and meet the requirements of the technical specifications and drawings.

BUILDING IS FULLY SPRINKLERED

Revisions Date: _____		Seal: 		RM ENGINEERS Reece, Noland & McElrath, Inc. 409 North Haywood Street / PO Box 540 Waynesville, North Carolina 28786 WAYSVILLE 828-424-4821 FAX 828-424-4200 MAIL@RMENGINEERS.COM © 2006 WWW.RMENGINEERS.COM		batson architects Greenville Commons 220 N. Main Street, Suite 403 Greenville, South Carolina 29601 864.233.2232		POWER PLANT QUAD 'D' QUAD 'A' QUAD 'C' QUAD 'B' KEY PLAN		BID DOCUMENTS Drawing Title: CONTROL DIAGRAMS BUILDING 14 - BASE BID & DEDUCT ALTERNATE #1 Approved By: _____ Note: Asbestos Containing Building Materials (ACBM) are present. Thermal Systems Insulation (TSI) and Miscellaneous ACBM are present in various locations.		ARCHITECT PROJECT NO. 2007-30 Project Title: VA MEDICAL CENTER REPLACE HVAC CONTROLS Building Number: 47 Location: ASHEVILLE, N.C.		Date: 03-13-08 Project No.: 637-08-103 Drawing No.: M122 Dwg. 29 of 29		Office of Facilities Department of Veterans Affairs	
---------------------------------	--	------------------	--	---	--	--	--	---	--	---	--	---	--	--	--	---	--

A

C

E

F

B